




DETAIL PART NO.6

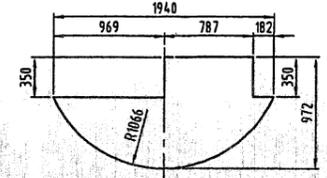


DETAIL PART NO.5

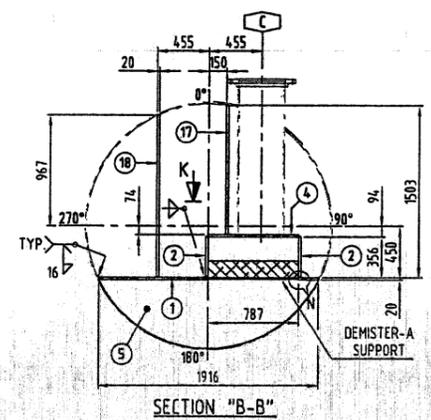





SECTION "B-B"

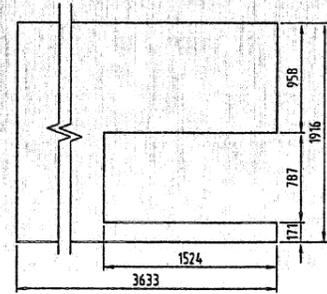


DETAIL PART NO.1

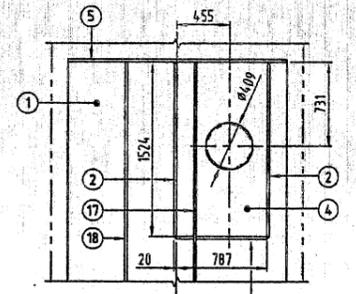


VIEW-"K"

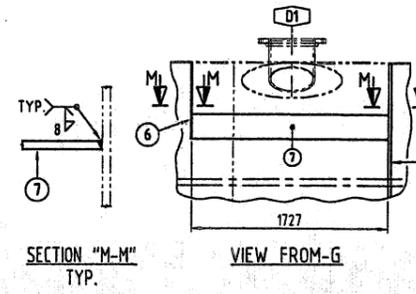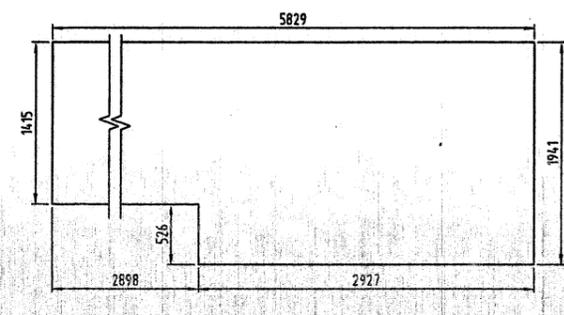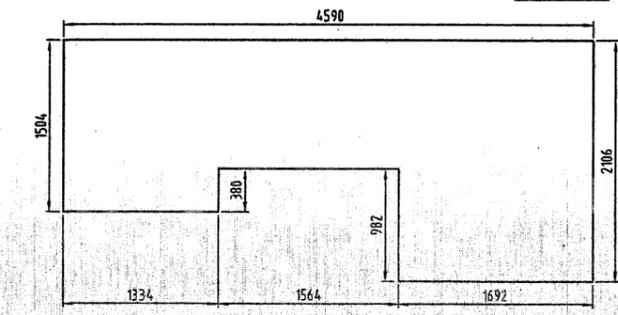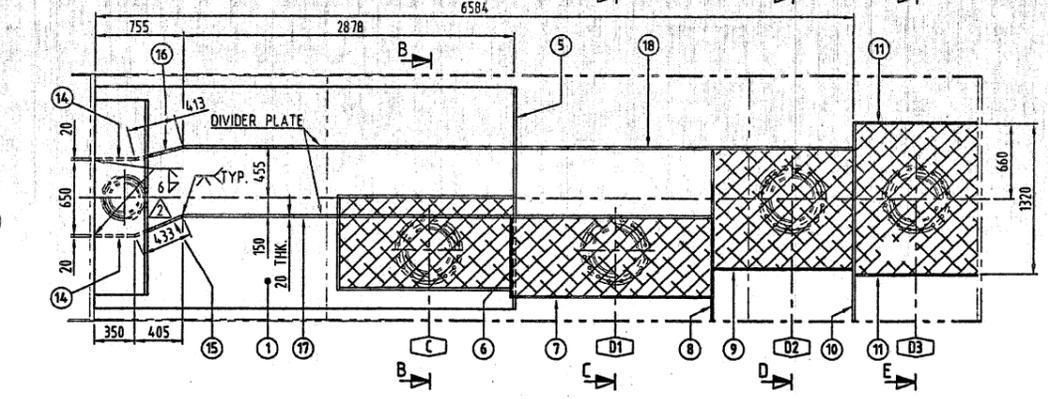


SECTION "M-M" TYP.

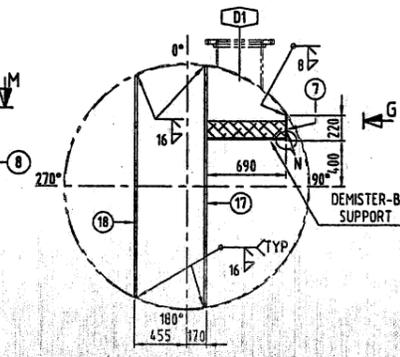


VIEW FROM-G

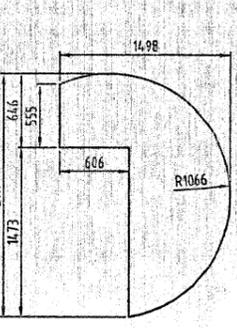


DETAIL PART NO.16

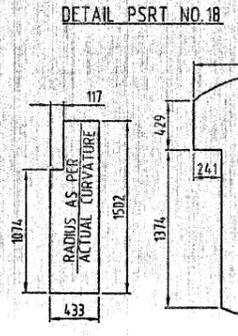


DETAIL PART NO.15

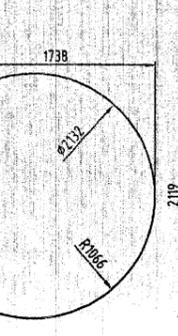


DETAIL PART NO.10

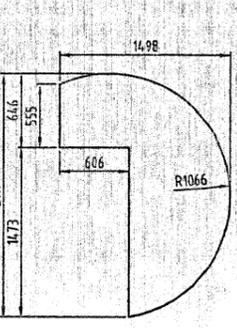

DETAIL PART NO.8

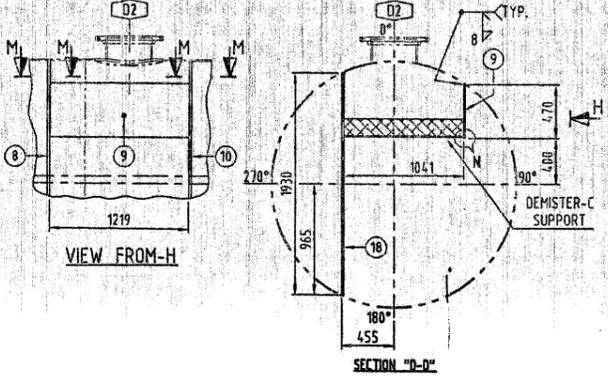


SECTION "D-D"

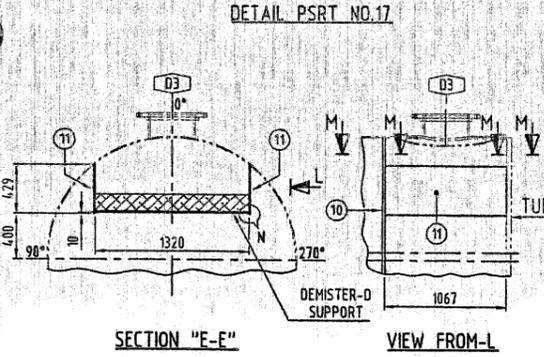

SECTION "E-E"

VIEW FROM-L

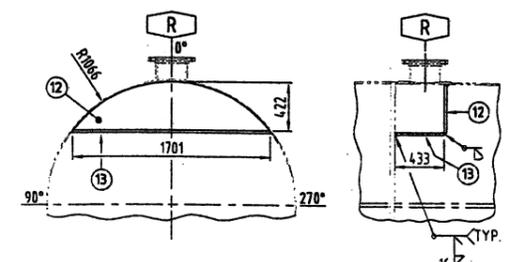

DETAIL NOZZLE-R

REFERENCE DRAWINGS		
NO	TITLE/DESCRIPTION	DRAWING NO.
01	G.A OF SULFUR CONDENSER (E-1902)	1029-09-04-GA-015

AS BUILT

ISSUED FOR	
1	Preliminary Study
2	Your Re/Record
3	3rd Party Approval
4	Client Approval
5	Fab./Cast.
6	60nt./Erection
7	Re/ing./Erection/Mod.
8	Inspection/Testing
9	
10	

Issued 6/2.1.8.0.0.4.9
Date 06-OCT-2009

ITEM NO.	DESCRIPTION	QTY	UNIT	WT. (KG)	REMARKS
1	Sheet Plate - 20 mm THK ; SA-516-Gr-70 ; Normalized ;	1	1	1036.00	SEE DETAIL
2	Sheet Plate - 20 mm THK ; SA-516-Gr-70 ; Normalized ;	1	1	1036.00	SEE DETAIL
3	Sheet Plate - 22 mm THK ; SA-516-Gr-70 ; Normalized ;	1	1	122.00	SEE DETAIL
4	Sheet Plate - 22 mm THK ; SA-516-Gr-70 ; Normalized ;	1	1	122.00	SEE DETAIL
5	Sheet Plate - 20 mm THK ; SA-516-Gr-70 ; Normalized ;	2	2	110.00	SEE DETAIL
6	Sheet Plate - 20 mm THK ; SA-516-Gr-70 ; Normalized ;	2	2	110.00	SEE DETAIL
7	Sheet Plate - 20 mm THK ; SA-516-Gr-70 ; Normalized ;	1	1	103.57	SEE DETAIL
8	Sheet Plate - 20 mm THK ; SA-516-Gr-70 ; Normalized ;	1	1	103.57	SEE DETAIL
9	Sheet Plate - 12 mm THK ; SA-516-Gr-70 ;	2	2	80.24	SEE DETAIL
10	Sheet Plate - 20 mm THK ; SA-516-Gr-70 ; Normalized ;	1	1	103.57	SEE DETAIL
11	Sheet Plate - 12 mm THK ; SA-516-Gr-70 ;	2	2	80.24	SEE DETAIL
12	Sheet Plate - 20 mm THK ; SA-516-Gr-70 ; Normalized ;	1	1	103.57	SEE DETAIL
13	Sheet Plate - 20 mm THK ; SA-516-Gr-70 ; Normalized ;	1	1	103.57	SEE DETAIL
PROJECT:							
SULFUR RECOVERY UNIT FOR DAKHNI EXPANSION PROJECT							
TITLE:							
REAR CHANNEL DIVIDER PLATES DETAIL FOR (E-1902)							
DRAWING NUMBER:							
1029-09-04-DR-015							
MATERIAL LIST							
REV. NO.	DESCRIPTION	DATE	DRAWN	CHKD	APPD	CHKD	APPD
2	AS BUILT AS MARKED	06-10-09	SHB NAQVI	SN	SN		
1	GENERAL REVISION	23-06-09	SHB NAQVI	SN	SN		
0	ISSUED FOR FABRICATION	15-04-09	SHB NAQVI	SN	ARS		

OIL AND GAS DEVELOPMENT COMPANY LIMITED
OGDCL HOUSE, 1st FLOOR, JINNAH AVENUE ISLAMABAD
Telephone: +92 51 297683-85 Fax: +92 51 297686

DESCON ENGINEERING LIMITED
P.O. BOX 1201, LAHORE-53000 PAKISTAN
TEL: +92-42-5805134, UAN: 111-DESCON
FAX: +92-42-5811005/5811135

PRESSON DESCON INTERNATIONAL PRIVATE LIMITED
18 - KM, FEROPUR ROAD,
LAHORE - 54700, PAKISTAN.
VOICE: +92 42 5923710-16
WEB: www.pdil.com

CLIENT REFERENCE
PRO-F/EB/OKM/EXP-1882/2007
DESCON PROJECT NO.
6218
PDIL PROJECT NO.
1029