


DEMISTER-"A" SUPPORT ASSY.
PLAN VIEW


DETAIL PART NO. 1

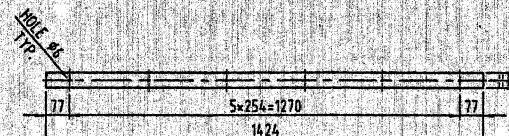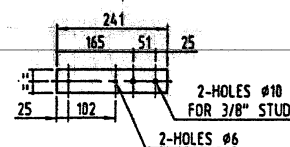

DETAIL PART NO. 2


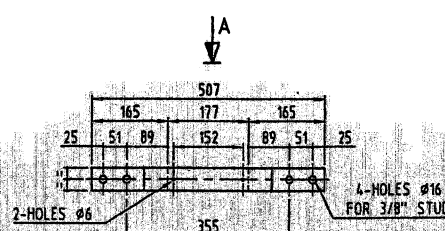


DETAIL PART NO. 3 & 4

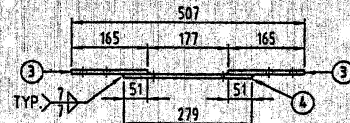


VIEW-"A"


DEMISTER-"A" SUPPORT DETAIL

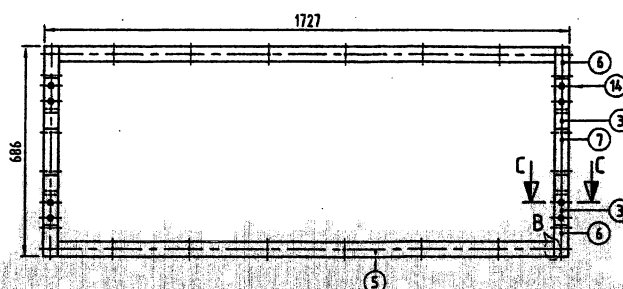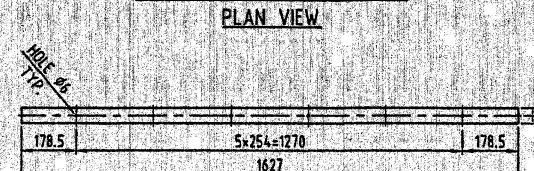DEMISTER-"B" SUPPORT ASSY.
PLAN VIEW


DETAIL PART NO. 5

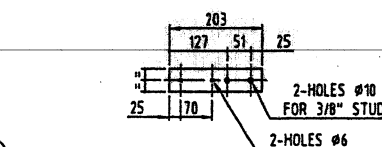

DETAIL PART NO. 6


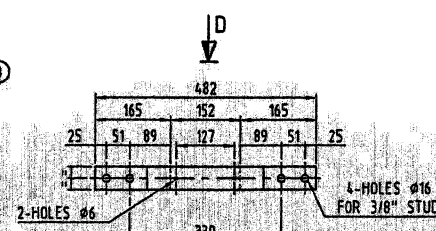


DETAIL PART NO. 3 & 7

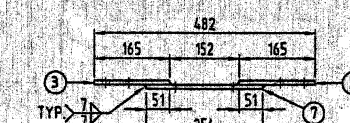


VIEW-"D"


DEMISTER-"B" SUPPORT DETAIL

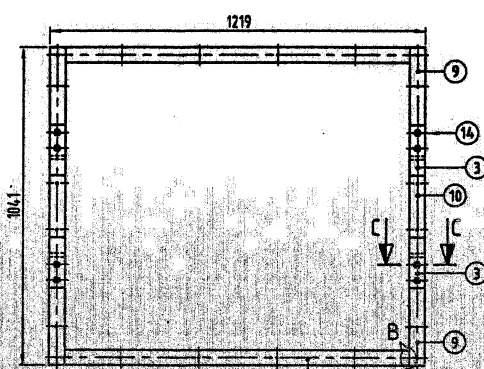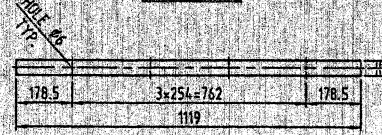DEMISTER-"C" SUPPORT ASSY.
PLAN VIEW


DETAIL PART NO. 8

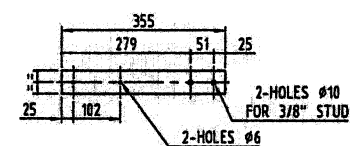

DETAIL PART NO. 9


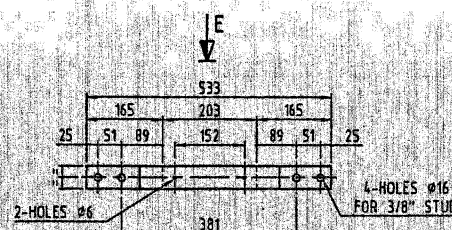


DETAIL PART NO. 3 & 10

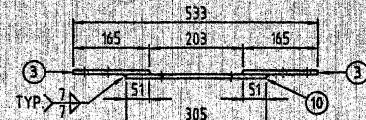


VIEW-"E"


DEMISTER-"C" SUPPORT DETAIL

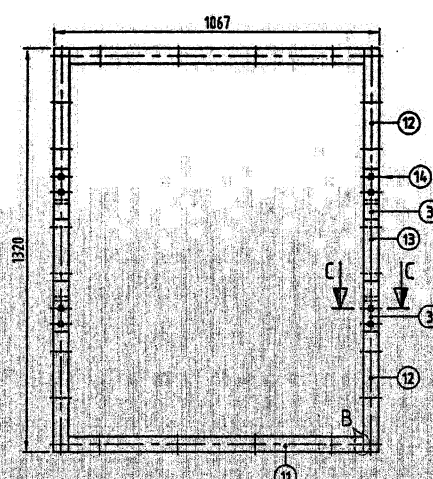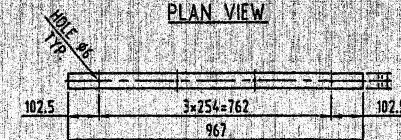DEMISTER-"D" SUPPORT ASSY.
PLAN VIEW


DETAIL PART NO. 11

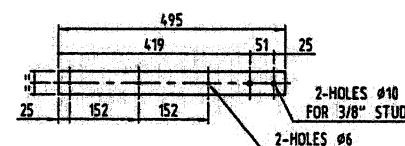

DETAIL PART NO. 12

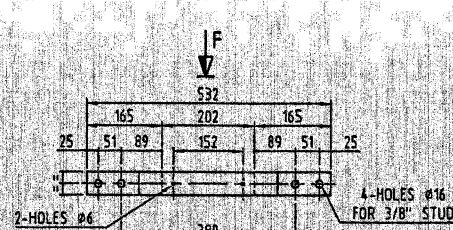


DETAIL PART NO. 3 & 13

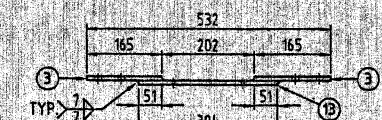


VIEW-"F"

DEMISTER-"D" SUPPORT DETAIL

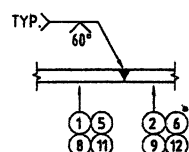

TYP. DETAIL-"B"

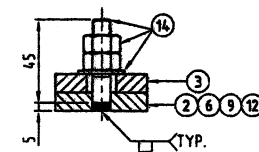

TYP. SECTION "C-C"

REV. NO.	DESCRIPTION	DATE	DRAWN	CHKD	APPD	CHKD	VPPD
1	AS BUILT AS MARKED	06-10-09	SHB NAQVI	SN	SN		
0	ISSUED FOR FABRICATION	15-04-09	SHB NAQVI	SN	ARS		
				CHKD	APPD	CHKD	VPPD
				DESCON		PDL	



OIL AND GAS DEVELOPMENT COMPANY LIMITED
OGDCL HOUSE, 1st FLOOR, JINNAH AVENUE ISLAMABAD
Telephone: +92 51 297683-85 Fax: +92 51 297686



DESCON ENGINEERING LIMITED
P.O. BOX 1201, LAHORE-53000 PAKISTAN
TEL: +92-42-5805134, UAN: 111-DESCON
FAX: +92-42-5811005/5811135



PRESSON DESCON INTERNATIONAL PRIVATE LIMITED
18 - KM, FEROPUR ROAD,
LAHORE - 54700, PAKISTAN.
VOICE: +92 42 5923710-16
WEB: www.pdil.com

CLIENT REFERENCE	DESCON PROJECT NO.	PDL PROJECT NO.
PRO-FC/CB/DKN/EXP-1882/2007	6218	1029

REFERENCE DRAWINGS		NO.	
TITLE/DESCRIPTION	DRAWING NO.		
81 G.A. OF SULFUR CONDENSER (E-1902)	1029-09-04-6A-015		

ISSUED FOR	
1 Preliminary Study	
2 Your Ref/Record	
3 3rd Party Approval	
4 Client Approval	
5 Fab./Cast.	
6 Bmt./Erection	
7 Bidding /Estimate cost	
8 Indenting/Procure	
9	
10	

Issued By 2-1-80049
Date 06 OCT 2009

ITEM NO.	DESCRIPTION	QTY	UNIT	PRICE	TOTAL
1	20" S.S. Tube with 12 ribs & weather 18 S.S.	45	L.F.	71	3195
2	1/2" S.S. Tube with 12 ribs & weather 18 S.S.	304	L.F.	1	304
3	1/2" S.S. Tube with 12 ribs & weather 18 S.S.	495	L.F.	1	495
4	1/2" S.S. Tube with 12 ribs & weather 18 S.S.	467	L.F.	2	934
5	1/2" S.S. Tube with 12 ribs & weather 18 S.S.	388	L.F.	2	776
6	1/2" S.S. Tube with 12 ribs & weather 18 S.S.	355	L.F.	4	1420
7	1/2" S.S. Tube with 12 ribs & weather 18 S.S.	254	L.F.	2	508
8	1/2" S.S. Tube with 12 ribs & weather 18 S.S.	289	L.F.	1	289
9	1/2" S.S. Tube with 12 ribs & weather 18 S.S.	1027	L.F.	2	2054
10	1/2" S.S. Tube with 12 ribs & weather 18 S.S.	279	L.F.	2	558
11	1/2" S.S. Tube with 12 ribs & weather 18 S.S.	254	L.F.	1	254
12	1/2" S.S. Tube with 12 ribs & weather 18 S.S.	241	L.F.	1	241
13	1/2" S.S. Tube with 12 ribs & weather 18 S.S.	1526	L.F.	2	3052

ITEM NO.	DESCRIPTION	QTY	UNIT	PRICE	TOTAL
1	20" S.S. Tube with 12 ribs & weather 18 S.S.	45	L.F.	71	3195
2	1/2" S.S. Tube with 12 ribs & weather 18 S.S.	304	L.F.	1	304
3	1/2" S.S. Tube with 12 ribs & weather 18 S.S.	495	L.F.	1	495
4	1/2" S.S. Tube with 12 ribs & weather 18 S.S.	467	L.F.	2	934
5	1/2" S.S. Tube with 12 ribs & weather 18 S.S.	388	L.F.	2	776
6	1/2" S.S. Tube with 12 ribs & weather 18 S.S.	355	L.F.	4	1420
7	1/2" S.S. Tube with 12 ribs & weather 18 S.S.	254	L.F.	2	508
8	1/2" S.S. Tube with 12 ribs & weather 18 S.S.	289	L.F.	1	289
9	1/2" S.S. Tube with 12 ribs & weather 18 S.S.	1027	L.F.	2	2054
10	1/2" S.S. Tube with 12 ribs & weather 18 S.S.	279	L.F.	2	558
11	1/2" S.S. Tube with 12 ribs & weather 18 S.S.	254	L.F.	1	254
12	1/2" S.S. Tube with 12 ribs & weather 18 S.S.	241	L.F.	1	241
13	1/2" S.S. Tube with 12 ribs & weather 18 S.S.	1526	L.F.	2	3052

PROJECT:	TITLE:	DRAWING NO.:
SULFUR RECOVERY UNIT FOR DAKHNI EXPANSION PROJECT	DEMISTER SUPPORT DETAIL FOR (E-1902)	1029-09-04-DR-015

PROJECT:	TITLE:	DRAWING NO.:
SULFUR RECOVERY UNIT FOR DAKHNI EXPANSION PROJECT	DEMISTER SUPPORT DETAIL FOR (E-1902)	1029-09-04-DR-015

PROJECT:	TITLE:	DRAWING NO.:
SULFUR RECOVERY UNIT FOR DAKHNI EXPANSION PROJECT	DEMISTER SUPPORT DETAIL FOR (E-1902)	1029-09-04-DR-015