


NOTES :

- 1. INLET MANIFOLDS HAVE BEEN PLACED AT TAY-3 LOCATION.
- 2. LINE SIZE IS PROVIDED BY PACKAGE SUPPLIER OF SEPARATORS.
- 3. MOBILE SCRAPER RECEIVER SHALL BE CONNECTED AT THIS VALVE.
- 4. INSTRUMENT VALVE MANIFOLD (BLOCK AND BLEED), PART OF INSTRUMENT VALVE ASSEMBLY.
- 5. REFER TO BELOW DETAIL FOR TYPICAL ARRANGEMENT OF PRESSURE INDICATOR.
- 6. SIGNAL FROM 31 TO 46 ARE TO BE TERMINATED & DISPLAYED AT RTU-2501.

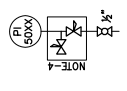

REV.	DESCRIPTION	DATE	BY	CHKD.	APPD.
1	AS BUILT				

OIL & GAS DEVELOPMENT COMPANY LTD.
Zishan Engineers (Pvt.) Ltd.
AN ISO 9001:2008 CERTIFIED COMPANY
P-00071, PAKISTAN & SAUDI ARABIA
P-00071, PAKISTAN & SAUDI ARABIA
P-00071, PAKISTAN & SAUDI ARABIA



DWG. NO. 165-4-PID-026
REV. F0

JOB NO. 165-4
SHEET 3 OF 3

PROJECT : KPD-TAY INTEGRATED DEVELOPMENT PROJECT
TITLE : GATHERING SYSTEM AT TAY-3

NOTES :

1. INLET MANIFOLDS HAVE BEEN PLACED AT GRP LOCATION.
2. MOBILE SCRAPER RECEIVER SHALL BE CONNECTED AT THIS VALVE.
3. INSTRUMENT VALVE MANFOLD (BLOCK AND BLEED), PART OF INSTRUMENT VALVE ASSEMBLY.
4. DETAIL FOR TYPICAL ARRANGEMENT FOR ALL PRESSURE INSTRUMENTS PI,PT,PSHH,PSLL,PSH,PSL.

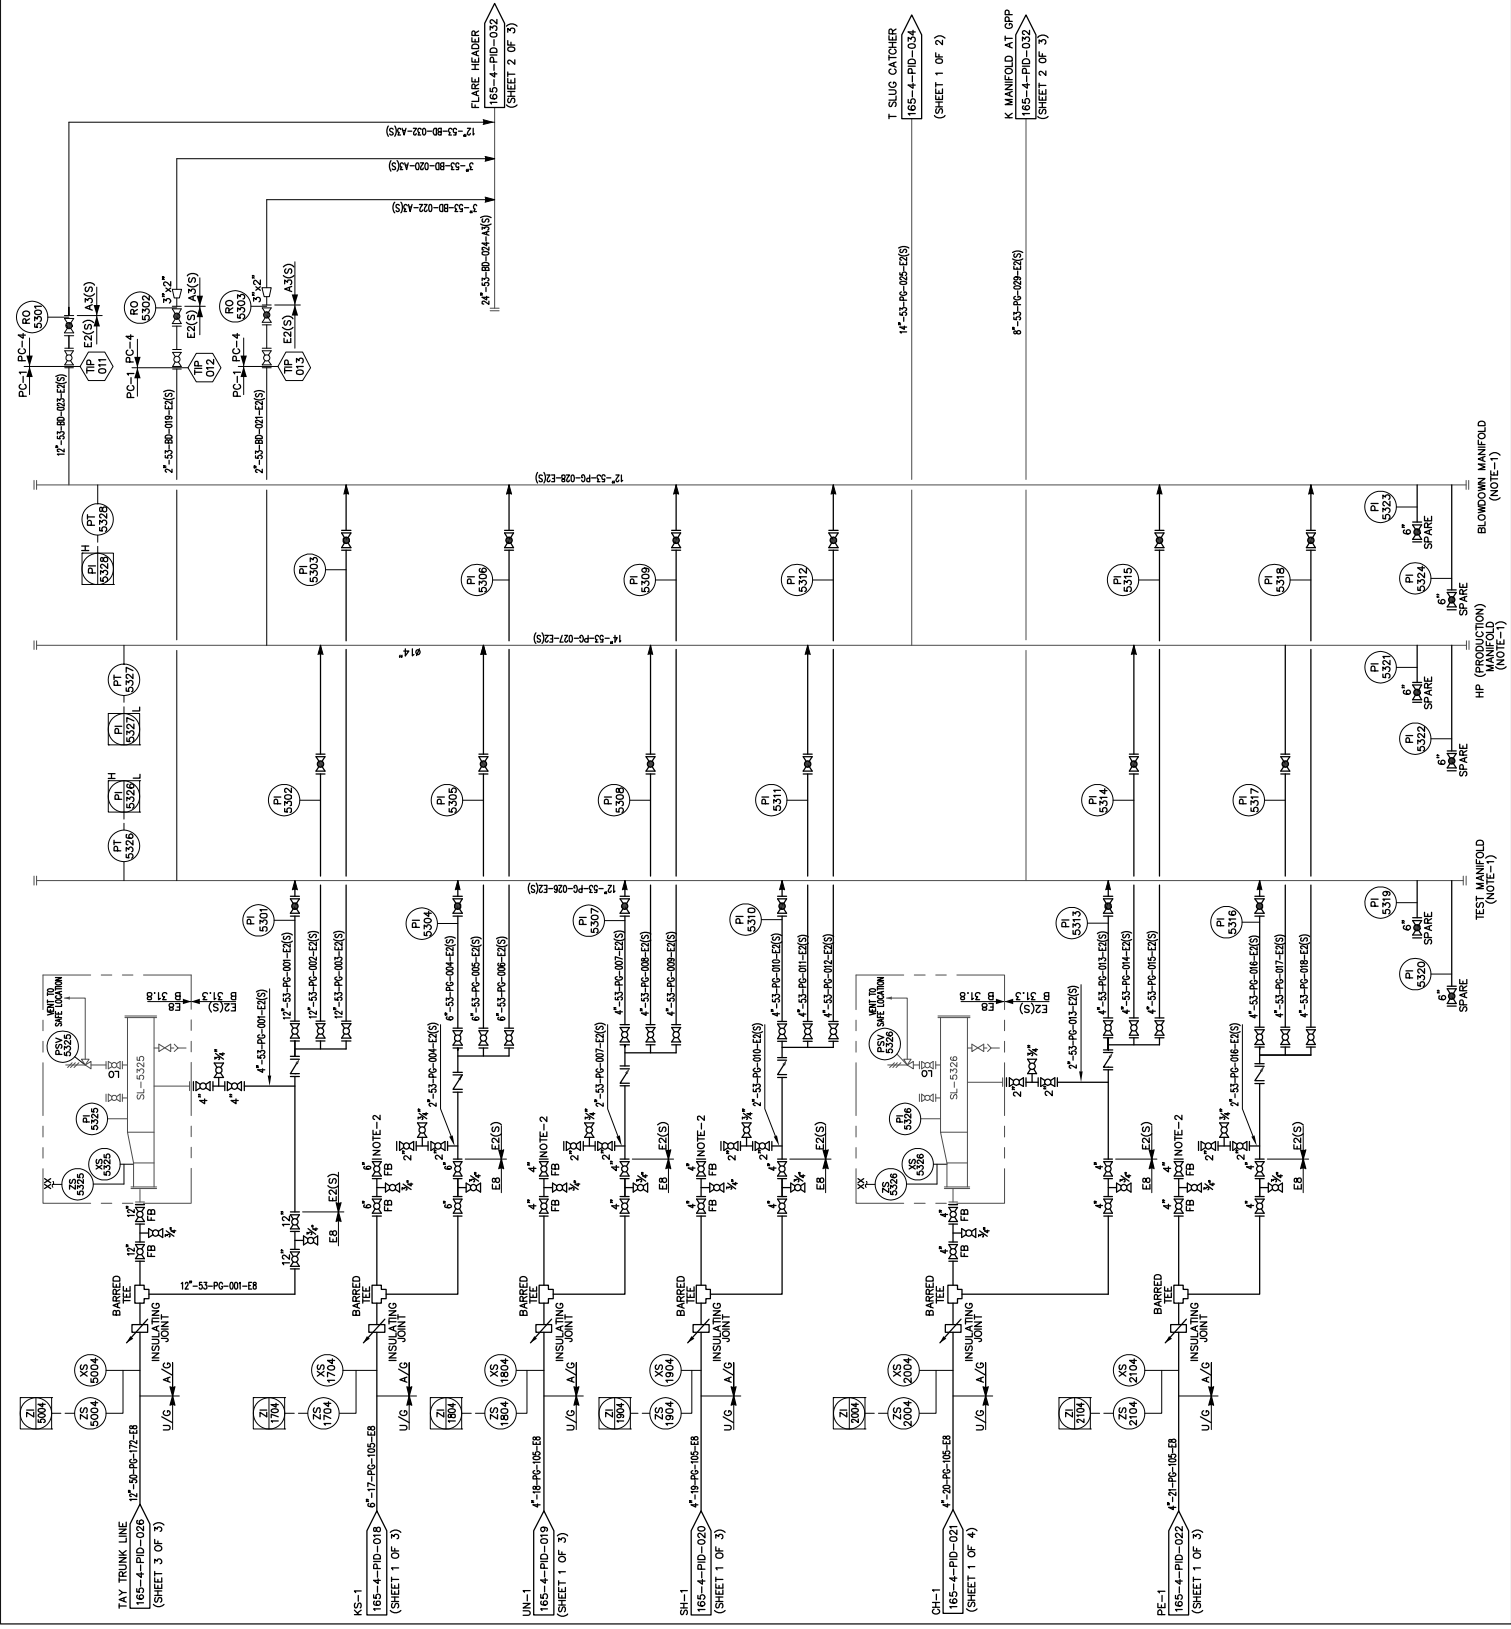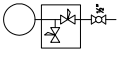

REV.	DATE	BY	CHKD.	APPD.
1	04/22/2017	AS	AS	AS
2	04/22/2017	AS	AS	AS
3	04/22/2017	AS	AS	AS
276				