


NOTES

1. XXX
2. DELETED.
3. DELETED.
4. ALL PIPE
5. DELETED.
6. DELETED.
7. DISTANCE FROM HEADER TO CONTROL VALVE
8. TEMPERATURE TRANSMITTER (TT), COMPRISES RTD ELEMENT, COMPLETE HEAD MOUNTED TRANSMITTER
9. INSTALLED CORROSION COUPON IN HORIZONTAL
10. DELETED.
11. JUST INSTALL THE NOZZLE WITH THE FLANGE
12. NEW ELECTRICAL SIGNALS SHALL BE PROVIDED EVERY WHERE
13. CORROSION INHIBITOR CONNECTION TO BE CAPPED SEAL

AS-BUILT

E-0101A	
SIZE	1000 MM
SECTION PRESS.	1000 PSIG
SECTION TEMP.	-20/300 F

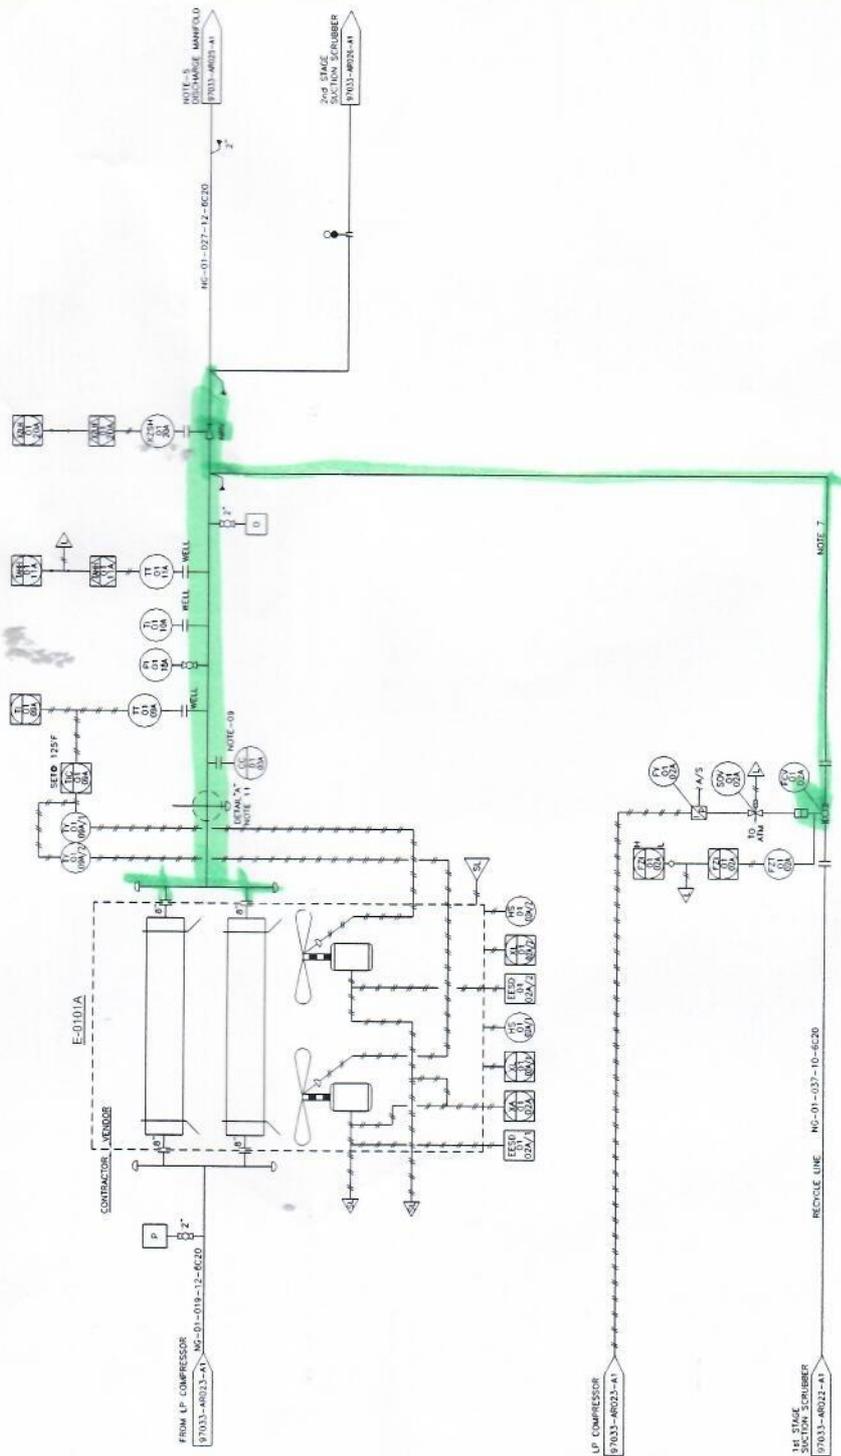


1	15-03-16	CLIENT COMMENT INCORPORATED	MK	RK	
0	23-12-15	AS-BUILT	MK	RK	
REV	DATE	DESCRIPTION	DRAWN	CHECK'D	APP'D
			CONSULTANT		
PC PETROCHEMICAL ENGINEERING CONSULTANTS C-2, 8000 NO. 17, DULHAMEL-LEIBAL, NEAR NATIONAL STADIUM, WAPDAHQ-75300, PAKISTAN TEL: +91 (0) 382796, 384988, FAX: +91 (0) 382981, E-MAIL: info@petrochemical.com.pk web: www.petrochemical.com					
CLIENT					
OIL & GAS DEVELOPMENT COMPANY LIMITED					
PROJECT					
AS-BUILT QADIRPUR GAS FIELD					
TITLE					
PIPING & INSTRUMENTATION DIAGRAM					
PRCP INTERCOOLER TRAIN "A"					
DRAWING NO.		SHEET	SCALE	REV.	
97033-AR024-A1		1	1	A3	1

NOTES

1. INDIVIDUAL VIBRATION ALARM TO BE CIRCLED & SENT TO THE COMPUTER.
2. DELETED.
3. DELETED.
4. DELETED.
5. DELETED.
6. ALL PIPE SIZES ARE IMPERIAL.
7. ALL INSTRUMENTATION TAGS ONE COUPON SHALL BE ON THE BOTTOM OF THE INSTRUMENTATION.
8. SPOOL PRICE LOW RECYCLE CONTROL VALVE.
9. LINE TO BE USED AS AN ANTISURGE RECYCLE DURING PHASE-2.
10. DELETED.
11. SPECTACLE PLATE TO BE OPEN WHEN SECOND CASING REQUIRED.
12. MINIMUM DISTANCE FROM HEADER TO CONTROL VALVE.
13. TEMPERATURE TRANSDUCER (TT) COMPRISES PTD ELEMENT, WELDED TO PROCESS VESSEL, AND REQUIRED TRANSMITTER.
14. DELETED.
15. JUST INSTALL THE INJECTION NOZZLE WITH THE FLANGE.

AS-BUILT

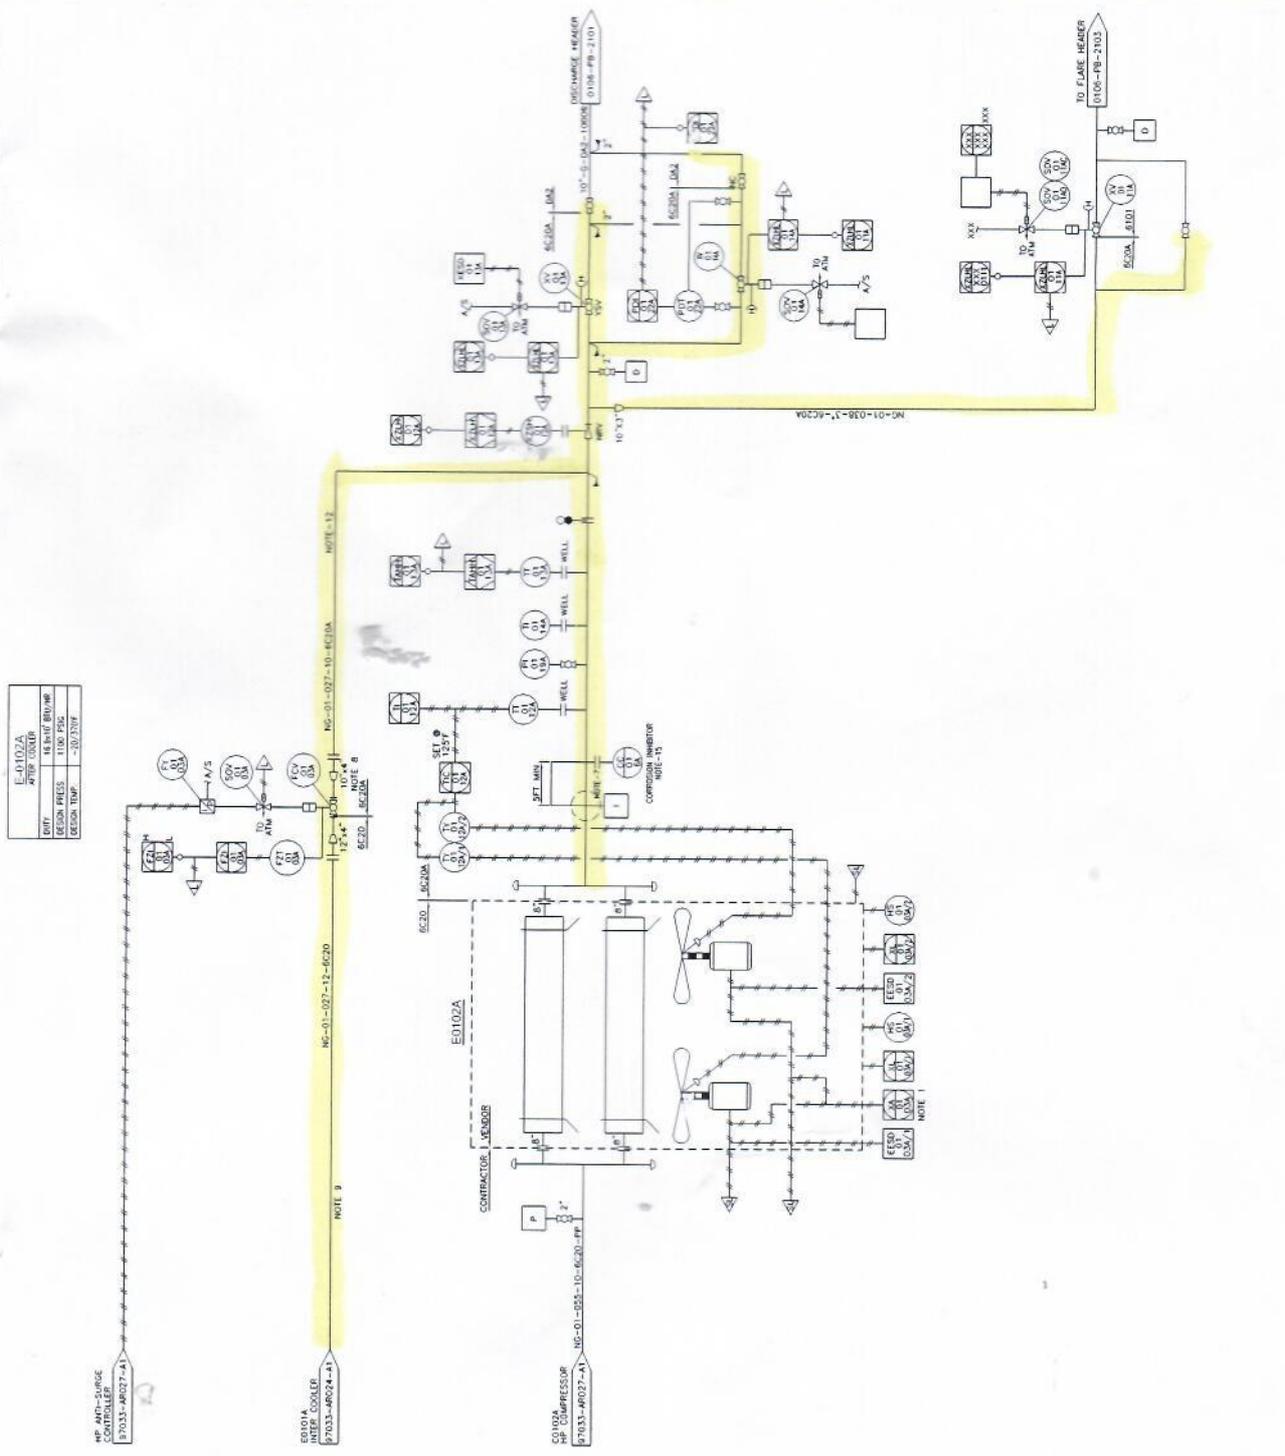

REV	DATE	DESCRIPTION	DRAWN	CHK'D	APP'VD
1	11-03-16	CLIENT COMMENT INCORPORATED	M.K	R.K	
0	23-12-15	AS-BUILT	M.K	R.K	

PG PETROCHEMICAL ENGINEERING CONSULTANTS C-1, BLOCK NO. 17, GULSHAN-I-QUWA, KARACHI NATIONAL CAPITAL DEVELOPMENT AUTHORITY, KARACHI-75270 TEL: +92 (0)11 4827781, 4827782, 4827783 FAX: +92 (0)11 4827784, 4827785 E-mail: petrochem@pg.com.pk web site: www.pg.com.pk	
CLIENT	OIL & GAS DEVELOPMENT COMPANY LIMITED
PROJECT	AS-BUILT QADIRPUR GAS FIELD
TITLE	PIPING & INSTRUMENTATION DIAGRAM PRCP AFTER COOLER TRAIN A
DRAWING NO.	97033-AR025-A1
SHEET	1
SCALE	A3
REV	1