


X:\165-000C\165-4 (KPD-TAY)\CIVIL\AS BUILT\165-4-CSTD-011_RFD.dwg Apr 26, 2018 - 5:52pm ZEL-COMP103

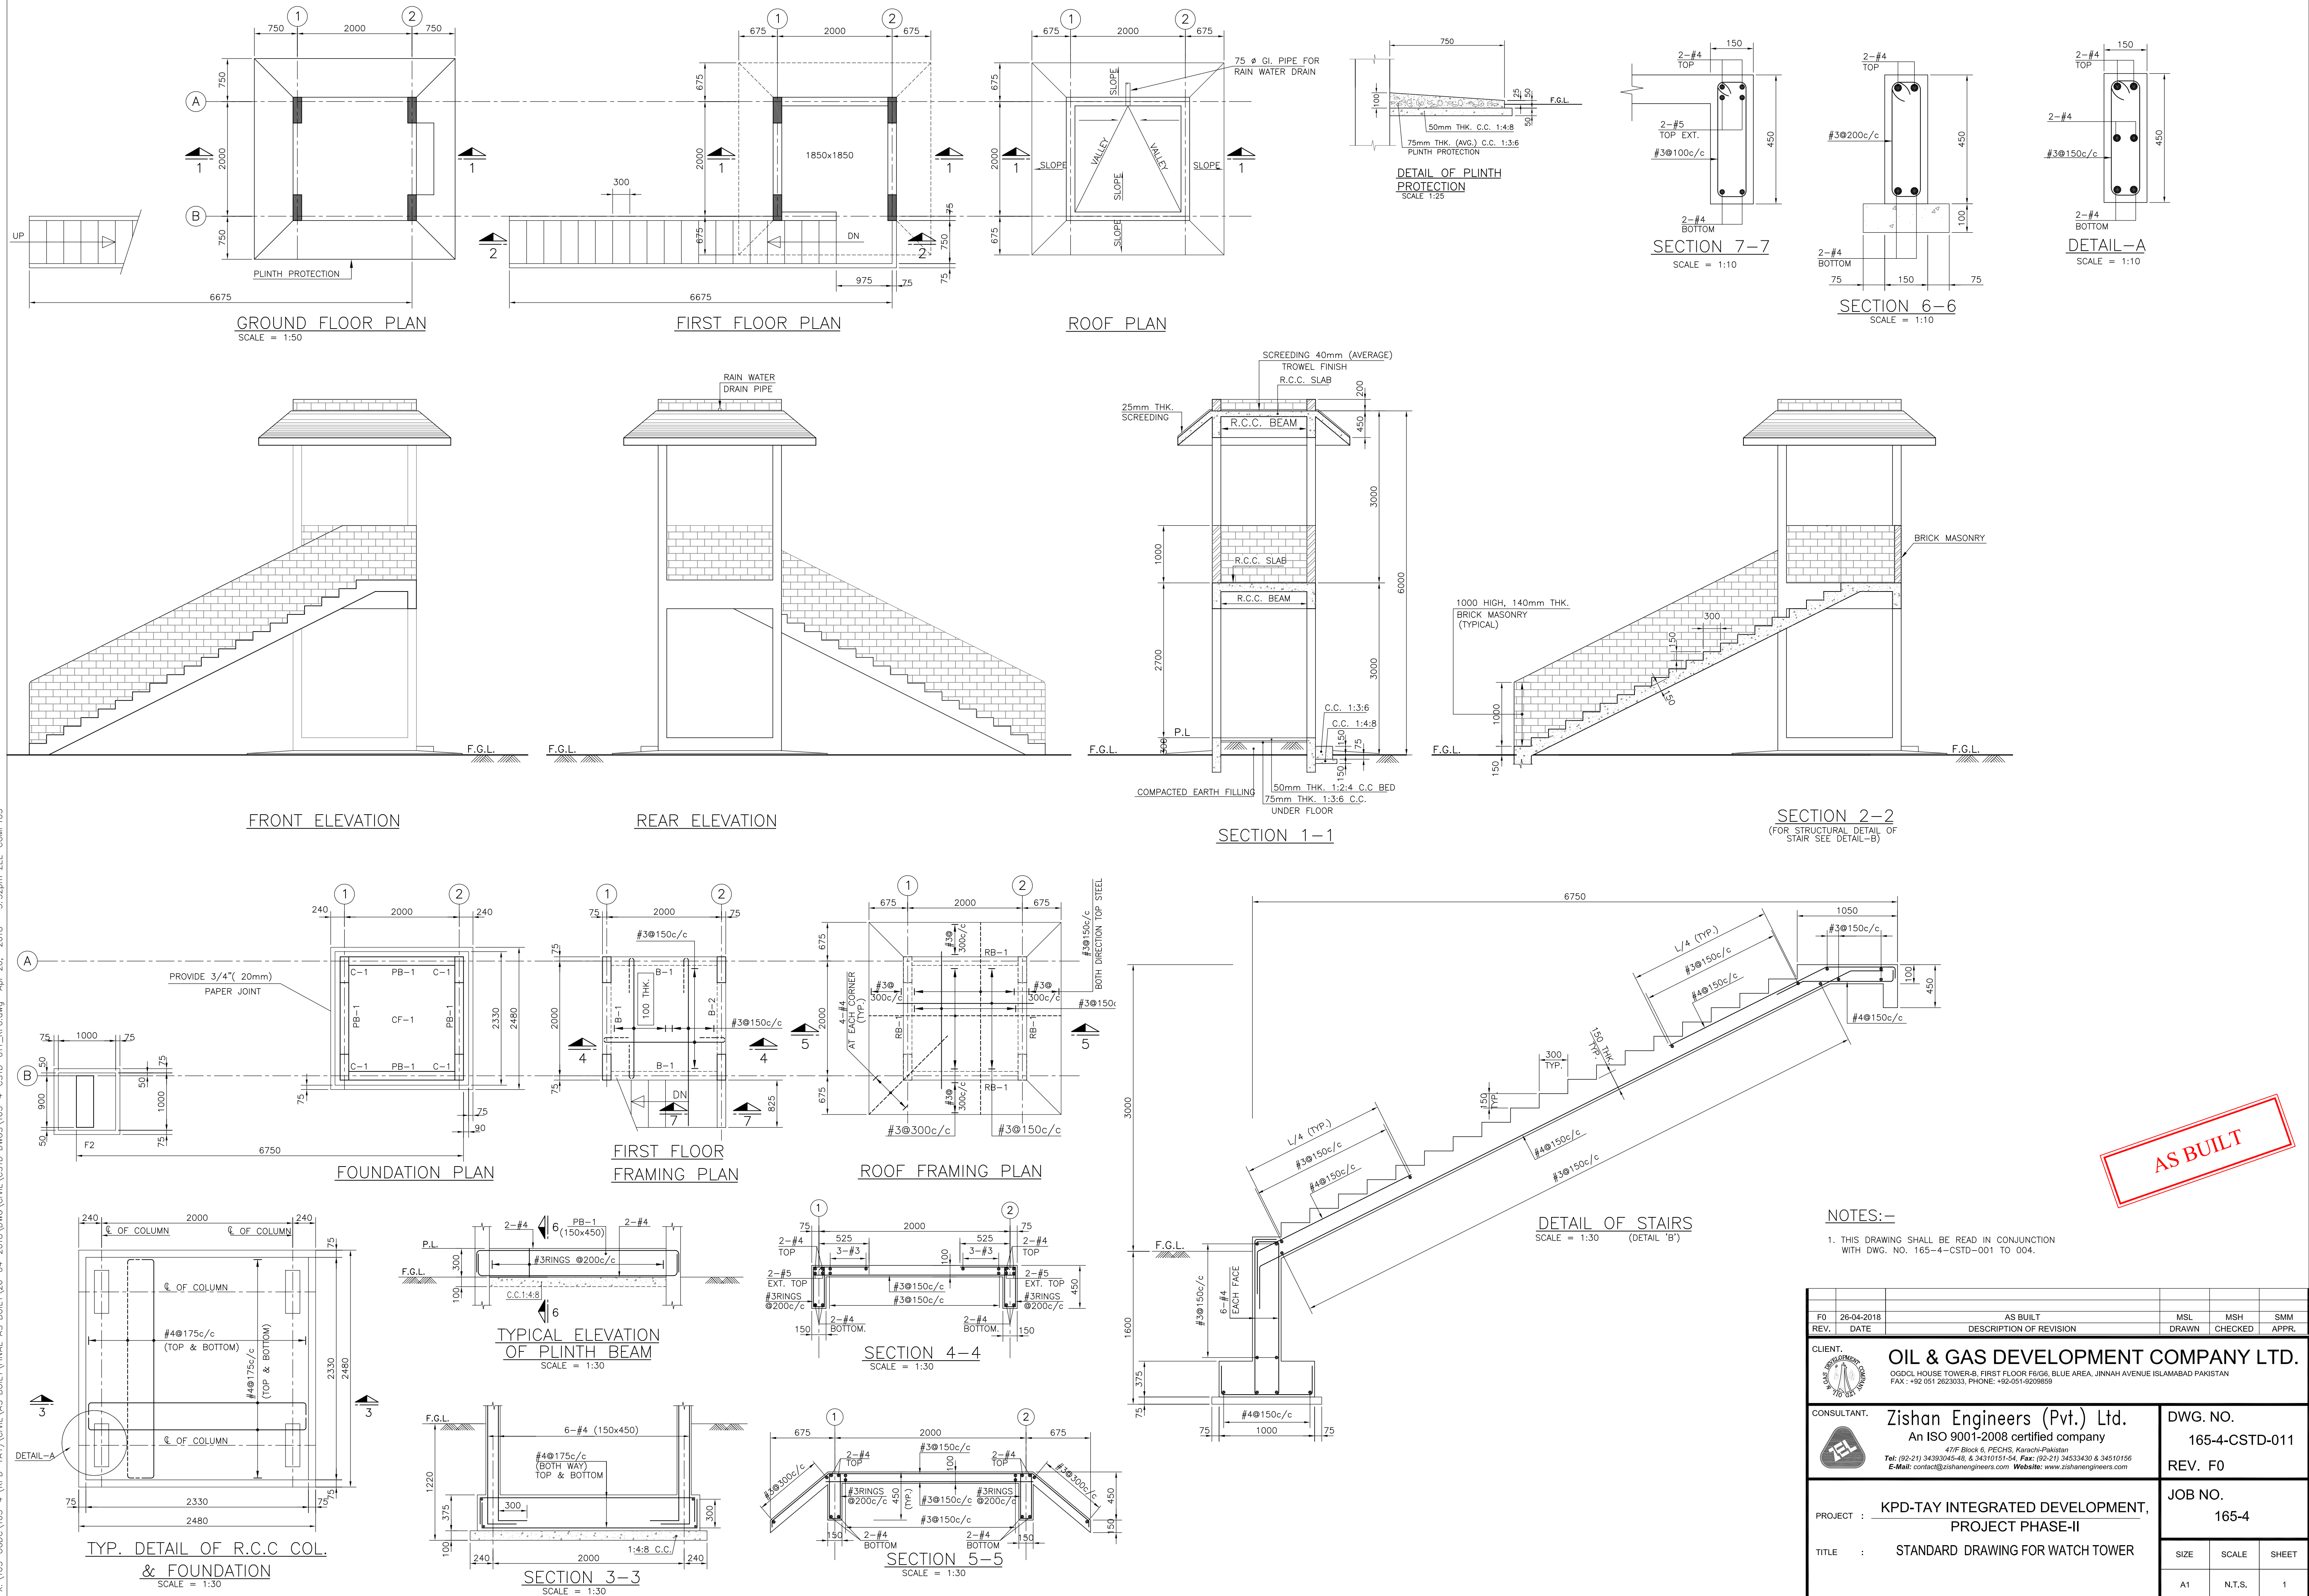

AS BUILT

NOTES:-
1. THIS DRAWING SHALL BE READ IN CONJUNCTION WITH DWG. NO. 165-4-CSTD-001 TO 004.

FO	26-04-2018	AS BUILT	MSL	MSH	SMM
REV.	DATE	DESCRIPTION OF REVISION	DRAWN	CHECKED	APPR.
CLIENT:					
OIL & GAS DEVELOPMENT COMPANY LTD.					
OGDCL HOUSE TOWER-B, FIRST FLOOR PB-6, BLUE AREA, JINNAH AVENUE ISLAMABAD PAKISTAN					
FAX: +92 051 2623033, PHONE: +92 051 9209859					
CONSULTANT:					
Zishan Engineers (Pvt.) Ltd.					
An ISO 9001-2008 certified company					
47/F Block 6, PECHS, Karachi-Pakistan					
Tel: (92-21) 3439045-46 & 34310161-54, Fax: (92-21) 34333430 & 34510156					
E-Mail: contact@zishanengineers.com Website: www.zishanengineers.com					
PROJECT :			JOB NO.		
KPD-TAY INTEGRATED DEVELOPMENT, PROJECT PHASE-II			165-4		
TITLE :			JOB NO.		
STANDARD DRAWING FOR WATCH TOWER			165-4		
SIZE			SCALE		
A1			N.T.S.		
SHEET			1		