




STEEL OPENABLE VENTILATOR

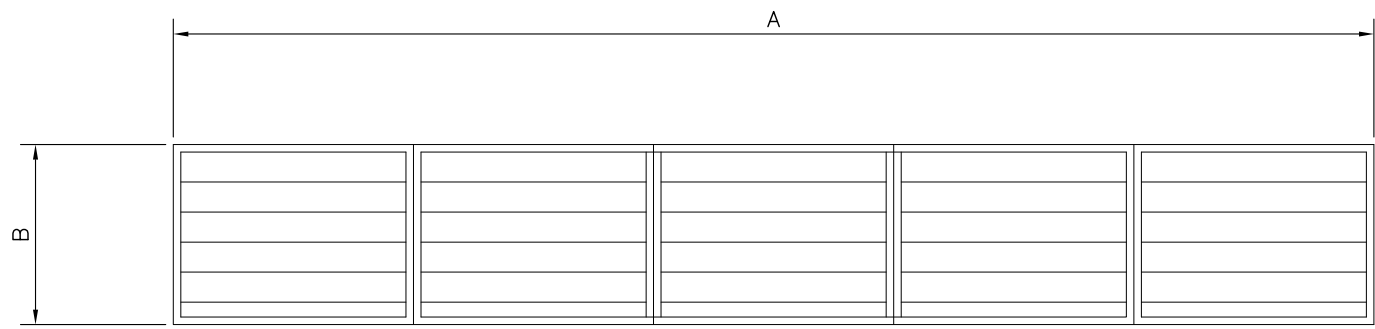


STEEL LOUVERED VENTILATOR

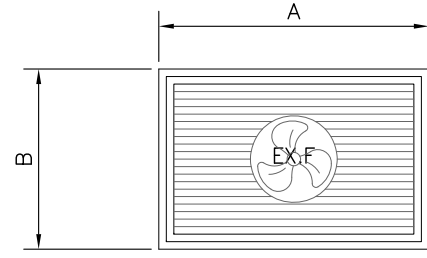


STEEL LOUVERED VENTILATOR
WITH / WITHOUT EXHAUST FAN

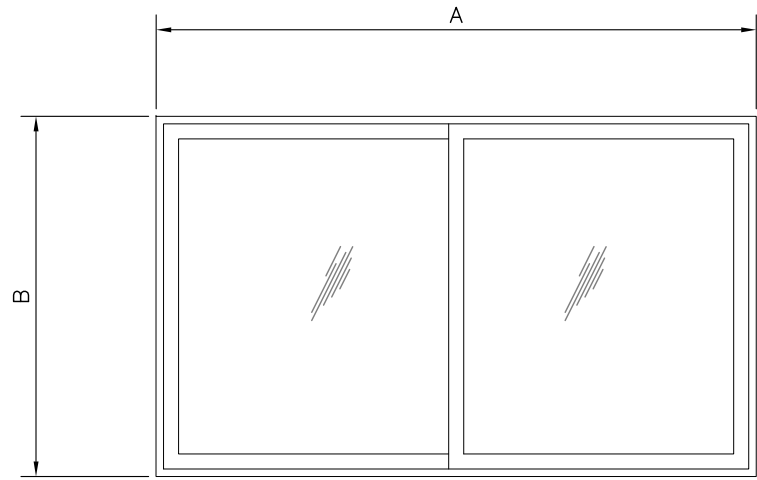


DOUBLE LEAF DOUBLE SLIDE ALUMINIUM WINDOW
WITH 5mm THK. SAFETY GLASS

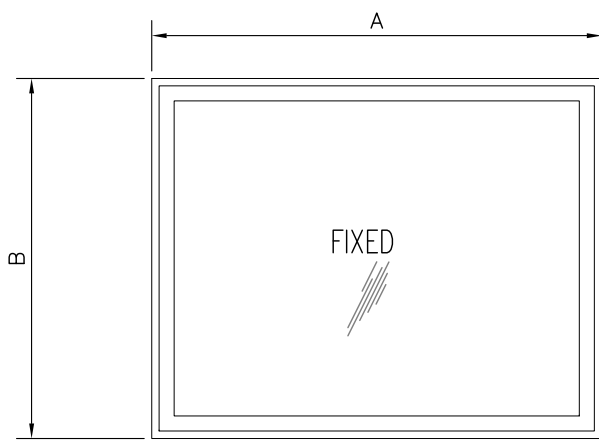

FIX GLASS ALUMINIUM WINDOW
WITH 5mm THK. SAFETY GLASS

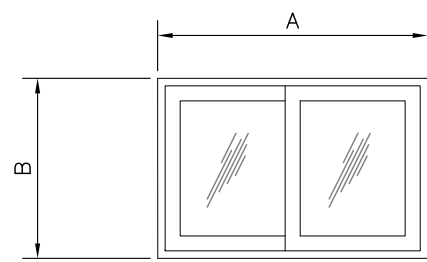

DOUBLE LEAF SINGLE SLIDE ALUMINIUM VENTILATOR
WITH 5mm THK. SAFETY GLASS

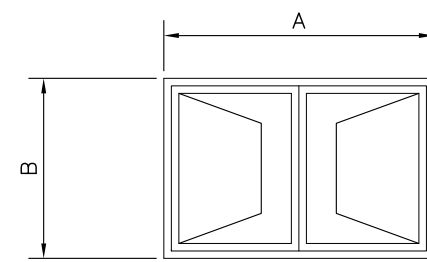



STEEL OPENABLE VENTILATOR

AS BUILT

NOTES:

1. THIS DRAWING SHALL BE READ IN CONJUNCTION
WITH DWG. NO. 165-4-CSTD-001 & 004.

F0	26-04-2018	AS BUILT	MSL	MSH	SMM
REV.	DATE	DESCRIPTION OF REVISION	DRAWN	CHECKED	APPR.
CLIENT:  OIL & GAS DEVELOPMENT COMPANY LTD. OGDCL HOUSE TOWER-B, FIRST FLOOR PB/66, BLUE AREA, JINNAH AVENUE ISLAMABAD PAKISTAN FAX: +92 051 2623033, PHONE: +92 051 9209650					
CONSULTANT:  Zishan Engineers (Pvt.) Ltd. An ISO 9001-2008 certified company 47/F Block 6, PECHS, Karachi-Pakistan Tel: (92-21) 34393045-46 & 34310161-64, Fax: (92-21) 34533430 & 34510156 E-Mail: contact@zishanengineers.com Website: www.zishanengineers.com			DWG. NO. 165-4-CSTD-010 REV. F0		
PROJECT : KPD-TAY INTEGRATED DEVELOPMENT, PROJECT PHASE-II			JOB NO. 165-4		
TITLE : STANDARD DRAWING FOR WINDOWS/VENTILATOR GLAZING DETAIL			SIZE A1	SCALE N.T.S.	SHEET 1