




X:\165-OGDC\165-4 (KPD-TAY)\CIVIL\AS BUILT\165-4-PB-012-RFO.dwg Apr 24, 2018 -- 12:53pm ZEL-COMP32

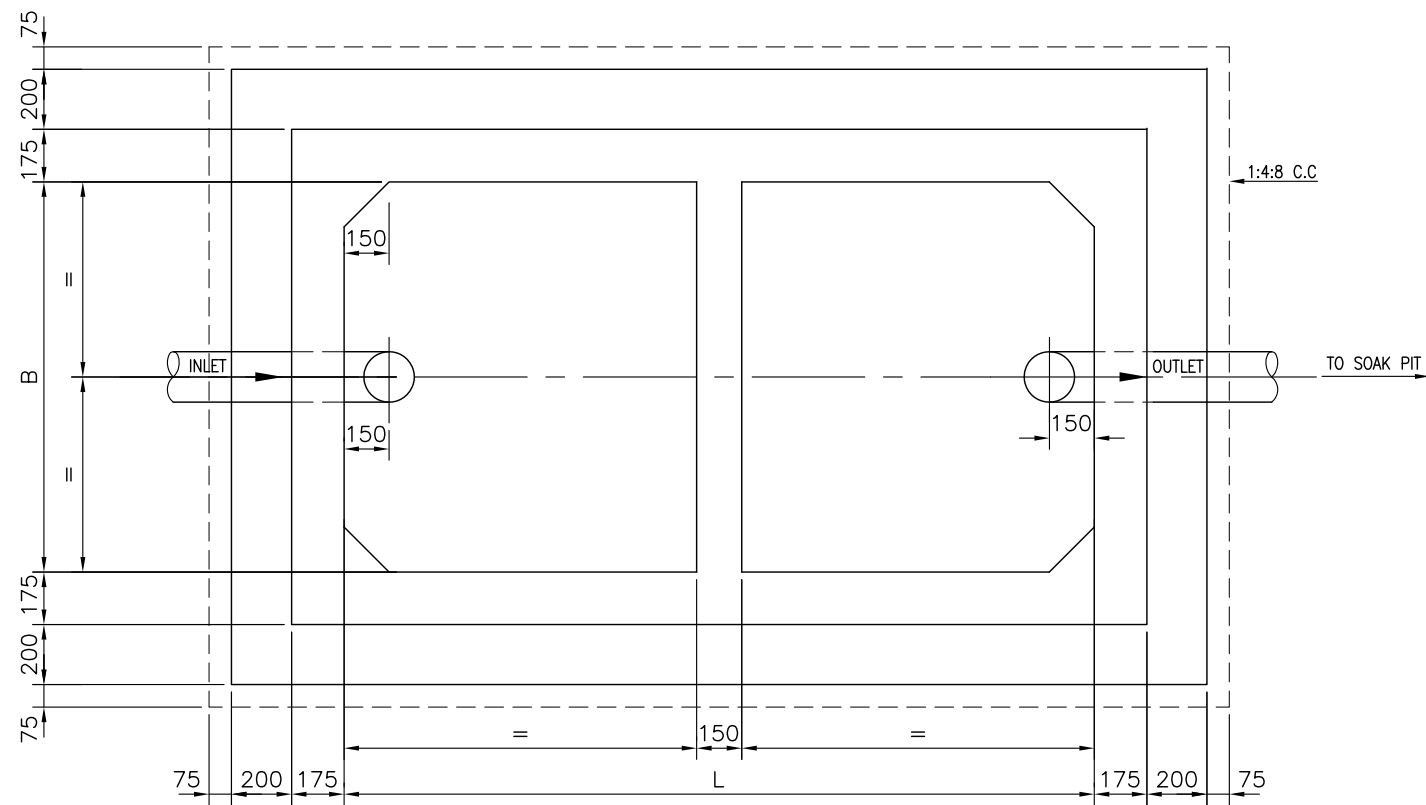


PLAN OF SEPTIC TANK (FOR DIMENSION)  
SCALE = 1 : 25

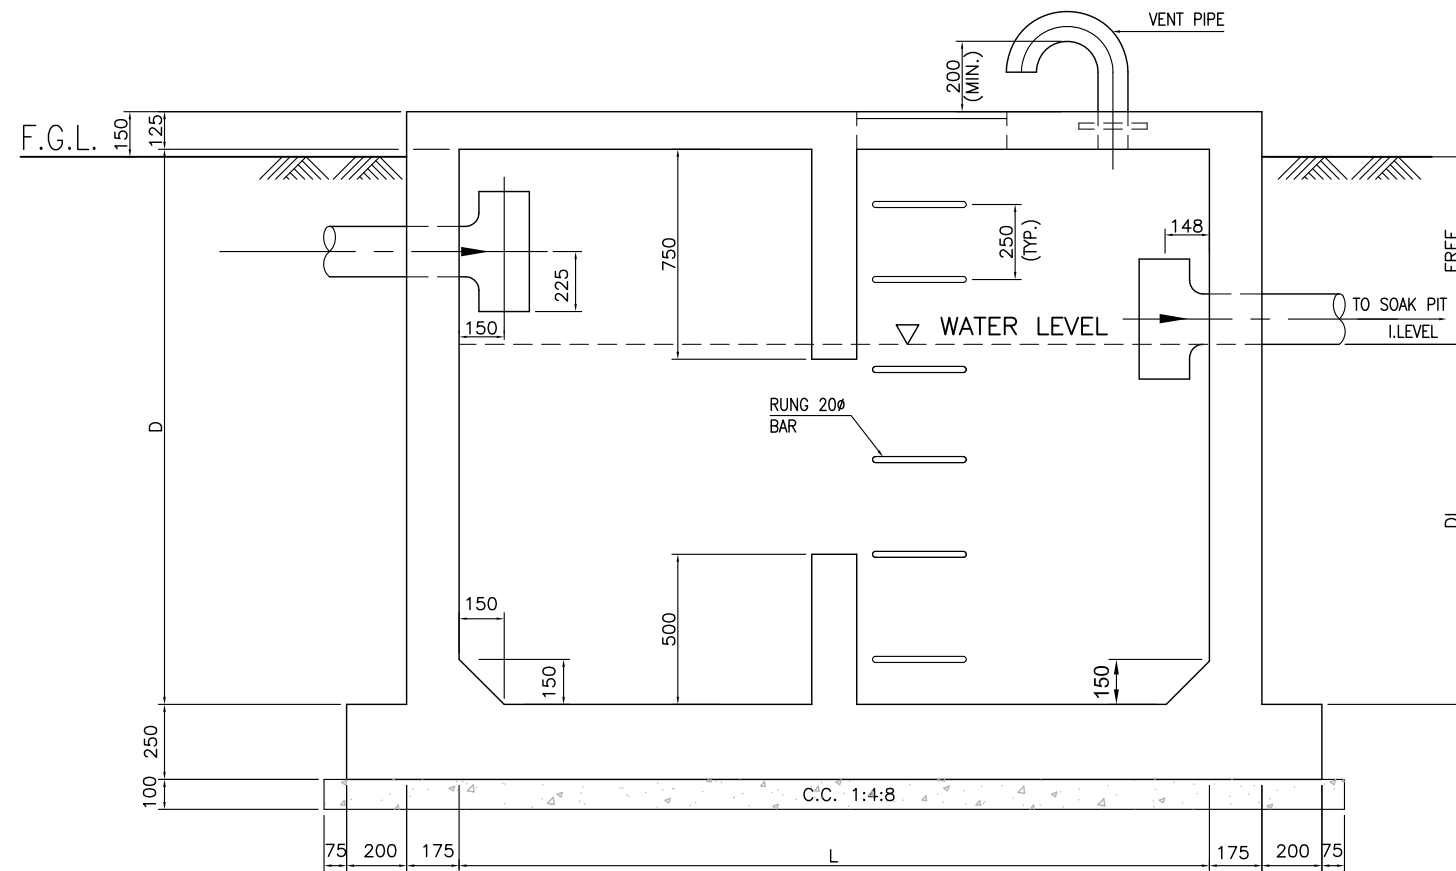


SECTION A-A (FOR DIMENSION)  
SCALE = 1 : 25

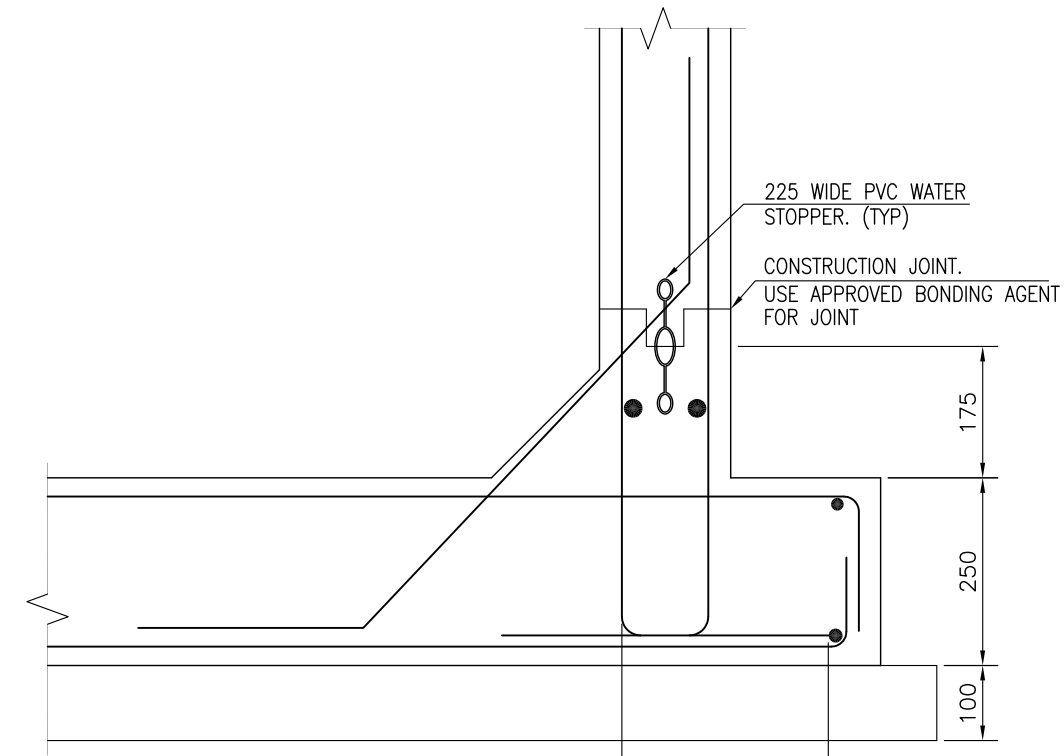

DETAIL-A  
SCALE = 1 : 10

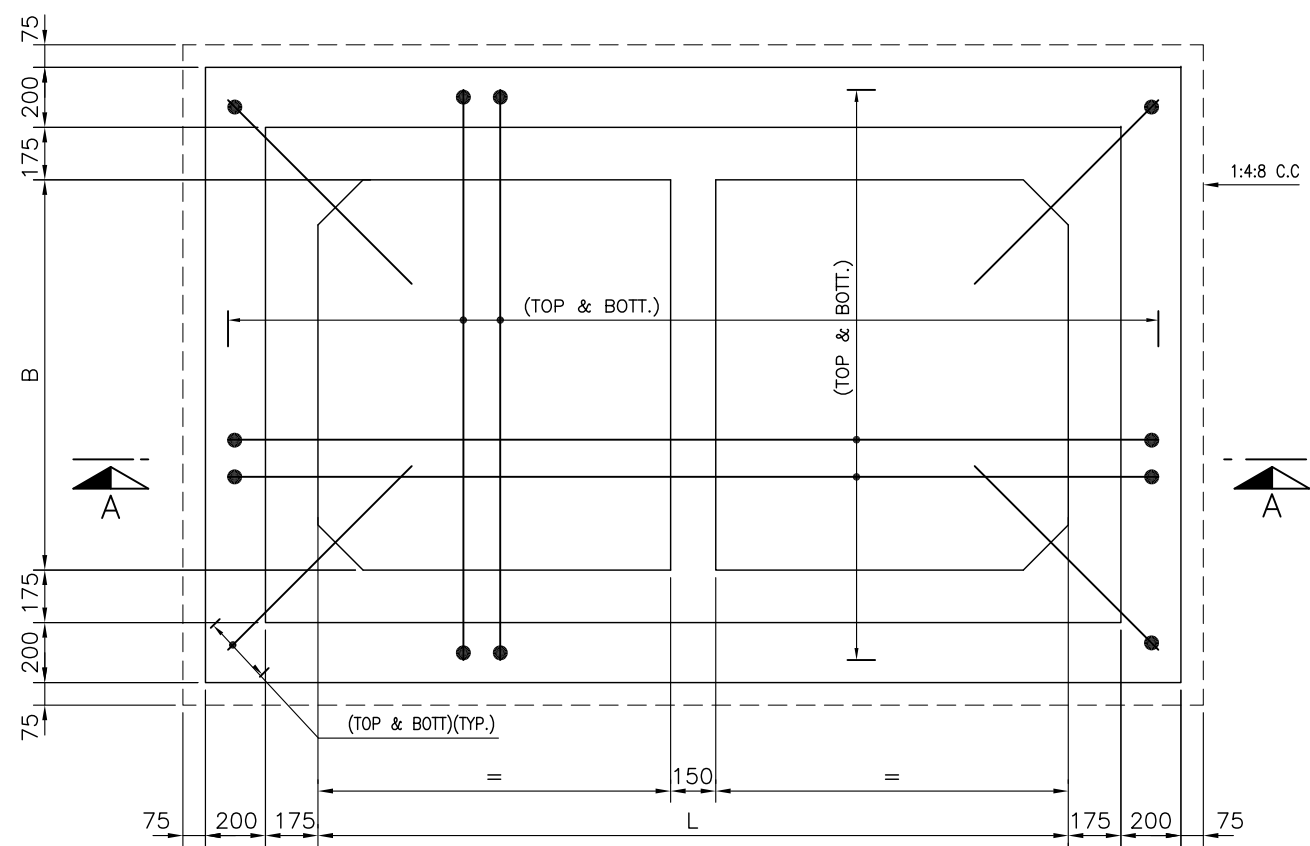


BOTTOM SLAB OF SEPTIC TANK (FOR REINFORCEMENT)  
SCALE = 1 : 25  
(ALL REINFORCEMENT AS PER DESIGN)

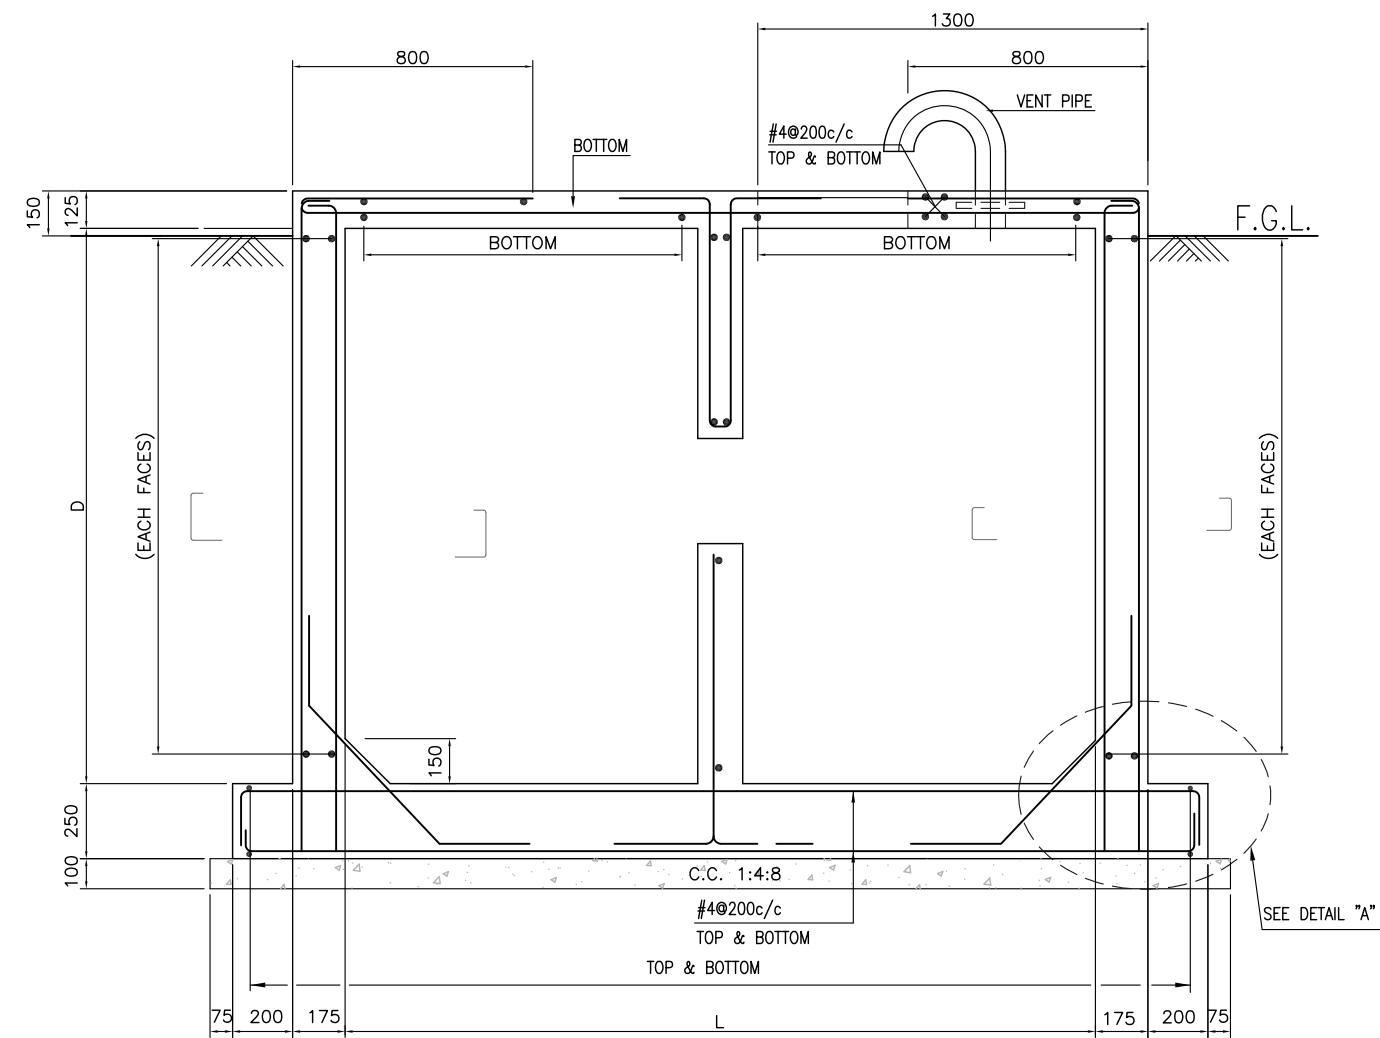


SECTION A-A (FOR REINFORCEMENT)  
SCALE = 1 : 25  
(ALL REINFORCEMENT AS PER DESIGN)

SCHEDULE OF SOAK PIT				
NUMBER OF PERSON (P)	DIA (M)	DIA 1 (M)	"C"	"D"
75	8.3	7.9	1	3.5
25	5.5	5.1	1	3.5


SEPTIC TANK					
NUMBER OF PERSON (P)	CAPACITY= {(180xP)+ 750}	L (M)	B (M)	DL (M)	FREE BOARD
75	14250	2.5	1.75	3.0	0.75
25	5250	2.0	1.75	2.0	0.75

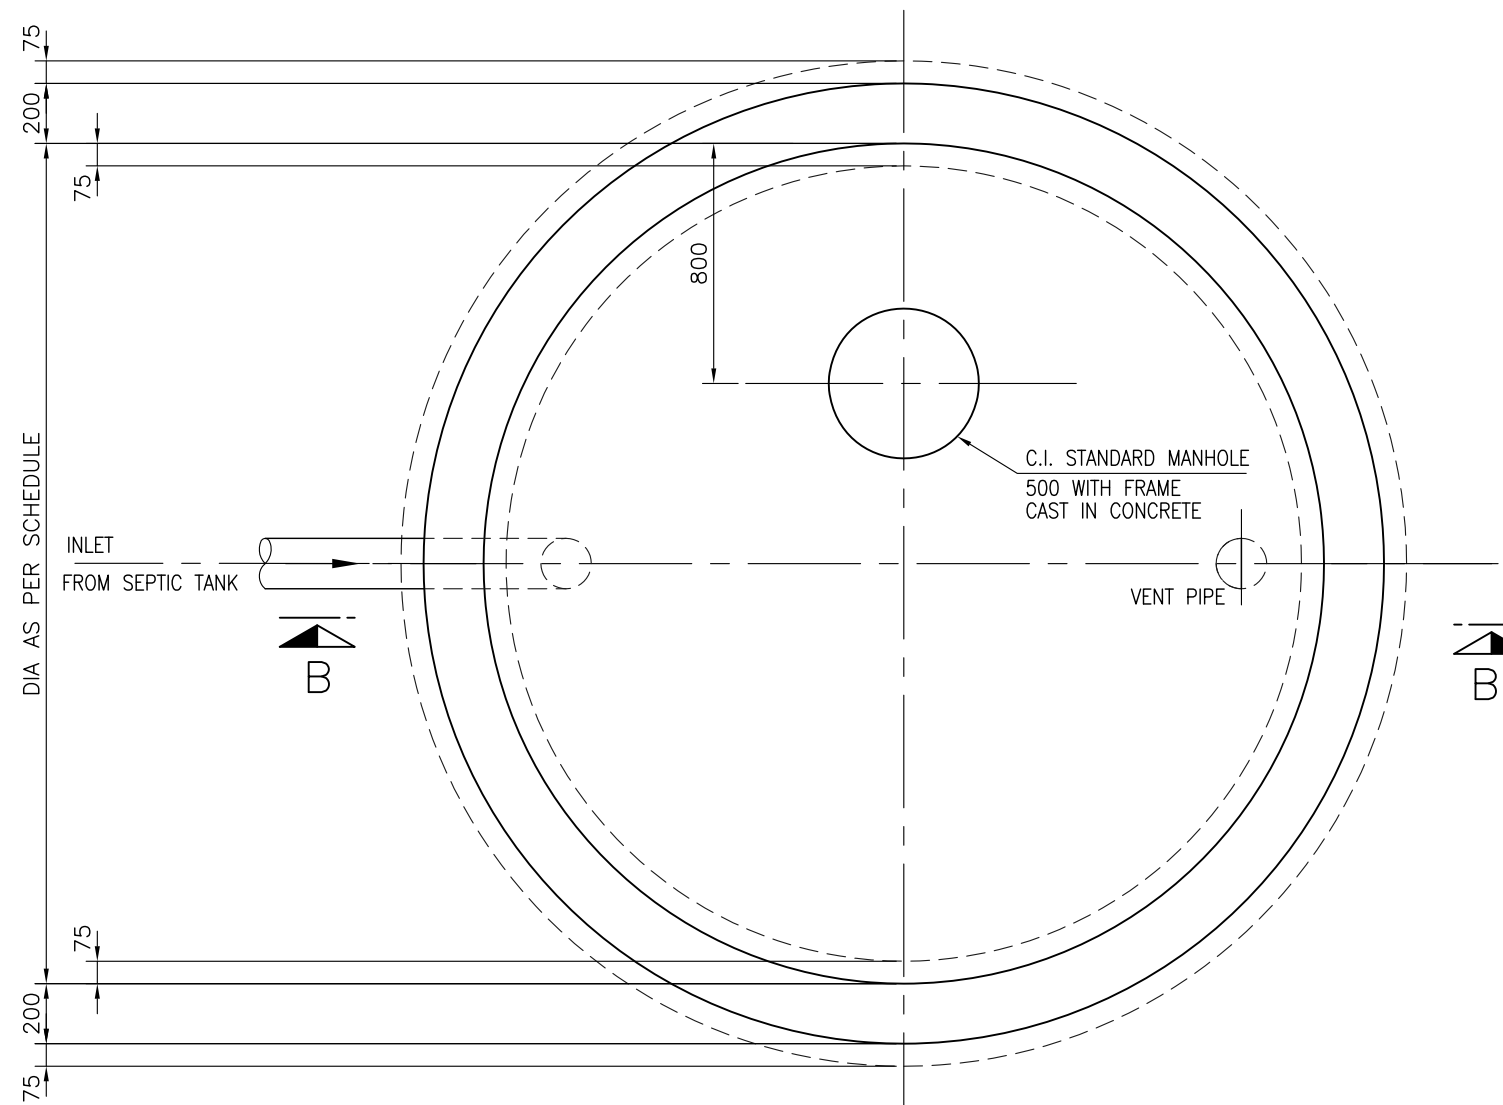

PLAN OF SOAK PIT  
SCALE 1:25

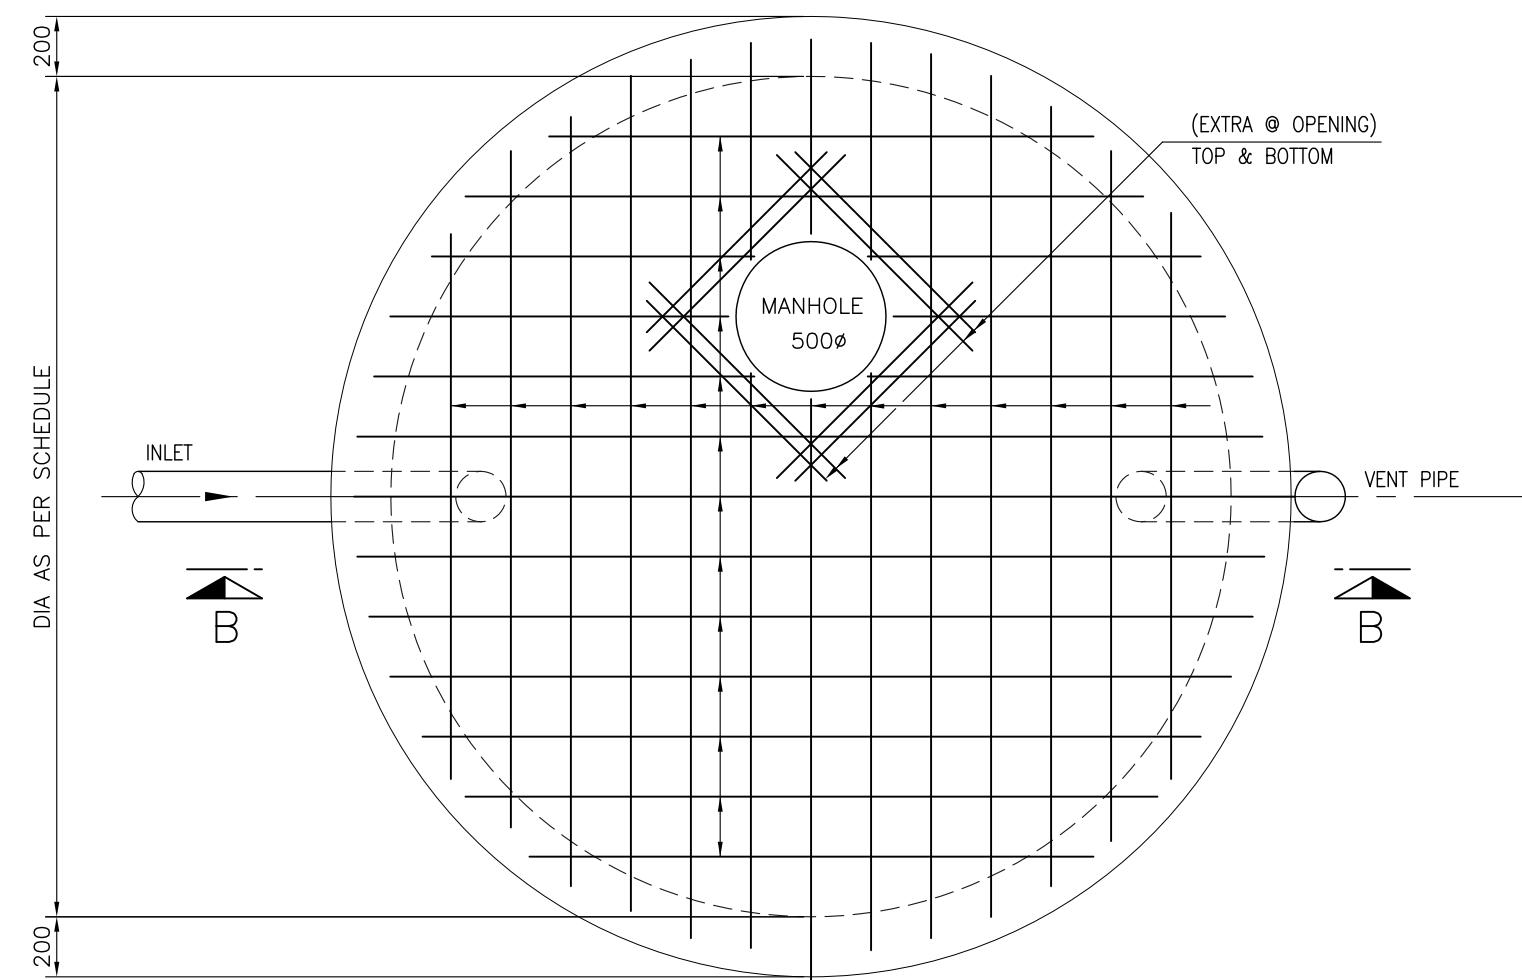

ROOF SLAB OF SOAK PIT  
SCALE 1:25

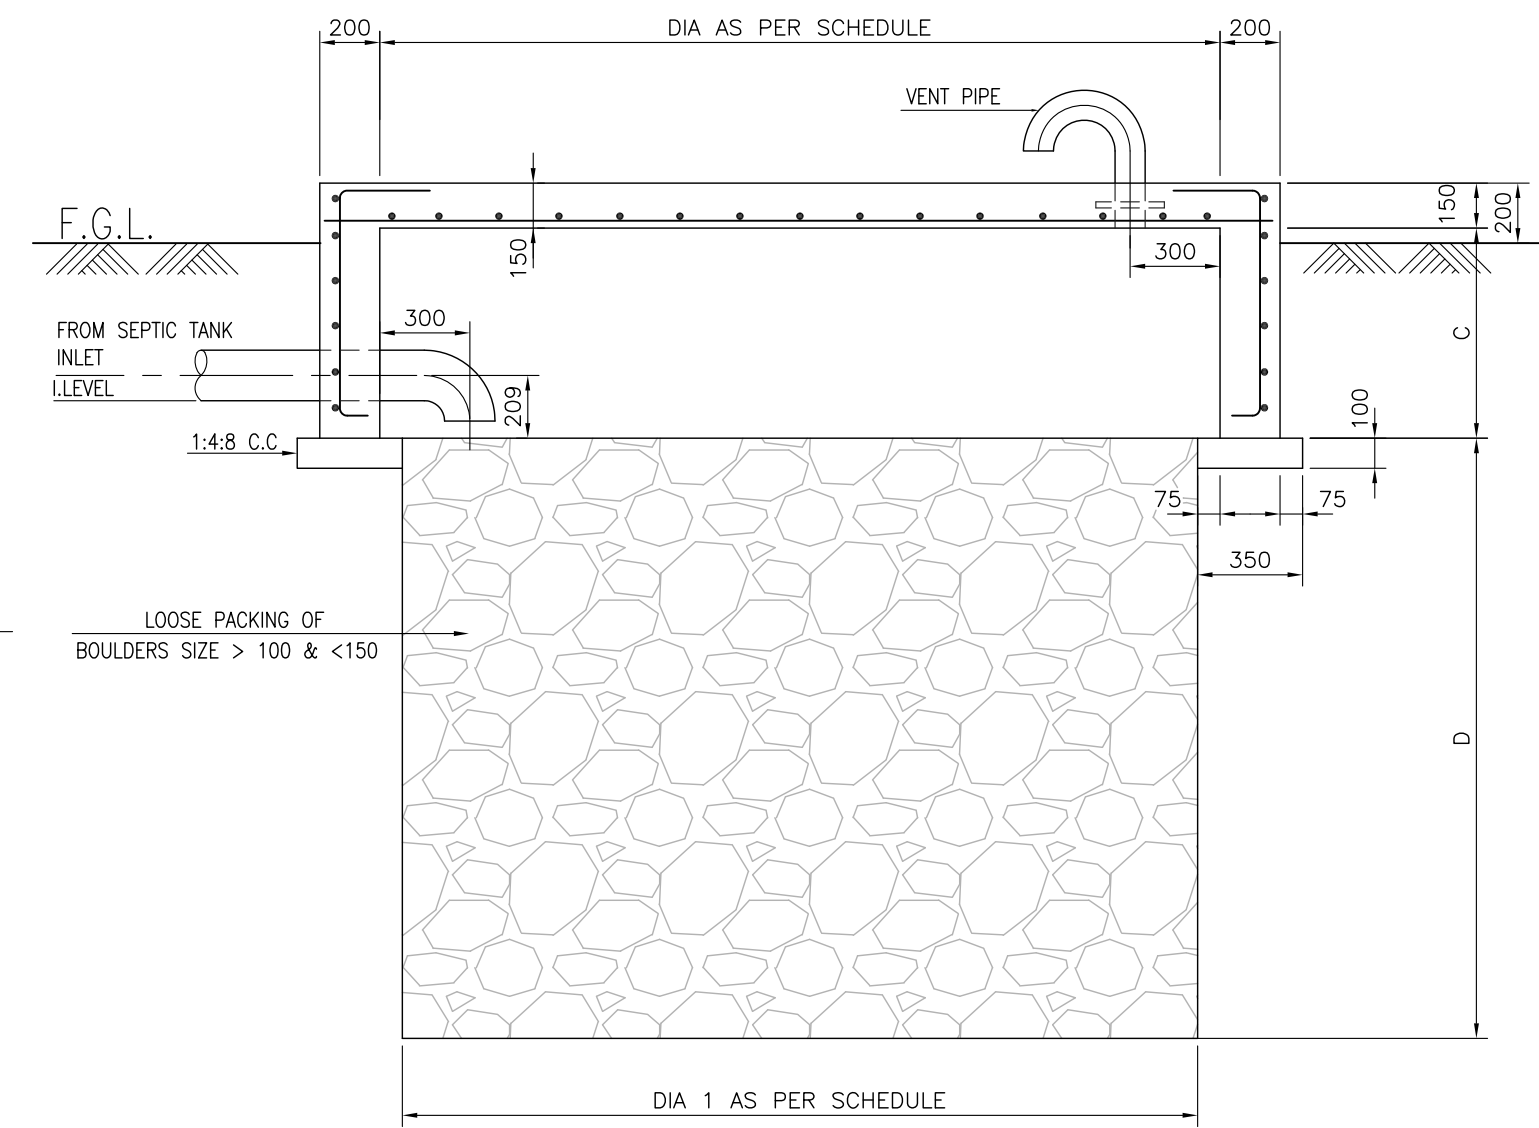

SECTION B-B  
SCALE 1:25

REFERENCE DRAWINGS	
DESCRIPTION	DWG. NO.
PRELIMINARY LAYOUT PLAN	165-4-GPP-001
OUTSIDE SEWERAGE SYSTEM	165-4-PB-010
SANITARY SEWER DETAIL	165-4-PB-011

AS BUILT

## NOTES:

- THIS DRAWING SHALL BE READ IN CONJUNCTION WITH DWG. NO. 165-4-CSTD-001 TO 004.

FO REV.	25-08-2017 DATE	AS BUILT DESCRIPTION OF REVISION	MSL DRAWN	MSH CHECKED	SMM APPR.
CLIENT: <b>OIL &amp; GAS DEVELOPMENT COMPANY LTD.</b> OGDCL HOUSE TOWER-B, FIRST FLOOR PRIG, BLUE AREA, JINNAH AVENUE ISLAMABAD PAKISTAN FAX: +92 051 2623033, PHONE: +92 051 6209850					
CONSULTANT: <b>Zishan Engineers (Pvt.) Ltd.</b> An ISO 9001-2008 certified company 47/F Block 6, PECHS, Karachi-Pakistan Tel: (92-21) 3439045-46 & 34310161-54, Fax: (92-21) 34533430 & 34510156 E-Mail: contact@zishanengineers.com Website: www.zishanengineers.com			DWG. NO. 165-4-PB-012 REV. F0		
PROJECT : KPD-TAY INTEGRATED DEVELOPMENT PROJECT PHASE-II			JOB NO. 165-4		
TITLE : SOAK PIT & SEPTIC TANK DETAILS			SIZE A1	SCALE N.T.S.	SHEET 1