




X:\165-OGDC\165-4 (KPD-TAY)\CIVIL\AS BUILT\26-04-2018\DWG\CIVL\STD DWG\165-4-CSTD-009_RFC.dwg Apr 26, 2018 5:50pm ZEL-COMP103

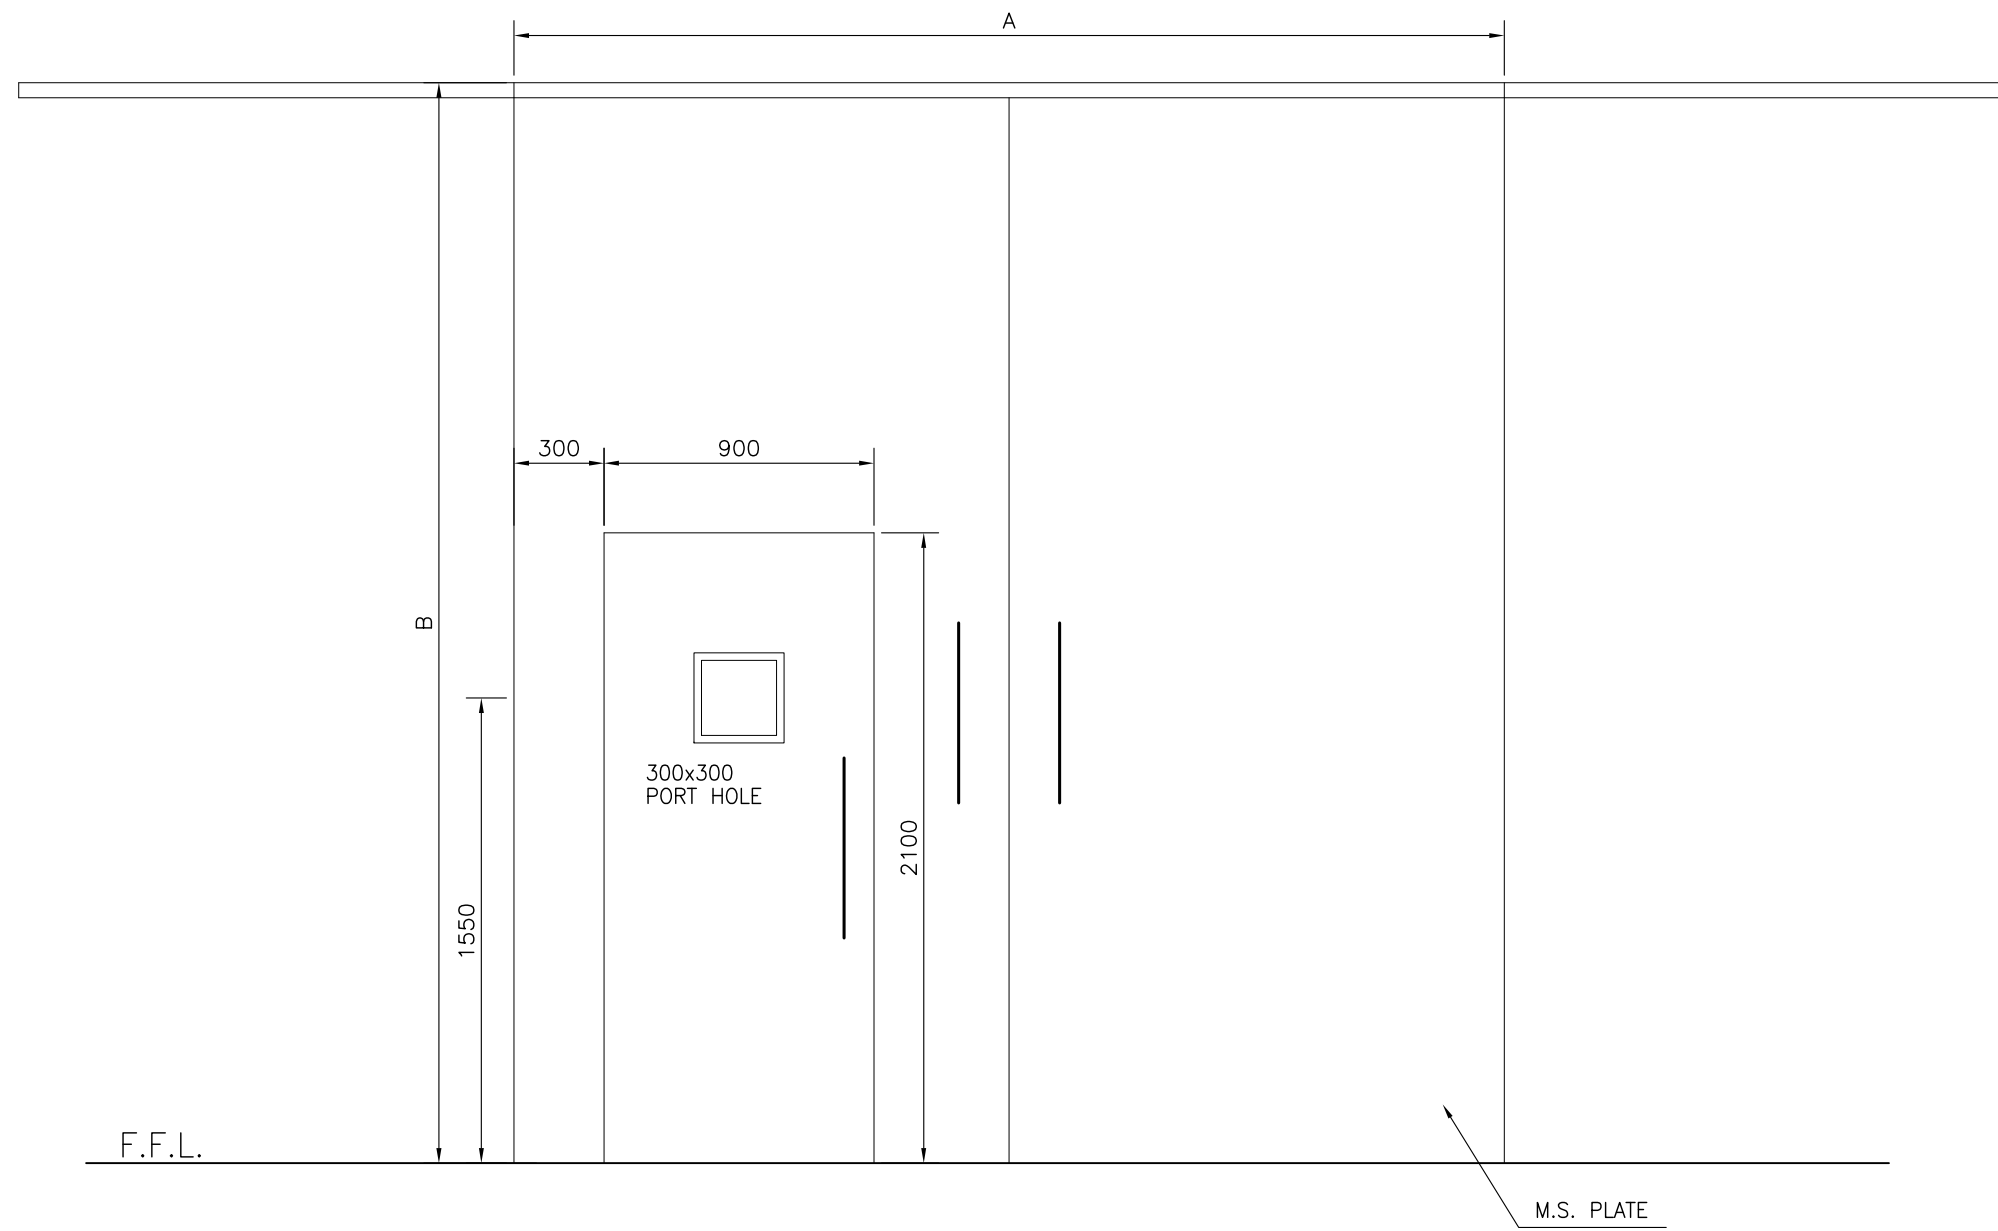


DOUBLE LEAF DOUBLE SLIDE STEEL DOOR

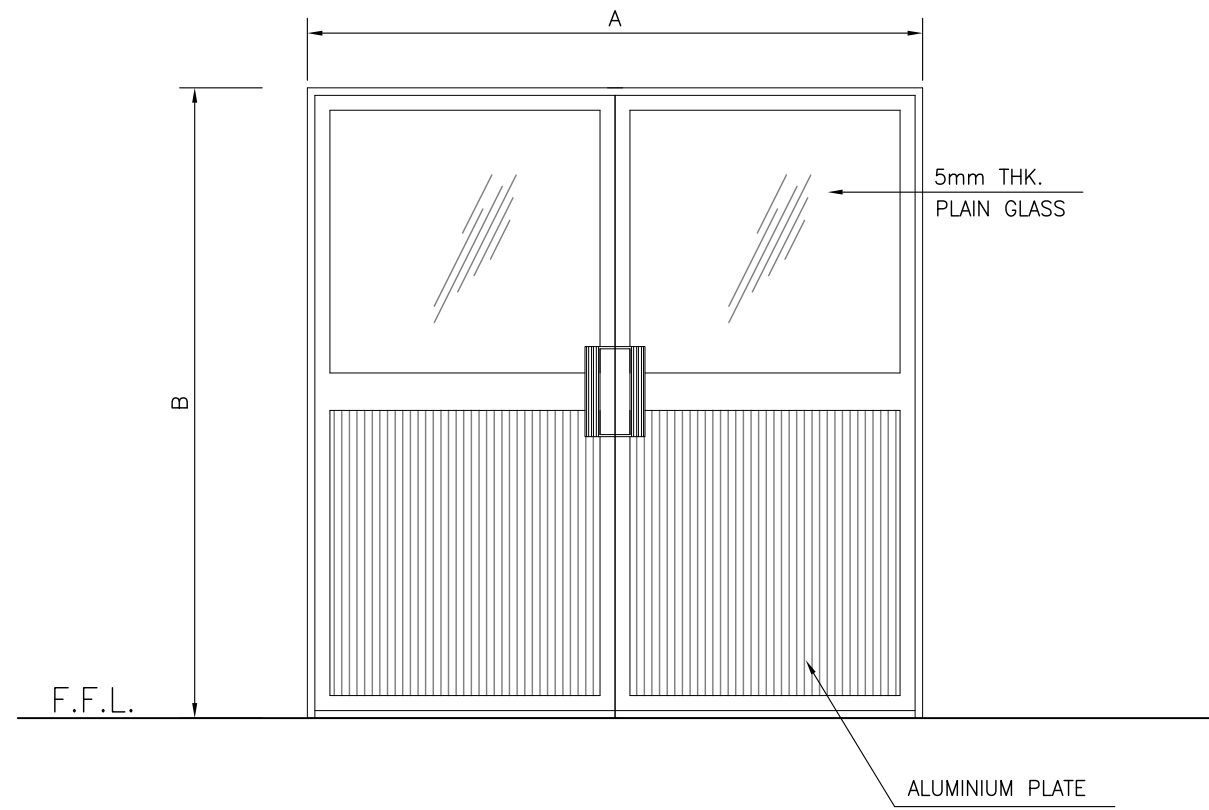


ANODIZED ALUMINIUM DOUBLE LEAF SINGLE SWING DOORS
(HALF GLAZED) WITH ANODIZED ALUMINIUM FRAME
(20mm THK. SECTION)

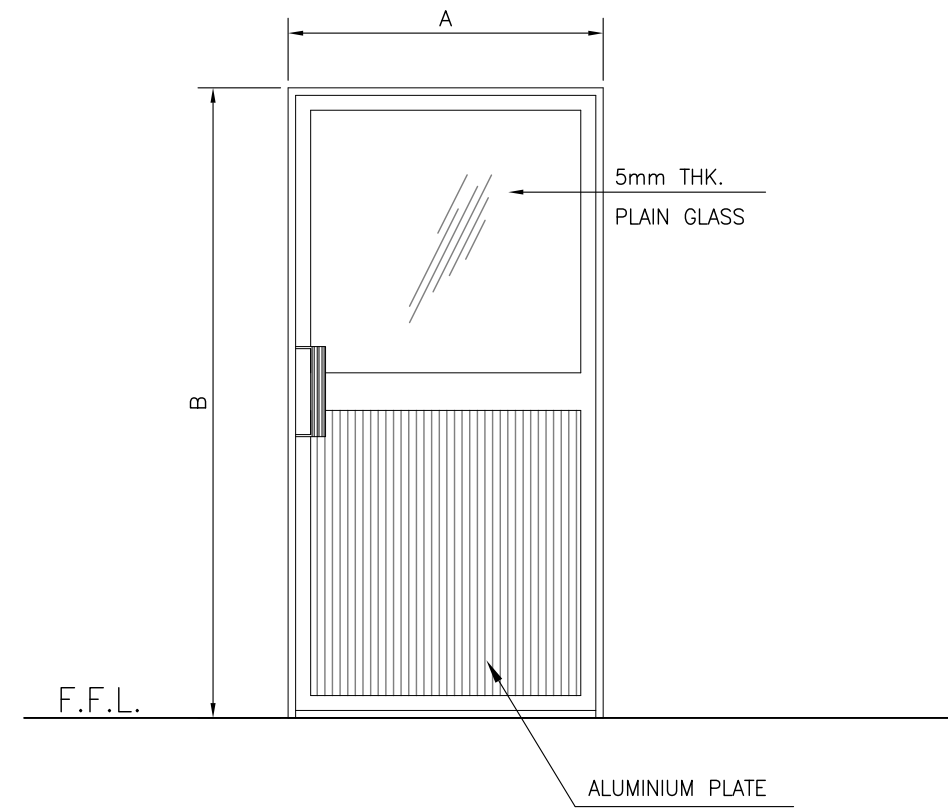


ANODIZED ALUMINIUM SINGLE SWING DOORS PANEL
(HALF GLAZED) WITH ANODIZED ALUMINIUM FRAME
(20mm THK. SECTION)

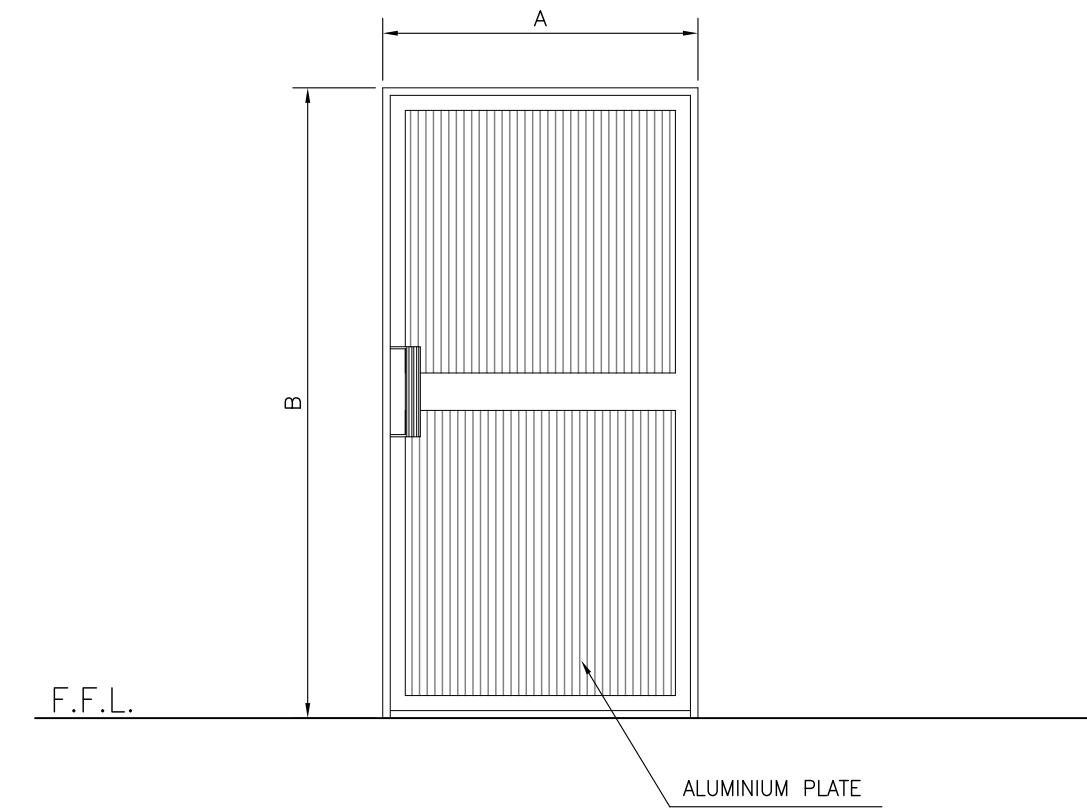


ANODIZED ALUMINIUM SINGLE SWING DOORS PANEL
WITH ANODIZED ALUMINIUM FRAME
(20mm THK. SECTION)

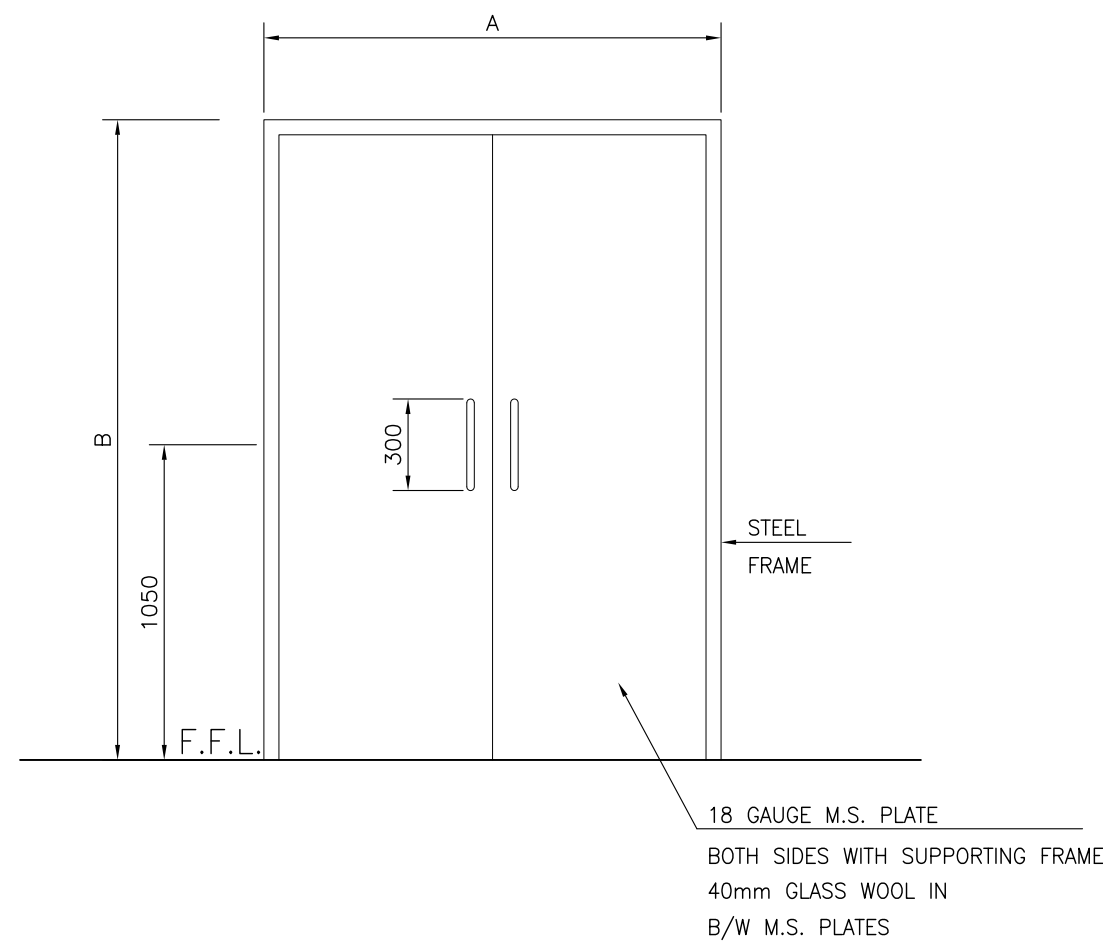

DOUBLE LEAF DOUBLE SWING STEEL DOORS

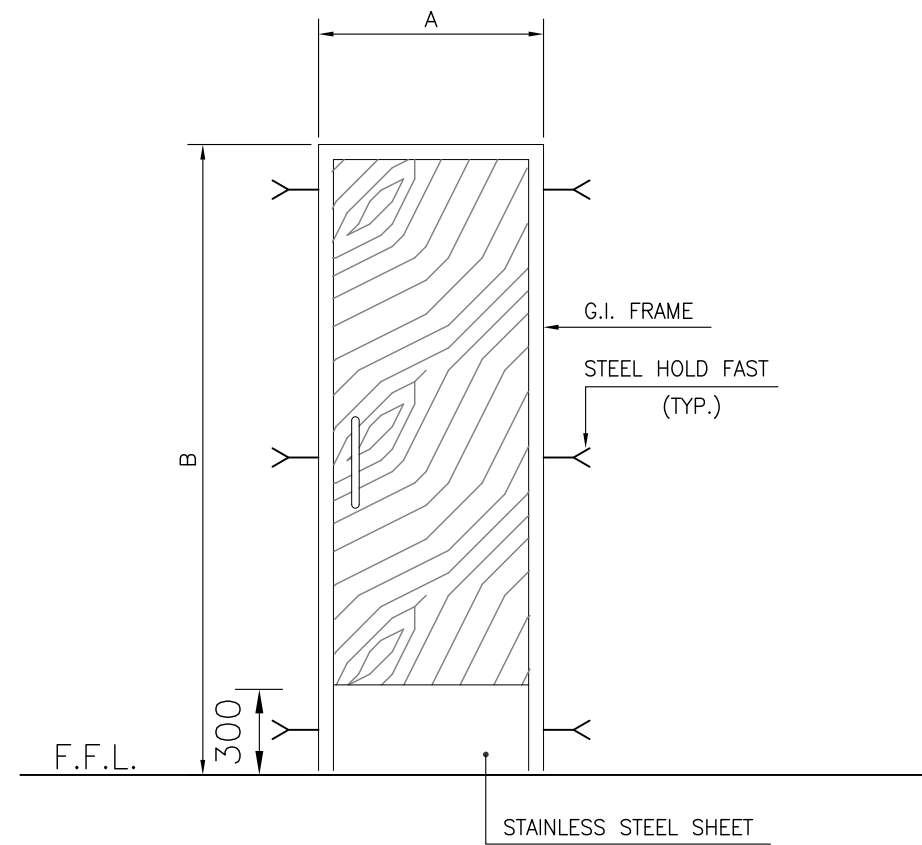

SINGLE LEAF SINGLE SWING WOODEN SOLID
FLUSH DOORS FOR TOILET

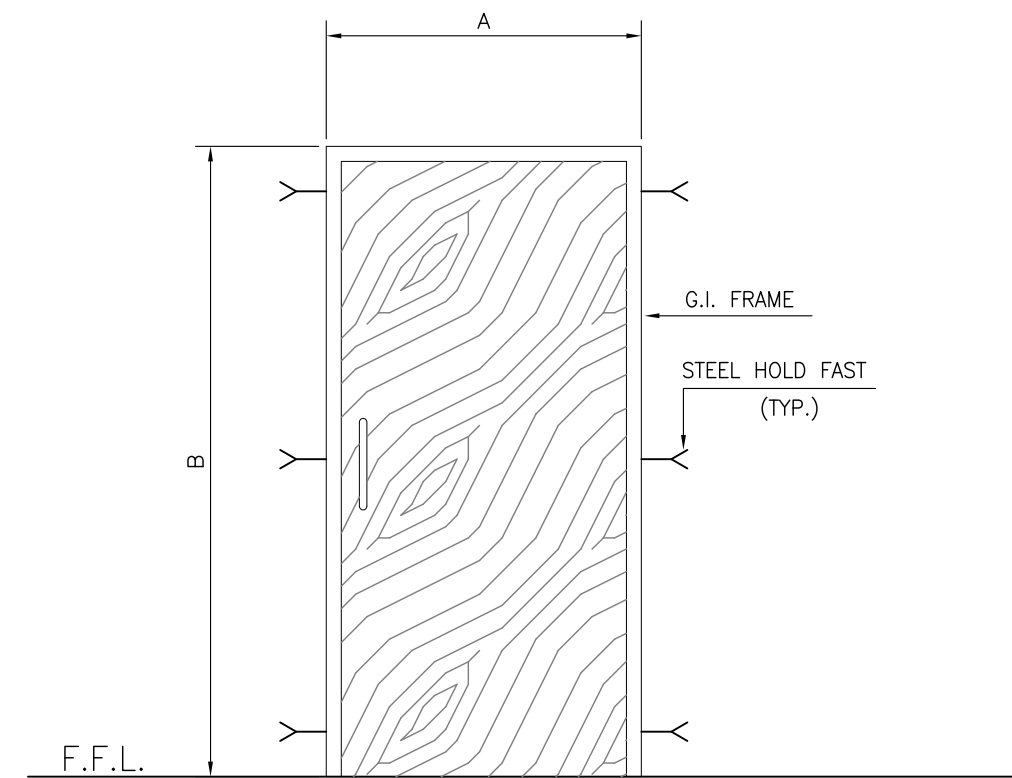

SINGLE LEAF SINGLE SWING WOODEN SOLID FLUSH DOORS





ELEVATION OF ROLL-DOWN SHUTTER

NOTES:

1. THIS DRAWING SHALL BE READ IN CONJUNCTION
WITH DWG. NO. 165-4-CSTD-001 & 004.

AS BUILT

FO	26-04-2018	AS BUILT	MSL	MSH	SMM
REV.	DATE	DESCRIPTION OF REVISION	DRAWN	CHECKED	APPR.
CLIENT:  OIL & GAS DEVELOPMENT COMPANY LTD. OGDCL HOUSE TOWER-B, FIRST FLOOR PB/6, BLUE AREA, JINNAH AVENUE ISLAMABAD PAKISTAN FAX: +92 051 2623033, PHONE: +92 051 9209859					
CONSULTANT:  Zishan Engineers (Pvt.) Ltd. An ISO 9001-2008 certified company 47/F Block 6, PECHS, Karachi-Pakistan Tel: (92-21) 34393045-46 & 34310161-54; Fax: (92-21) 34333430 & 34510156 E-Mail: contact@zishanengineers.com Website: www.zishanengineers.com			DWG. NO. 165-4-CSTD-009 REV. FO		
PROJECT : KPD-TAY INTEGRATED DEVELOPMENT, PROJECT PHASE-II			JOB NO. 165-4		
TITLE : STANDARD DRAWING FOR DOORS & GLAZING DETAIL			SIZE A1	SCALE N.T.S.	SHEET 1