




REFERENCE DRAWINGS	
DESCRIPTION	DWG. NO.
GENERAL PLOT PLAN	165-4-GPP-001
ROAD LAYOUT PLAN	165-4-C-064

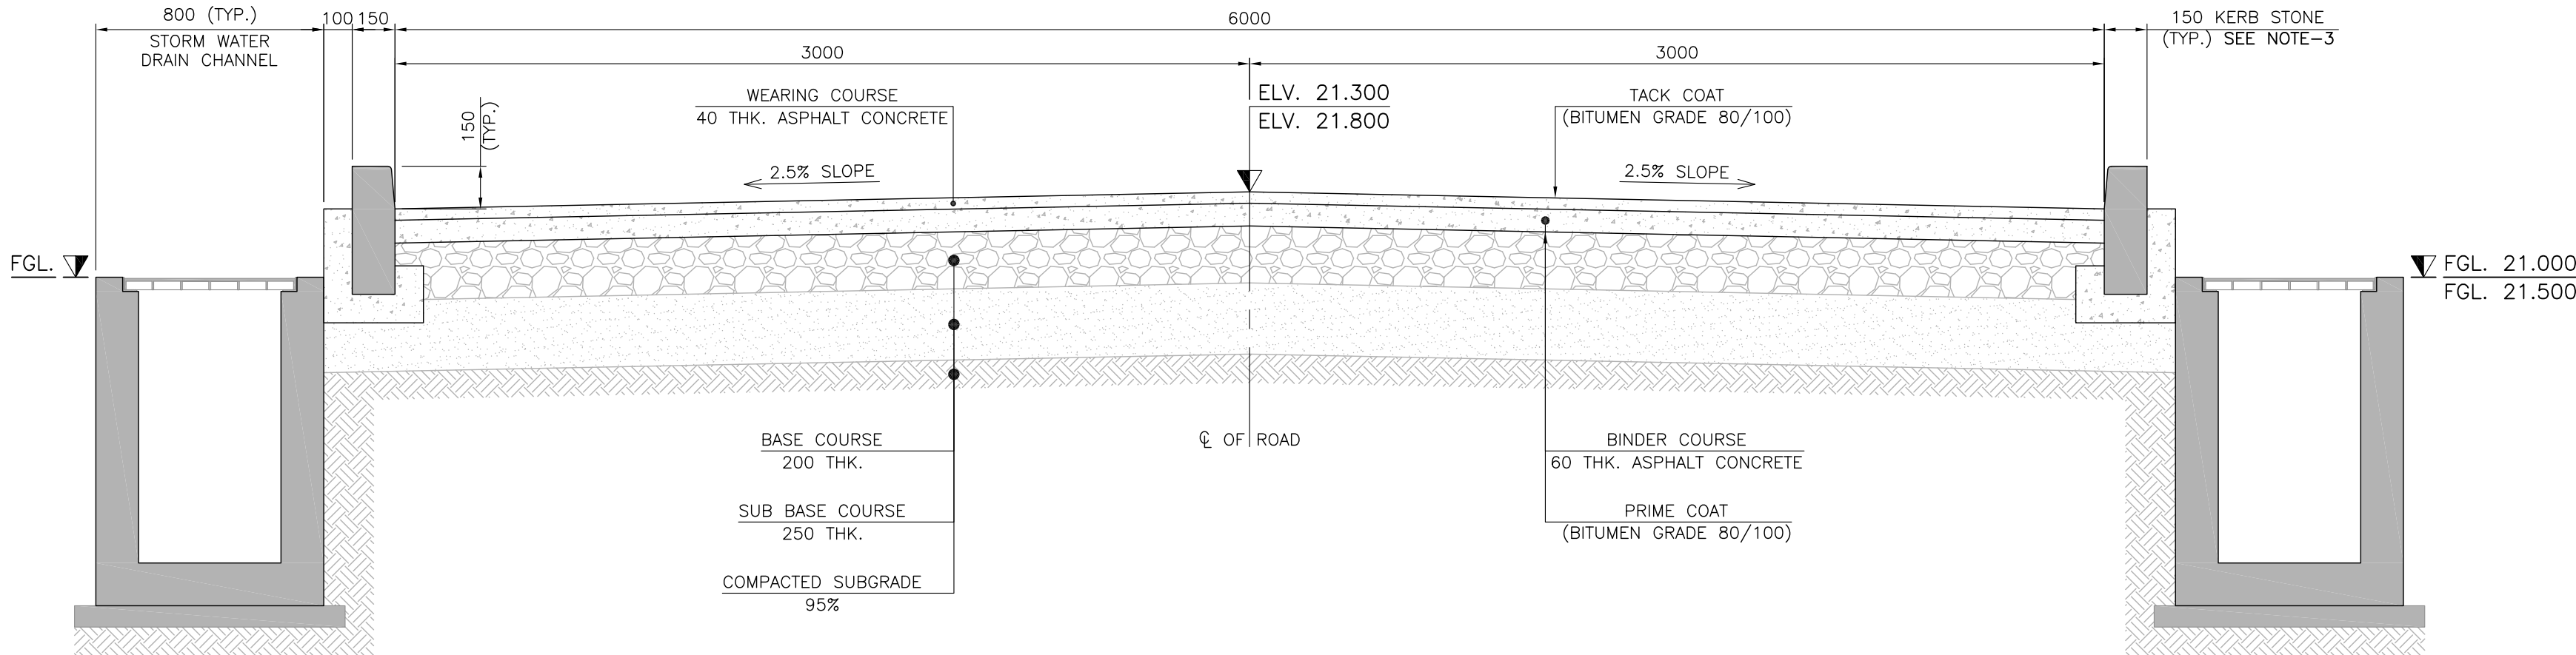


TYP. CROSS SECTION OF 6m WIDE ROAD (EXCEPT ROAD-20)  
(SCALE = 1 : 20)

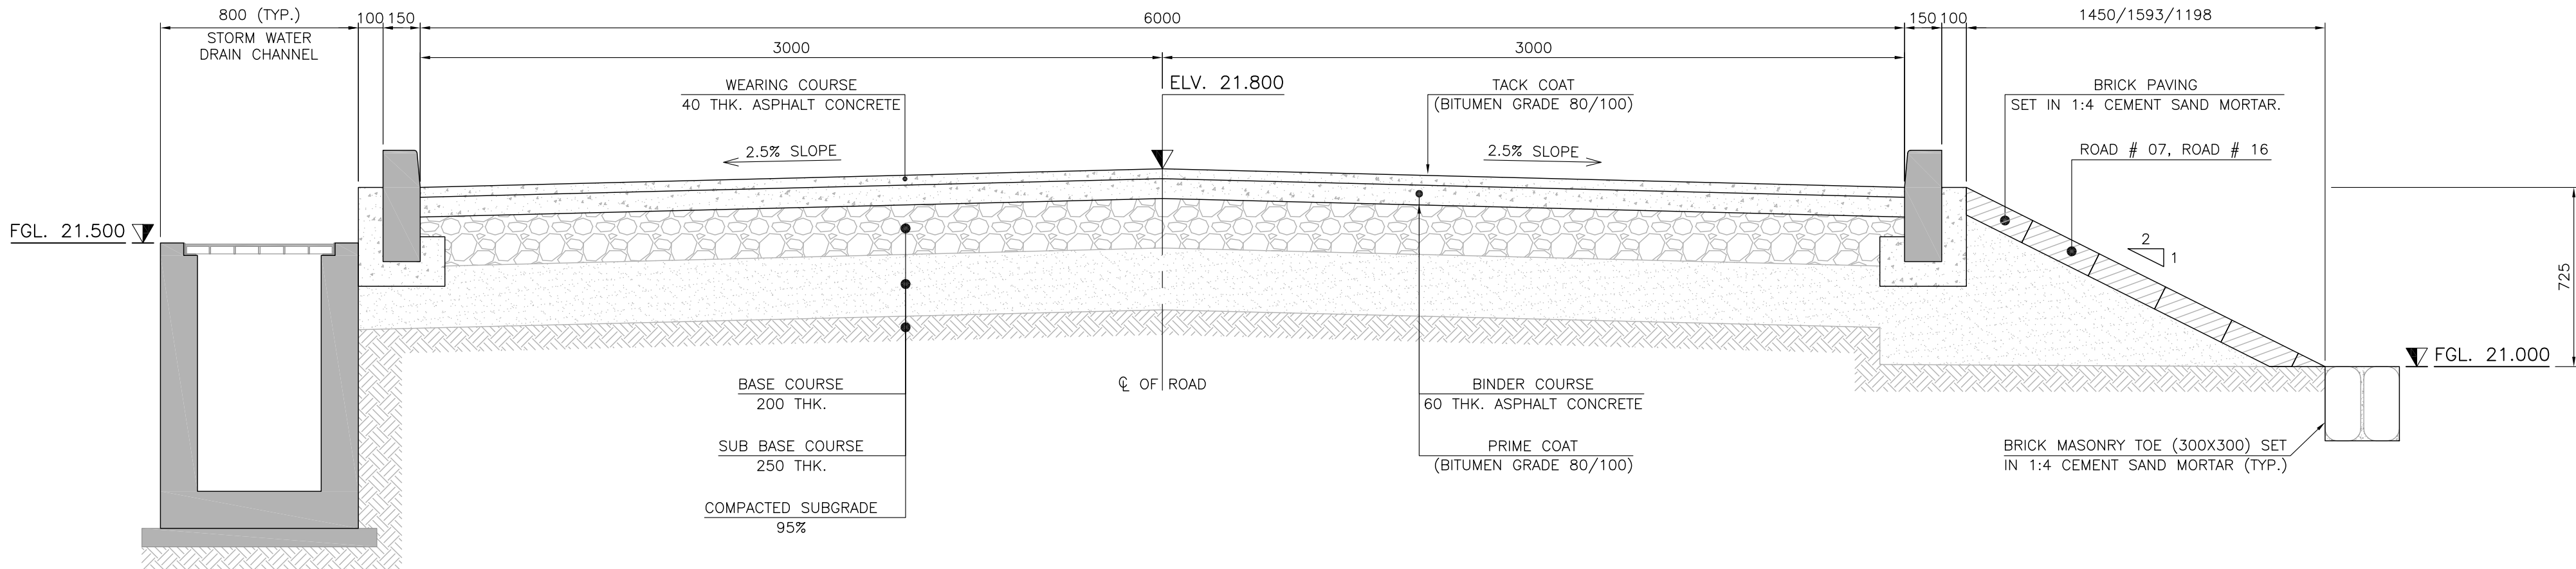


TYP. CROSS SECTION OF ROAD-20  
(SCALE = 1 : 20)

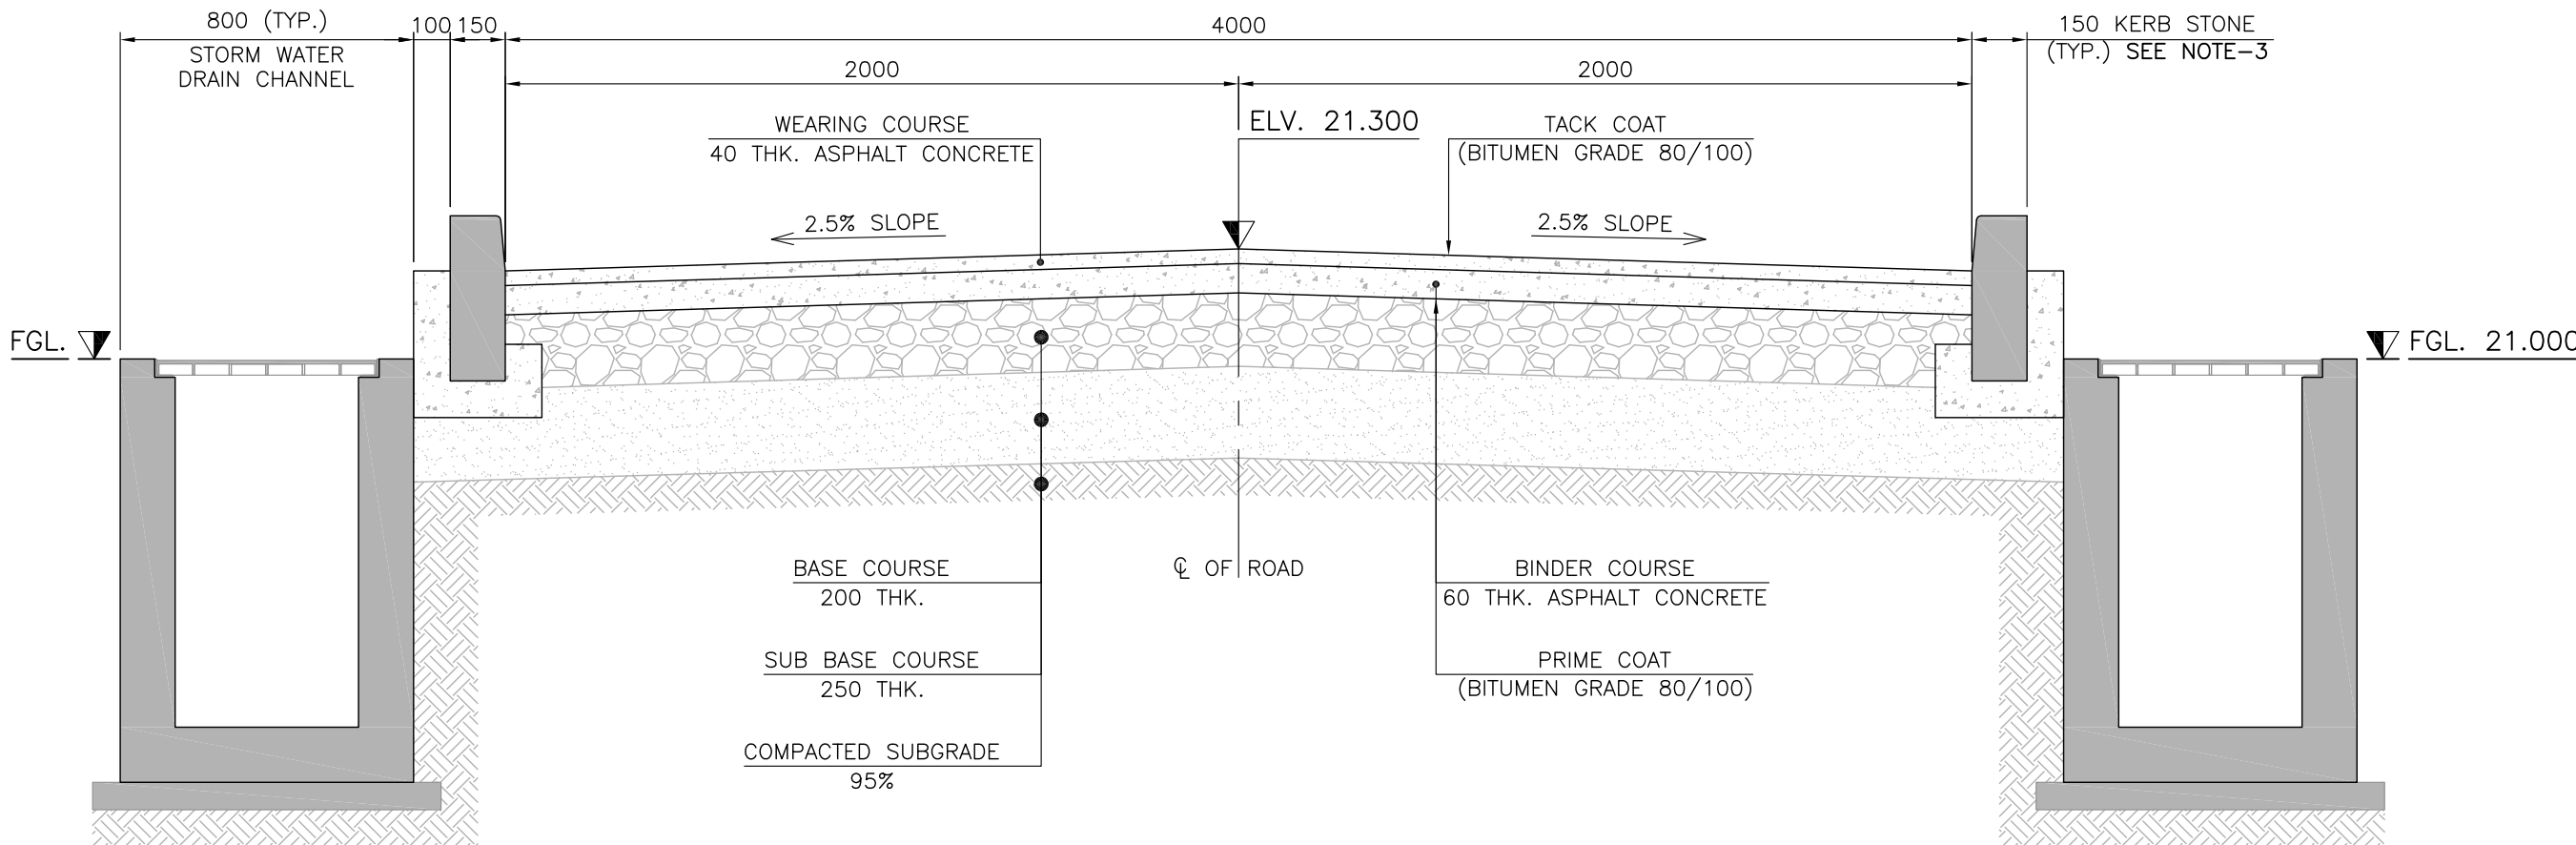

TYP. CROSS SECTION OF 4m WIDE ROAD-6  
(SCALE = 1 : 20)

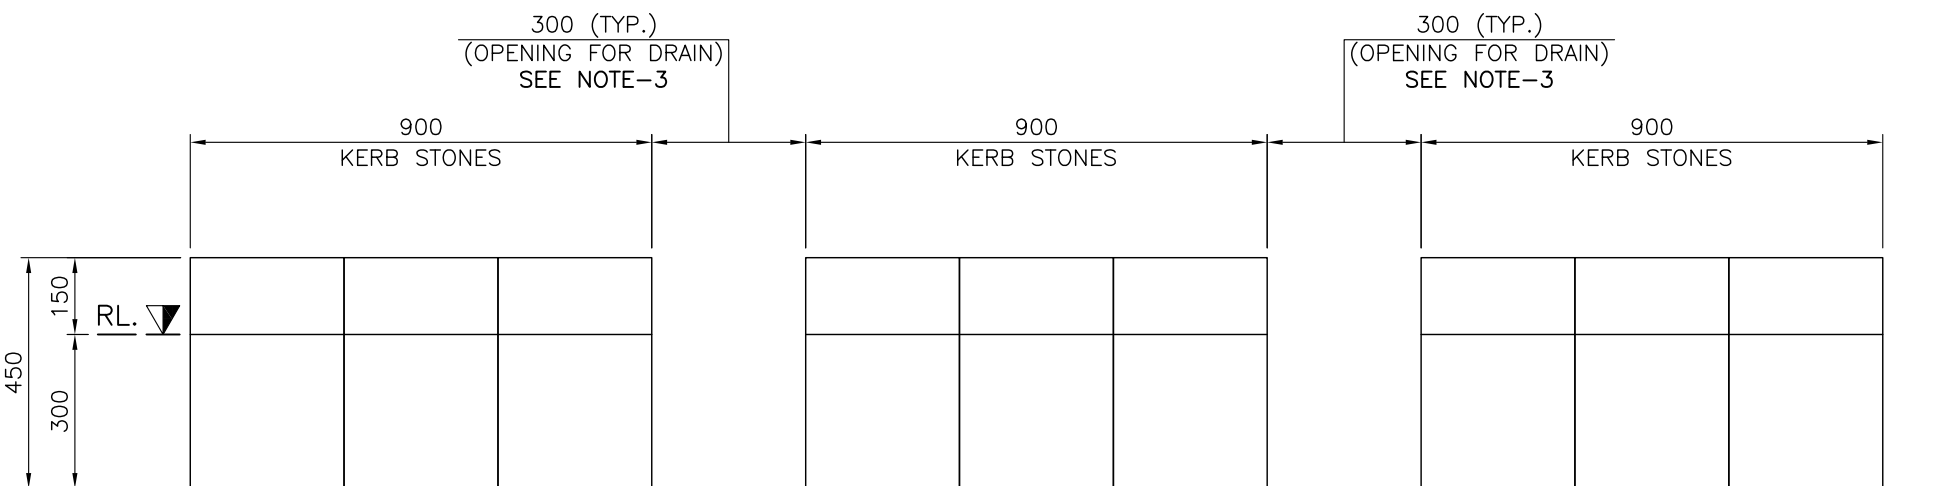

TYP. ELEVATIONAL DETAIL FOR KERB STONE  
(SCALE = 1 : 15)

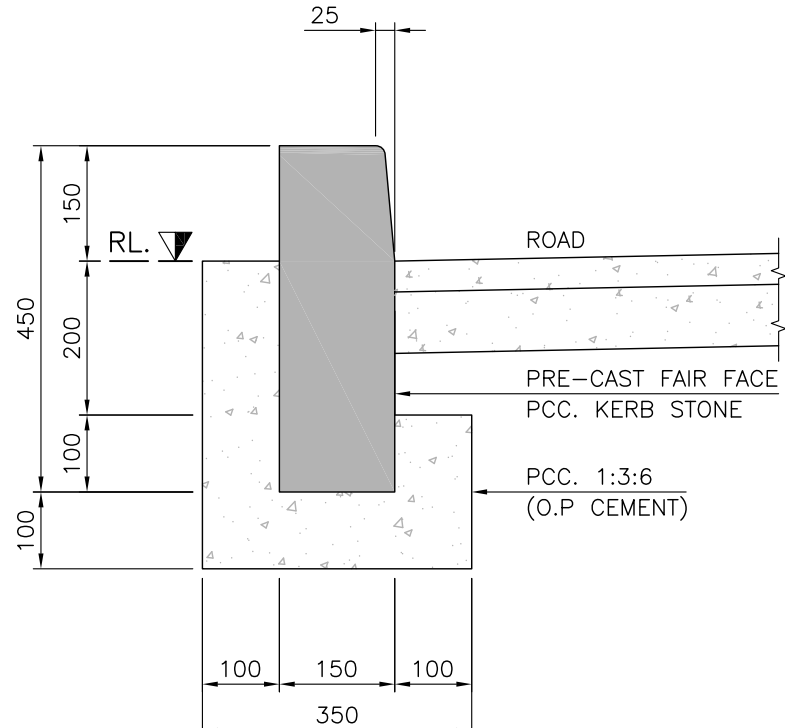

TYP. SECTIONAL DETAIL OF KERB STONE  
(SCALE = 1 : 10)

LEGENDS:—

FGL.	FINISHED GROUND LEVEL.
RL.	ROAD LEVEL.
ELV.	ELEVATION.
TYP.	TYPICAL.
THK.	THICK. / THICKNESS.

AS BUILT

NOTES:

1. ALL DIMENSIONS ARE IN MILLIMETER (mm), LEVELS AND COORDINATES ARE IN METER (m) UNLESS OTHERWISE STATED.
2. THIS DRAWING SHALL BE READ IN CONJUNCTION WITH DWG. NO. 165-4-CSTD-001 TO 004
3. ONE OPENING TO BE PROVIDED AFTER EVERY 3 KERB STONE.

[illegible]