
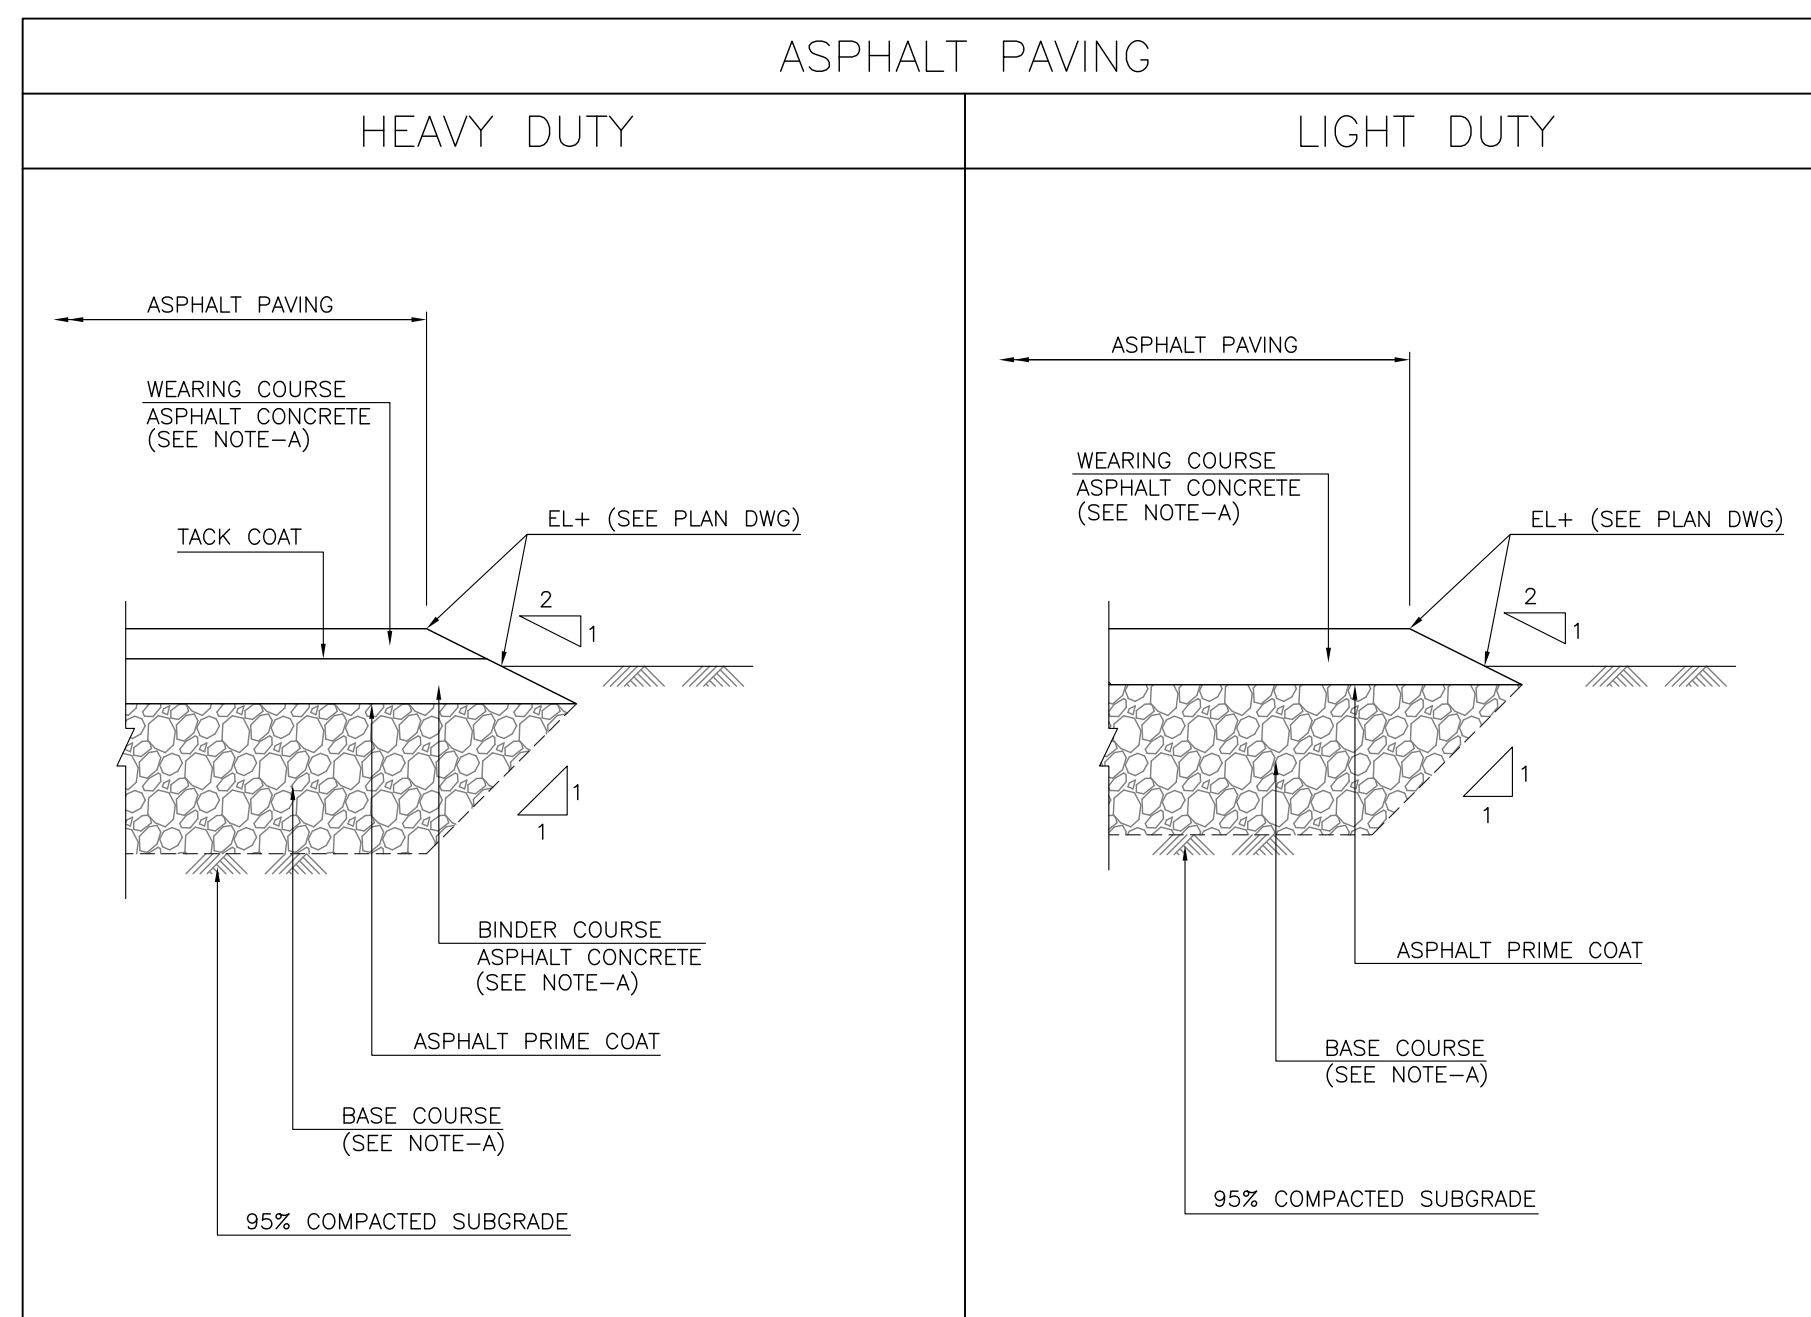
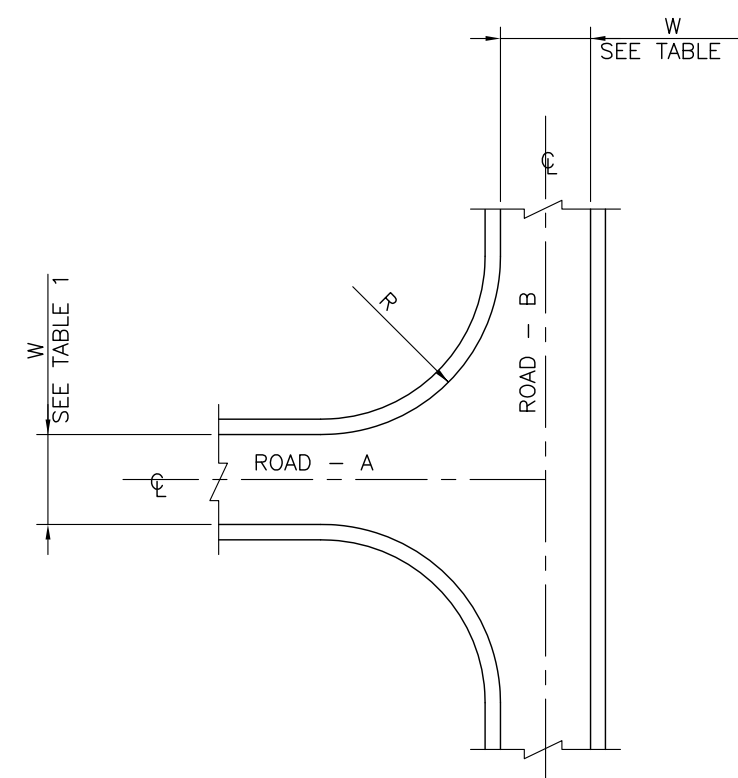
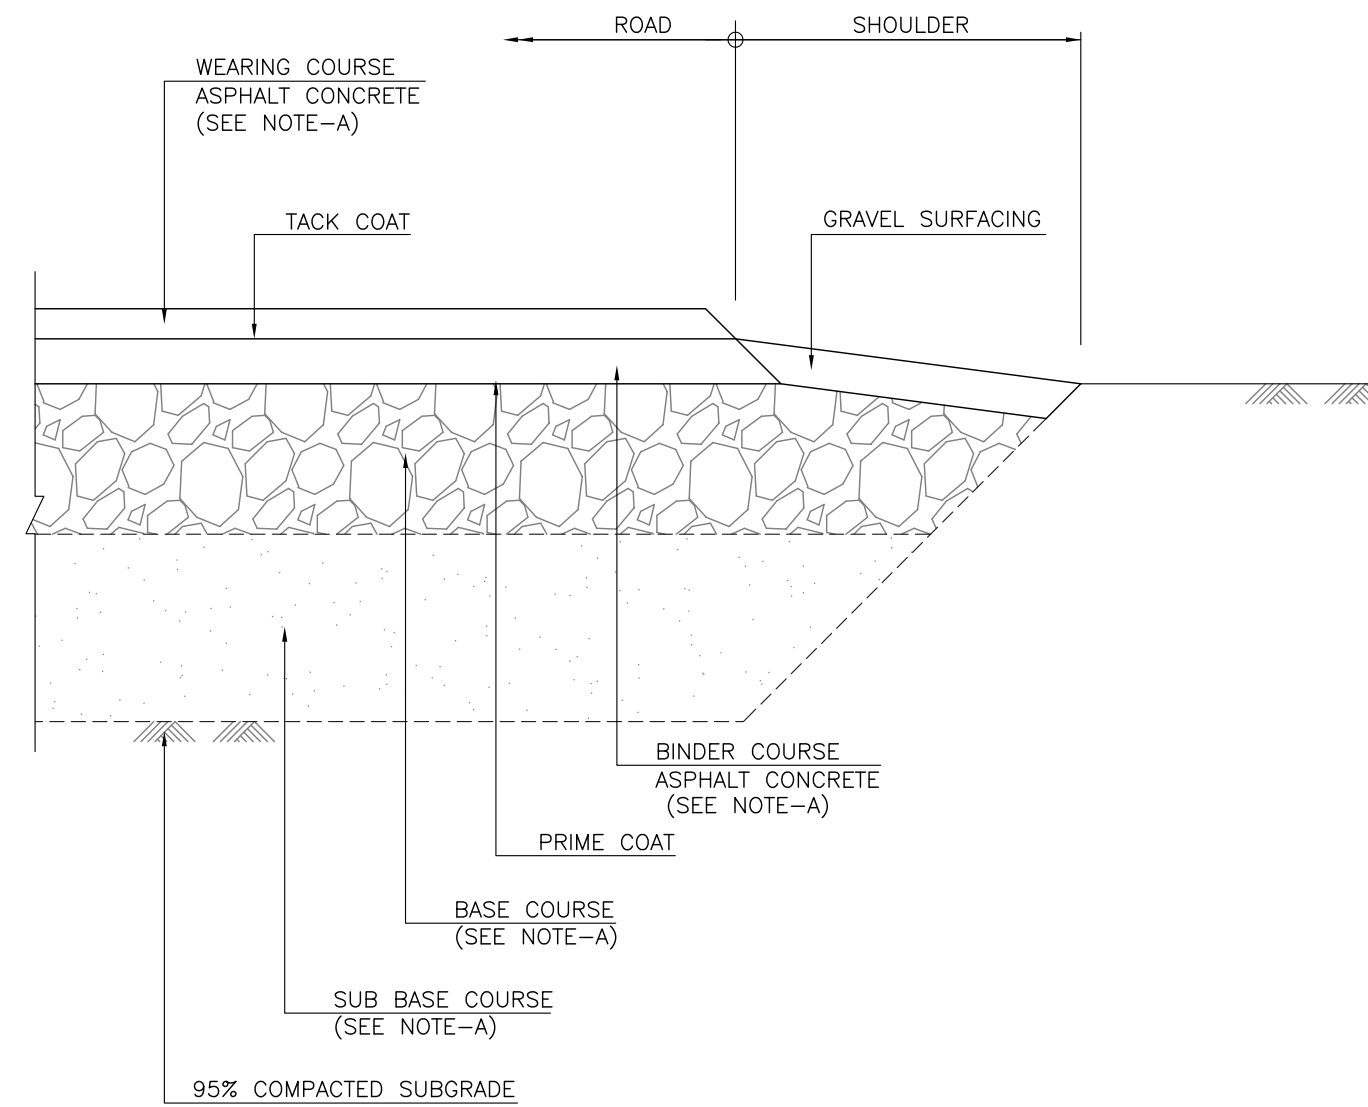
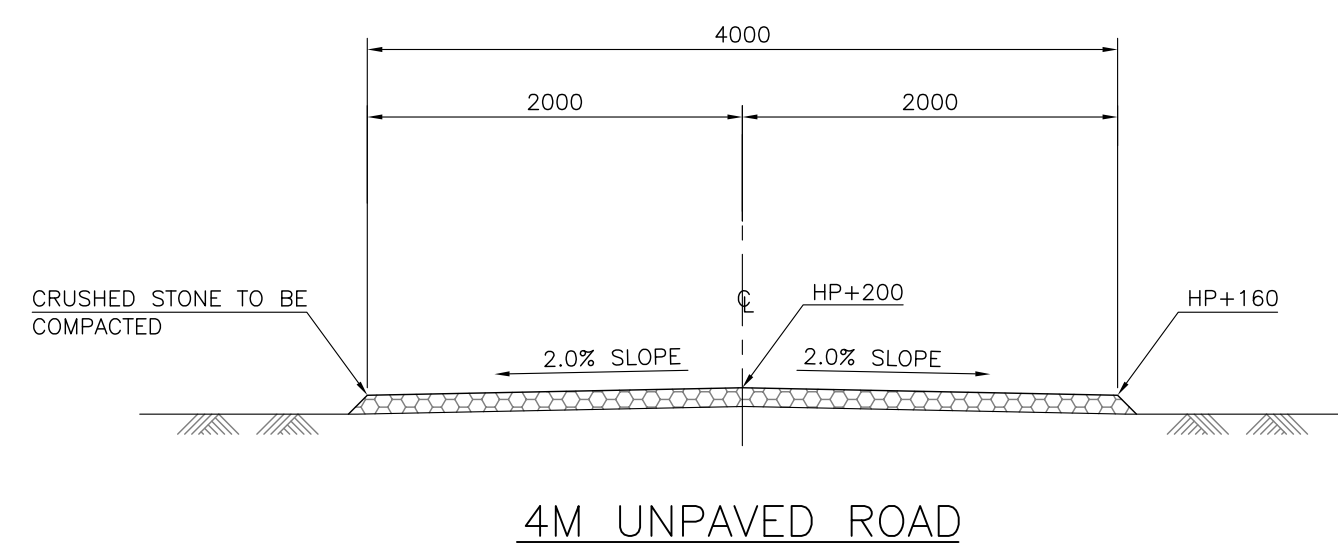
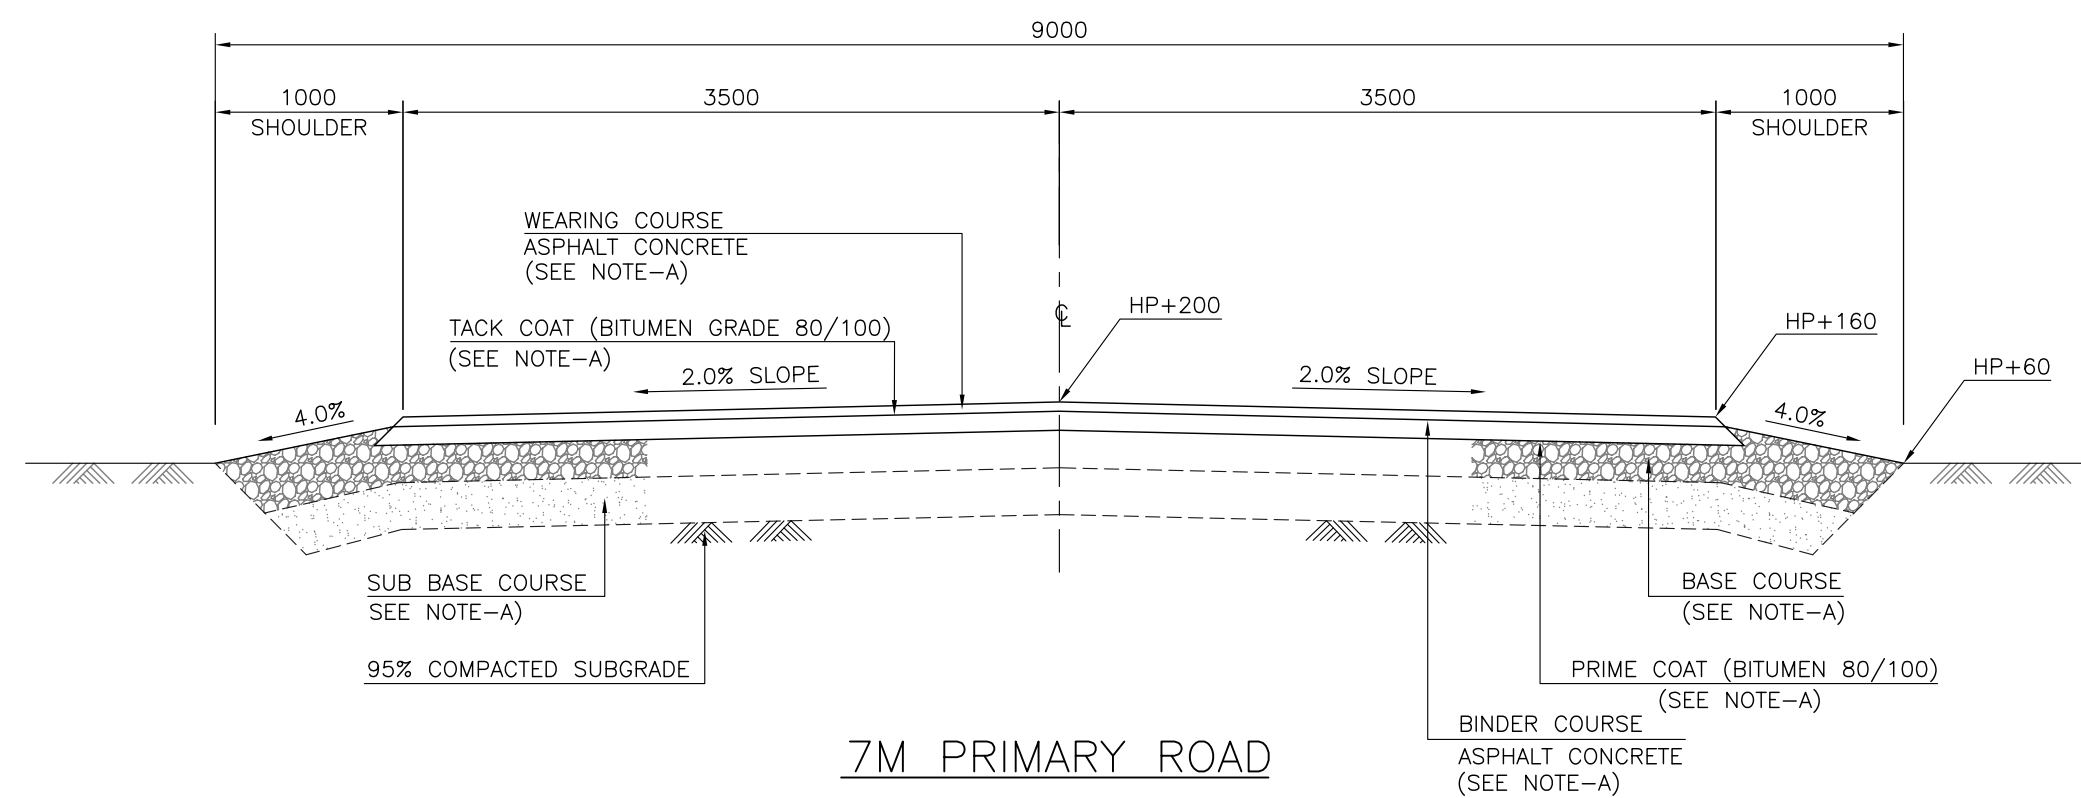
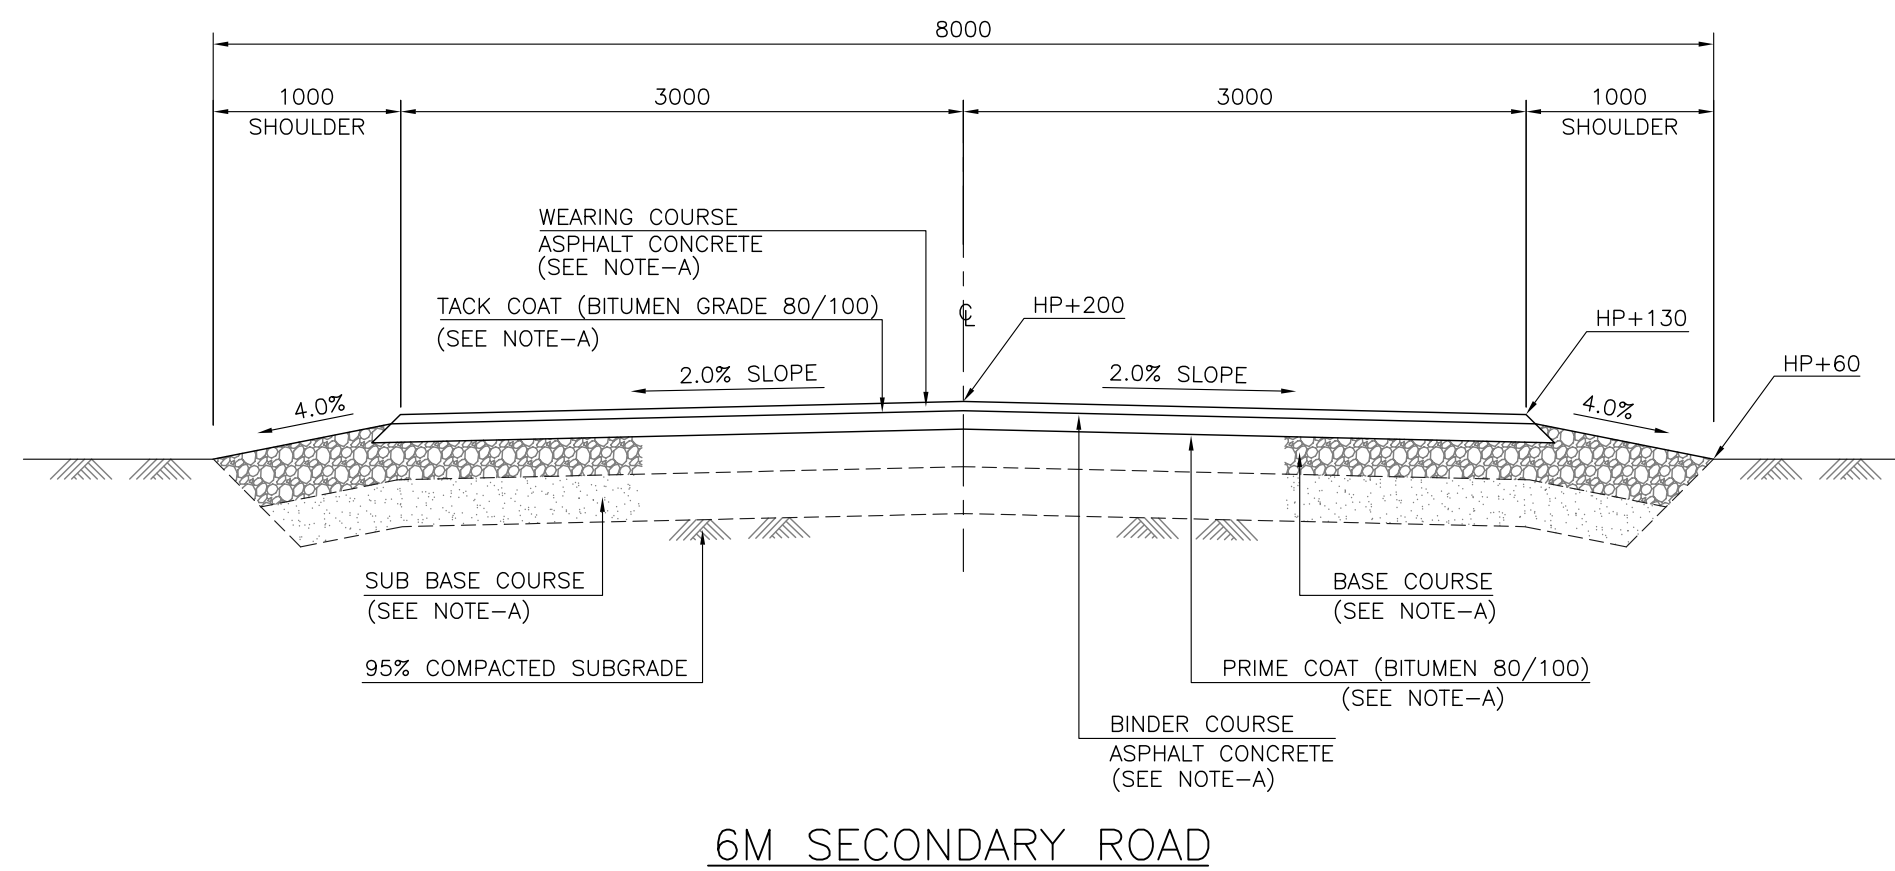


X:\165-OGDC\165-4 (KPD-TAY)\CIVIL\AS BUILT\165-4-2018\DWG\165-4-CSTD-013-RFO.dwg Apr 26, 2018 - 5:51pm ZEL-COMP103

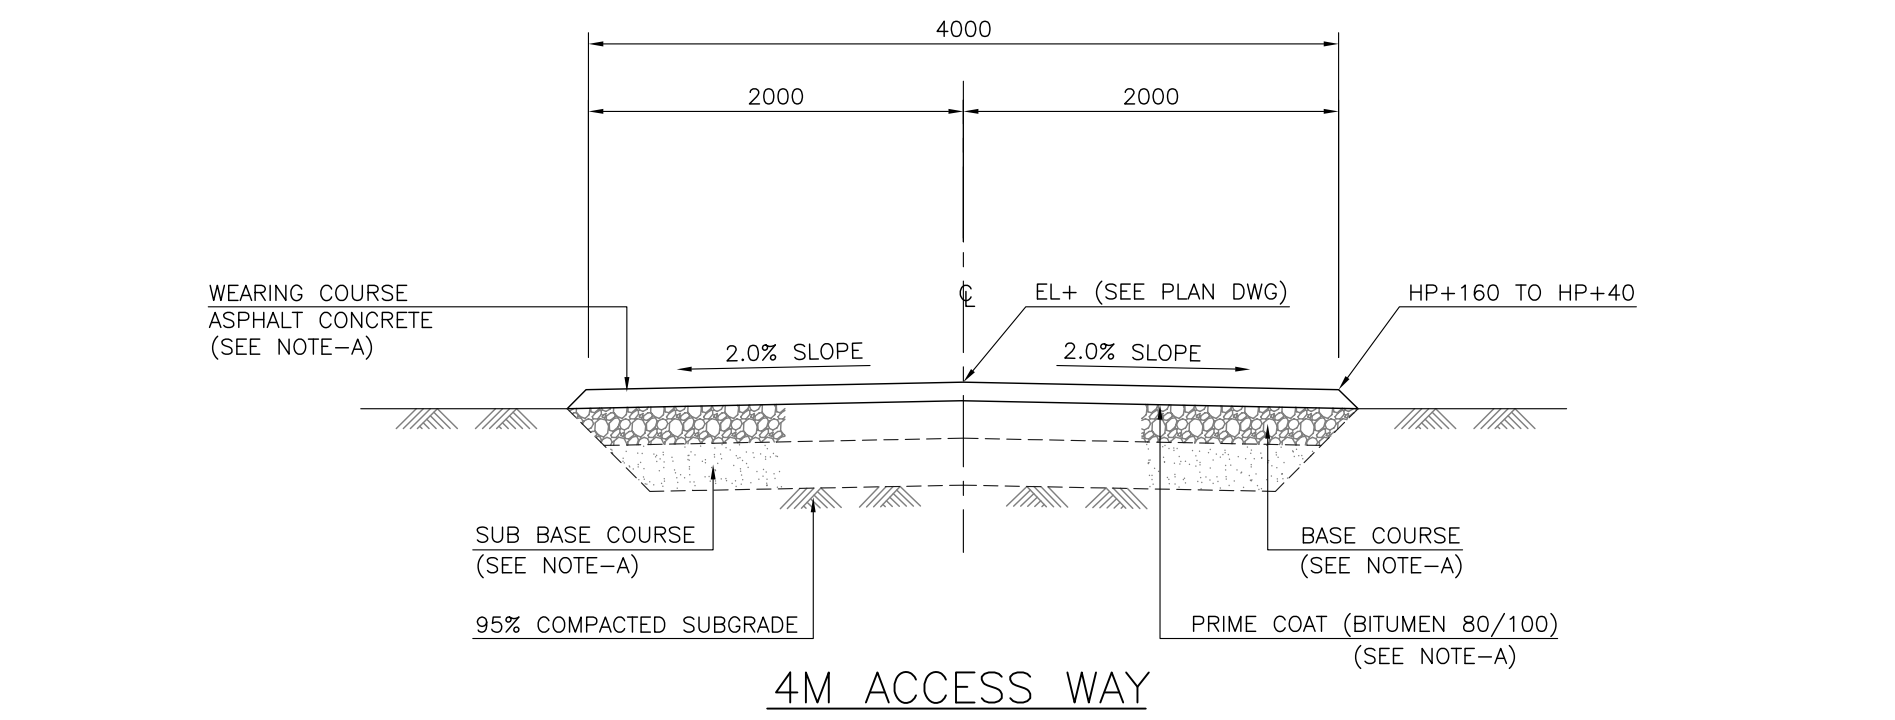

NOTE A:—  
THESE DIMENSIONS TO  
BE CONFIRMED BY DESIGN

#### NOTES:

- THIS DRAWING SHALL BE READ IN CONJUNCTION WITH DWG. NO. 165-4-CSTD-001 TO 004.

AS BUILT

FO	26-04-2018	AS BUILT	MSL	MSH	SMM
REV.	DATE	DESCRIPTION OF REVISION	DRAWN	CHECKED	APPR.
CLIENT: OIL & GAS DEVELOPMENT COMPANY LTD. OGDCL HOUSE TOWER-B, FIRST FLOOR F8/G6, BLUE AREA, JINNAH AVENUE ISLAMABAD PAKISTAN Fax: +92 051 2623033, PHONE: +92 051 9209859					
CONSULTANT: Zishan Engineers (Pvt.) Ltd. An ISO 9001-2008 certified company 47/F Block 6, PSECHS, Karachi-Pakistan Tel: (92-21) 3439045-46 & 34310161-54, Fax: (92-21) 34533430 & 34510156 E-Mail: contact@zishanengineers.com Website: www.zishanengineers.com			DWG. NO. 165-4-CSTD-013 REV. F0		
PROJECT : KPD-TAY INTEGRATED DEVELOPMENT, PROJECT PHASE-II			JOB NO. 165-4		
TITLE : STANDARD DRAWING OF TYPICAL ROAD CROSS SECTION			SIZE	SCALE	SHEET
			A1	N.T.S.	1