


-
- Diagram illustrating the details of a Type-I anchor bolt connection. The diagram shows a vertical bolt passing through a concrete slab. The bolt is anchored into the concrete. Dimensions shown include: T (thickness of top concrete), TK (thickness of bottom concrete), K (height of nut/weld area), D (bolt diameter), he (height of embedment), m (height of nut/weld area), and $W \times W$ (width of nut/weld area). Labels include: TOP OF GROUT, TOP OF CONCRETE, NUT WELDED TO ANCHOR PLATE AND BOLT AT THREE POINTS (FIELD WELDING), and TYPE-I N.T.S.
- TYPE-I**
N.T.S.
- * TO BE VERIFIED AS PER ACTUAL/DESIGN REQUIREMENT.

TYPE-I
N.T.S.
* TO BE VERIFIED AS PER
ACTUAL/DESIGN REQUIREMENT.

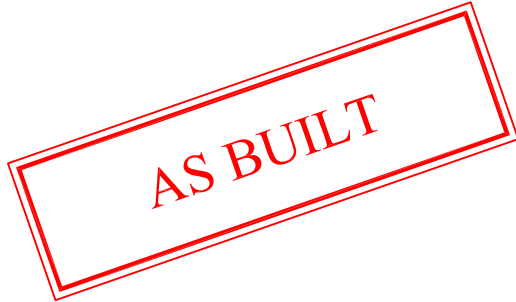

| | | | | | |
|------|------------|-------------------------|-------|---------|-------|
| F0 | 26-04-2018 | AS BUILT | MSL | MSH | SMW |
| REV. | DATE | DESCRIPTION OF REVISION | DRAWN | CHECKED | APPR. |

| | | | | | |
|---|---|-----------------------------------|--------------|--------------|--|
| | CLIENT. OIL & GAS DEVELOPMENT COMPANY LTD. OGDC HOUSE TOWER-B, FIRST FLOOR F6/F6, BLUE AREA, JINNAH AVENUE ISLAMABAD PAKISTAN FAX : +92 051 2622033, PHONE: +92-051 0029859 | | | | |
| | CONSULTANT. Zishan Engineers (Pvt.) Ltd. An ISO 9001-2008 certified company 47/F Block 6, PECHS, Karachi-Pakistan Tel: (92-21) 34303045-48, & 34310161-54, Fax: (92-21) 34533430 & 34510156 E-Mail: contact@zishanengineers.com Website: www.zishanengineers.com | | | | |
| PROJECT : <u>KPD-TAY INTEGRATED DEVELOPMENT PROJECT PHASE-II</u> | | DWG. NO. 165-4-CSTD-006 | | | |
| TITLE : <u>STANDARD DRAWING FOR PEDESTAL ANCHOR BOLTS</u> | | REV. F0 | | | |
| PROJECT : <u>KPD-TAY INTEGRATED DEVELOPMENT PROJECT PHASE-II</u> | | JOB NO. 165-4 | | | |
| | | SIZE | SCALE | SHEET | |
| | | A1 | N.T.S. | 1 | |