
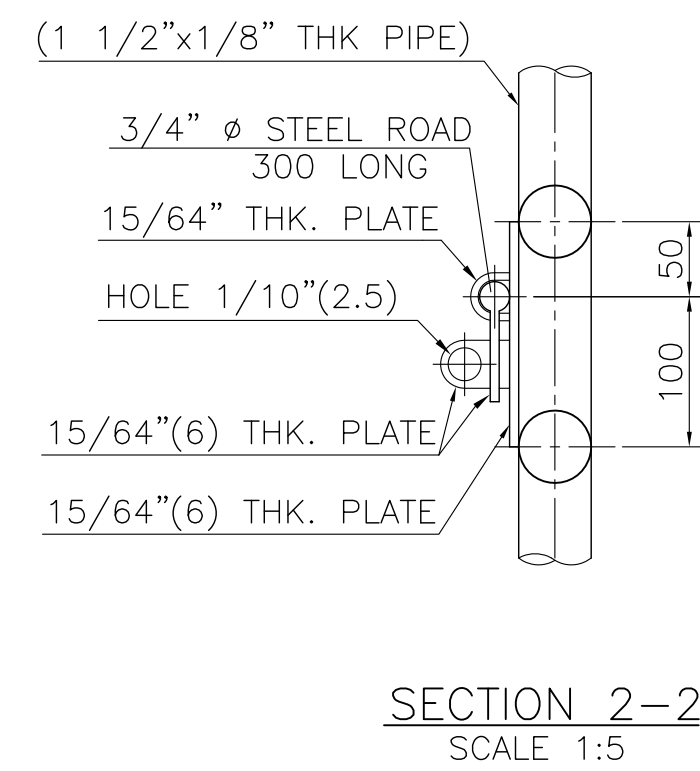
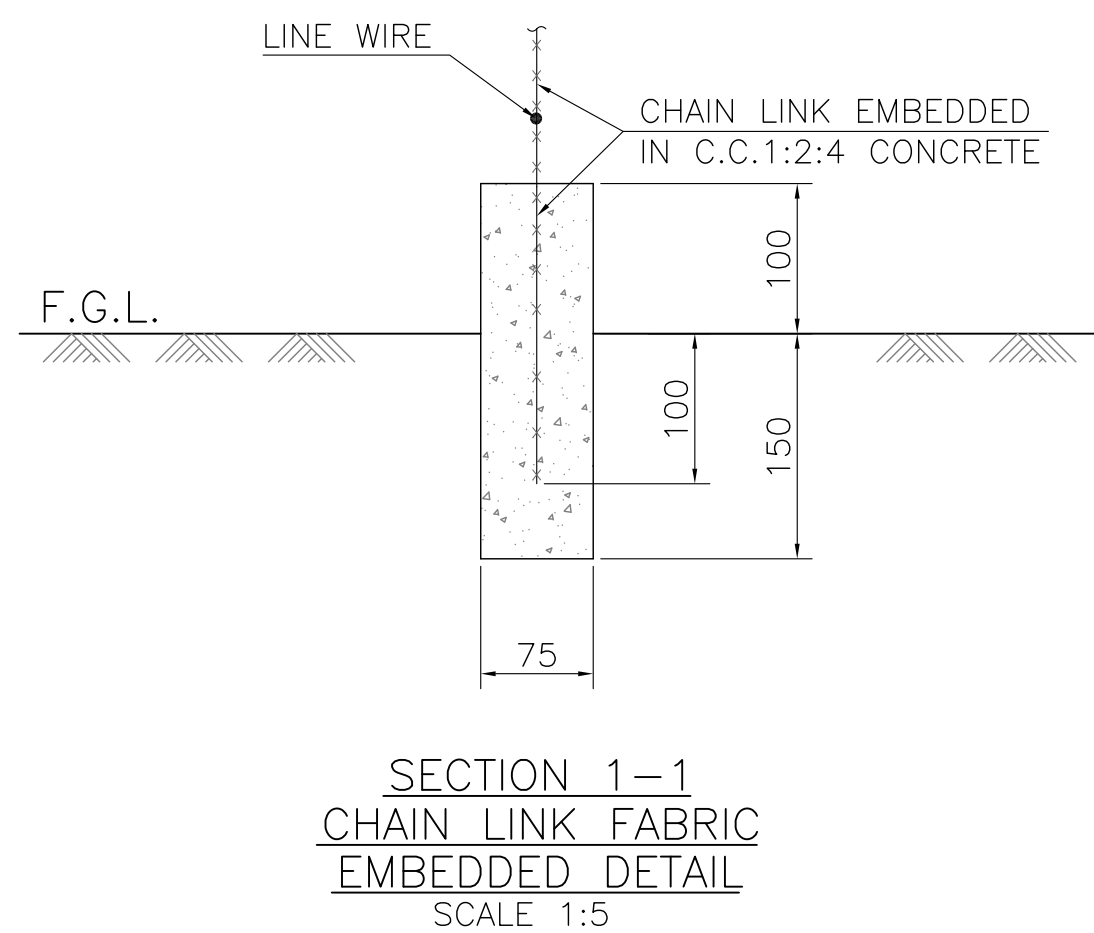
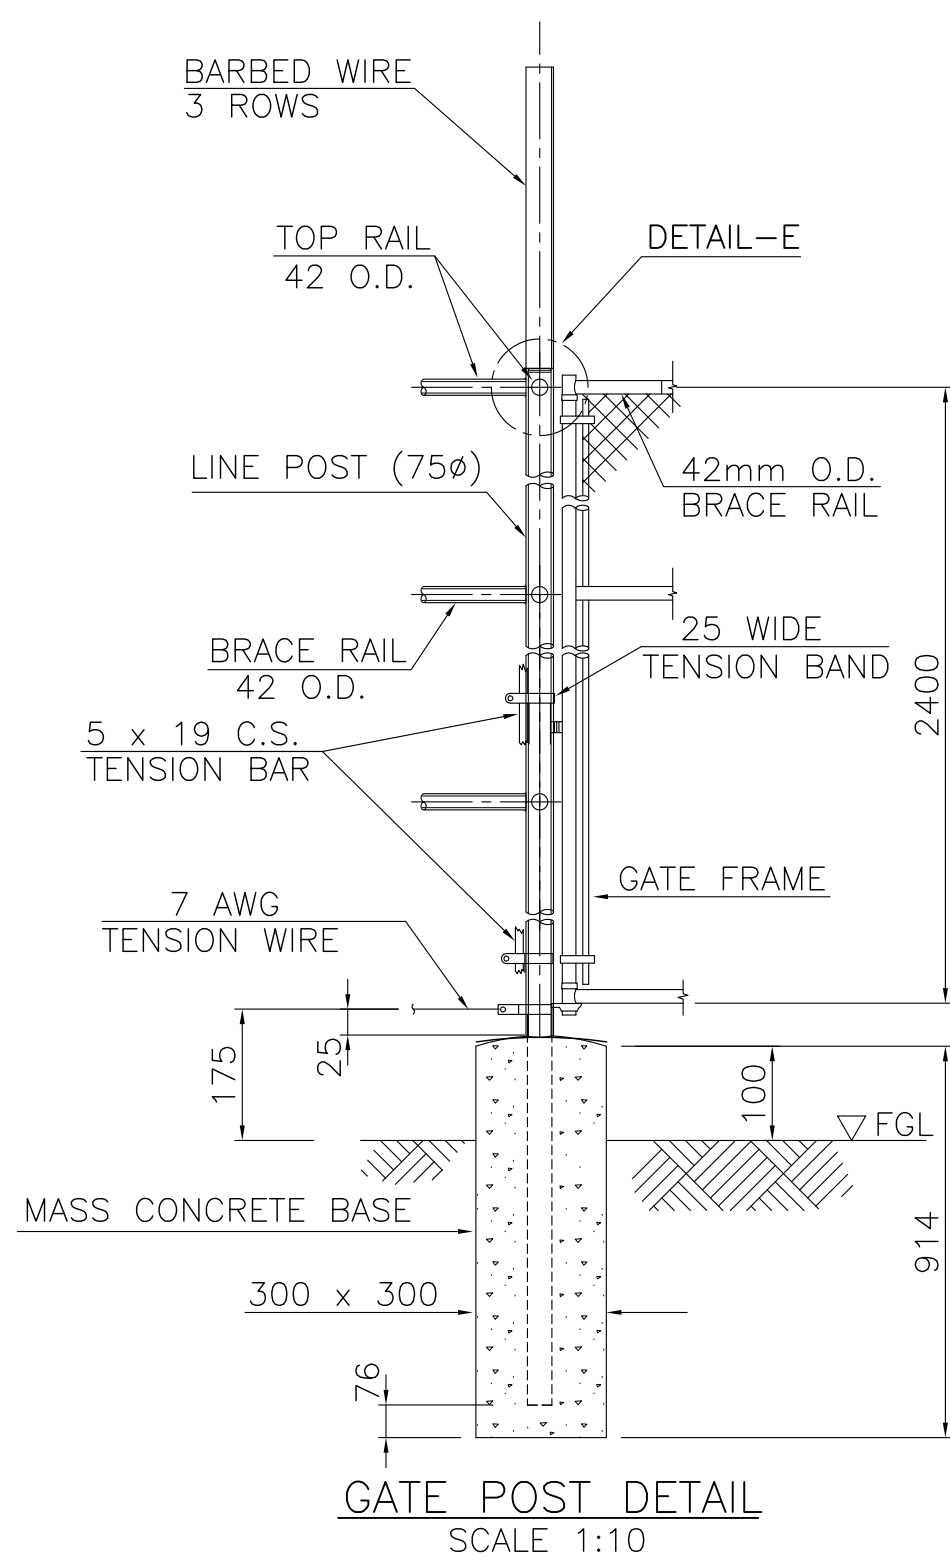
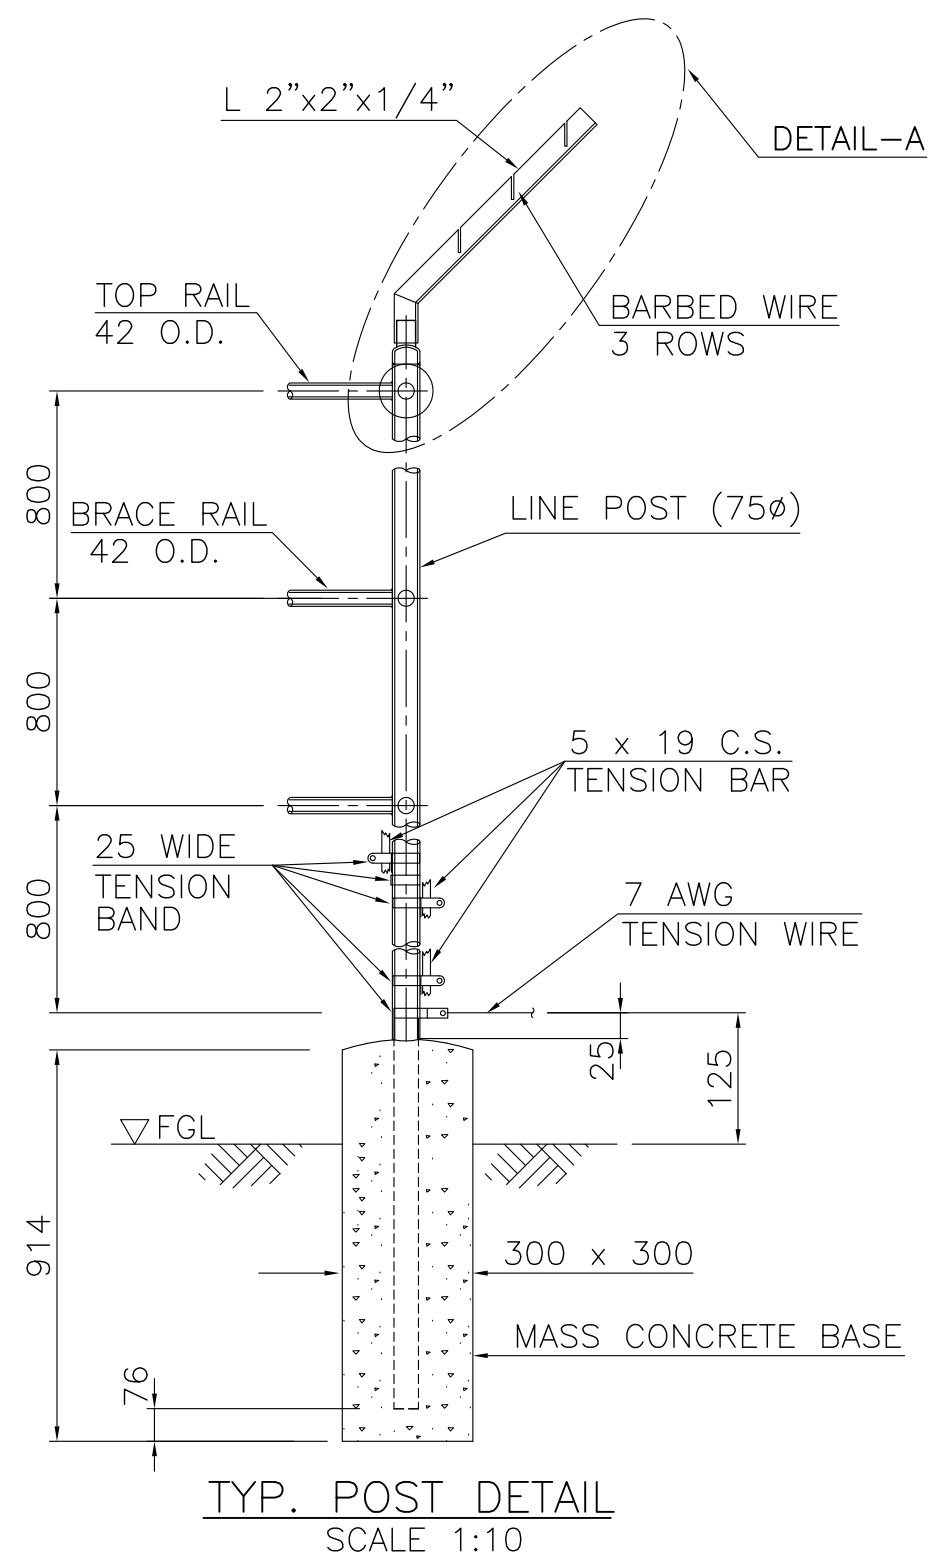
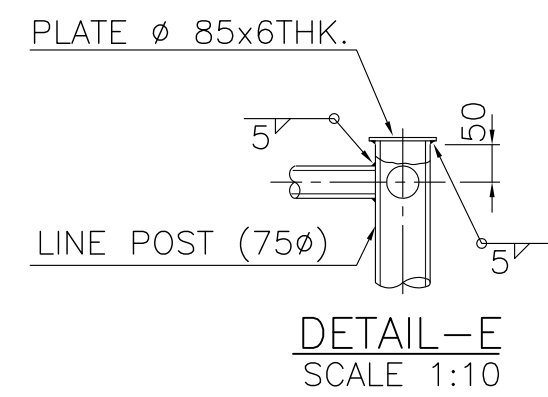
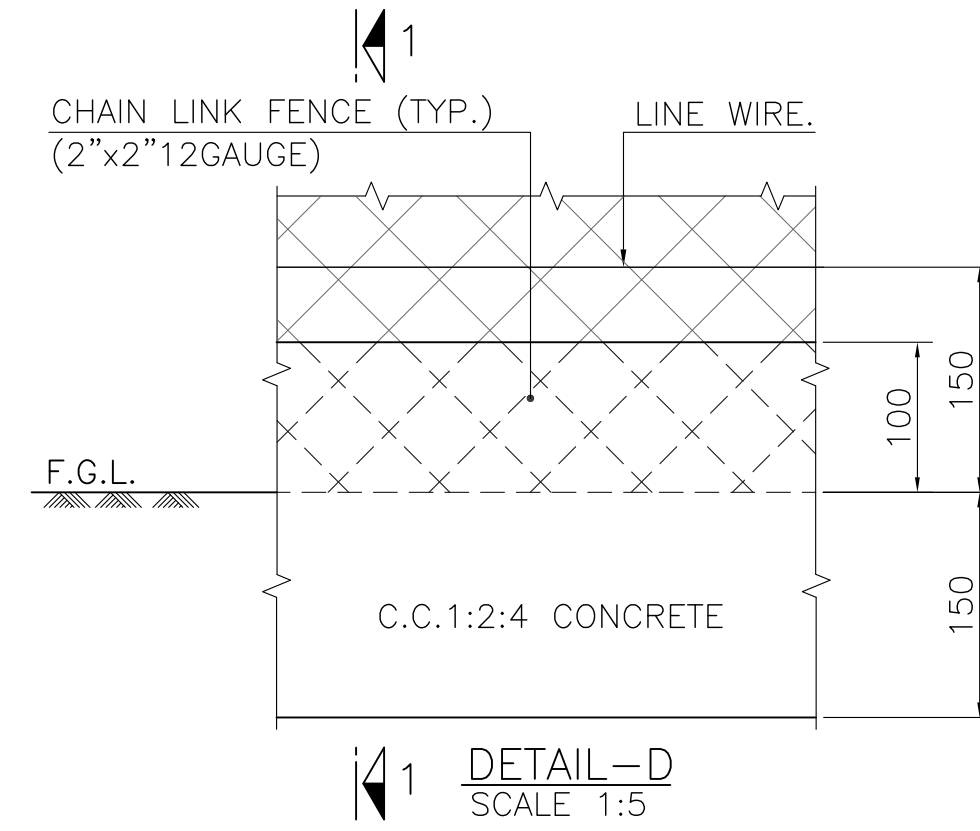
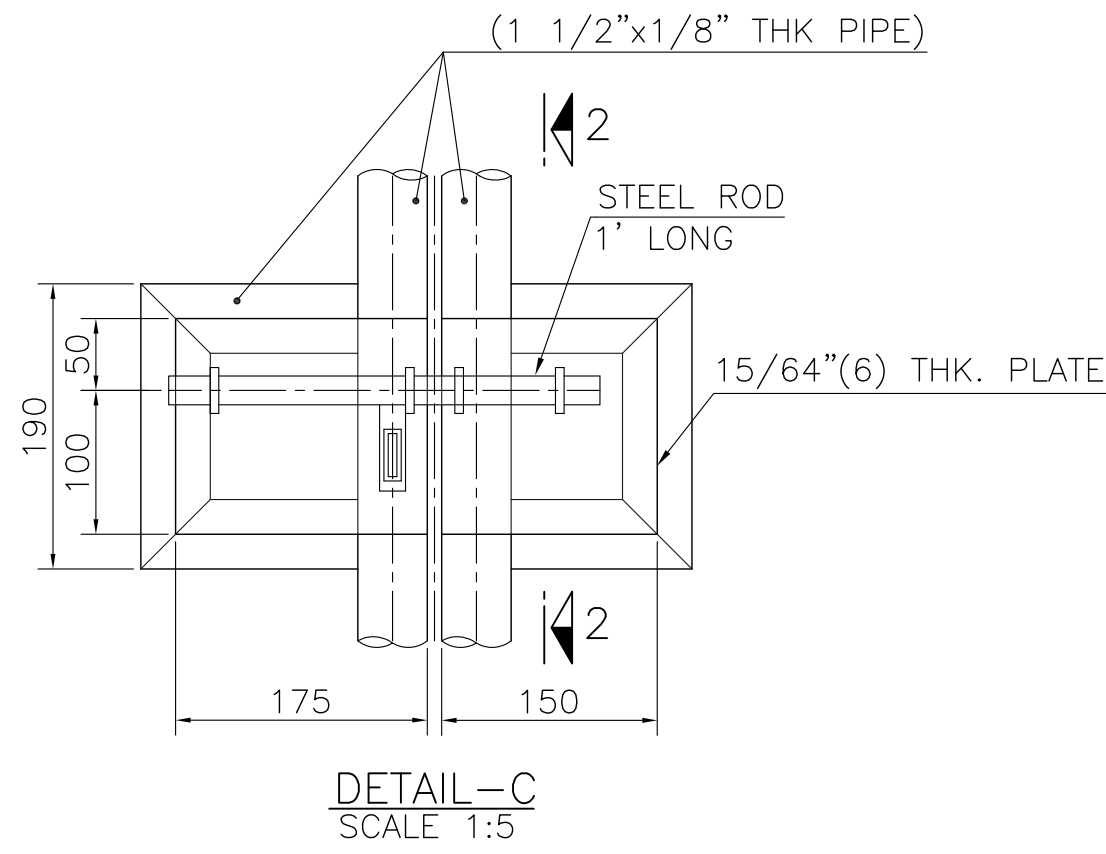
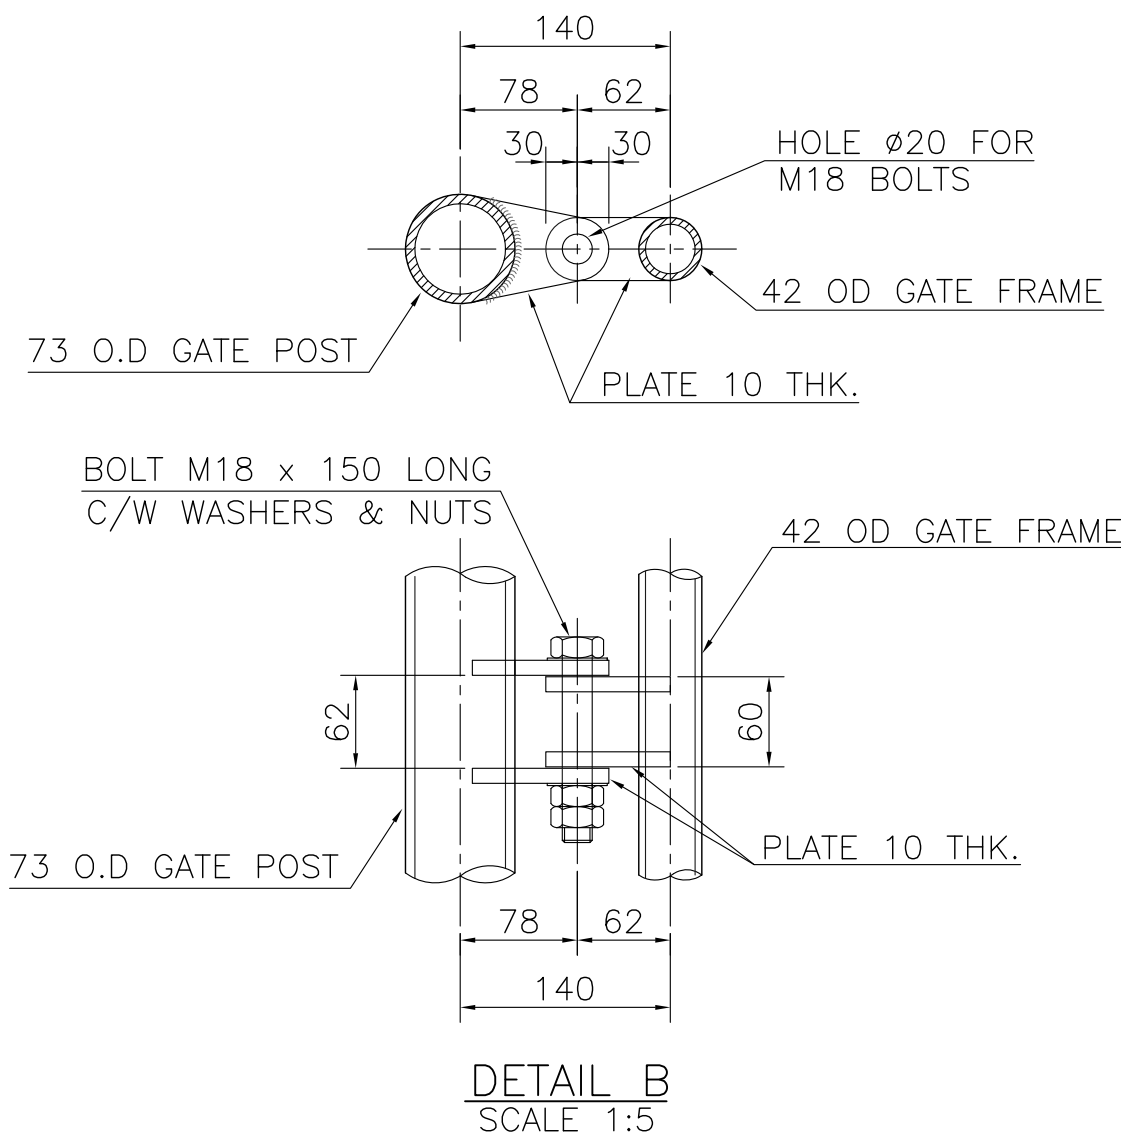
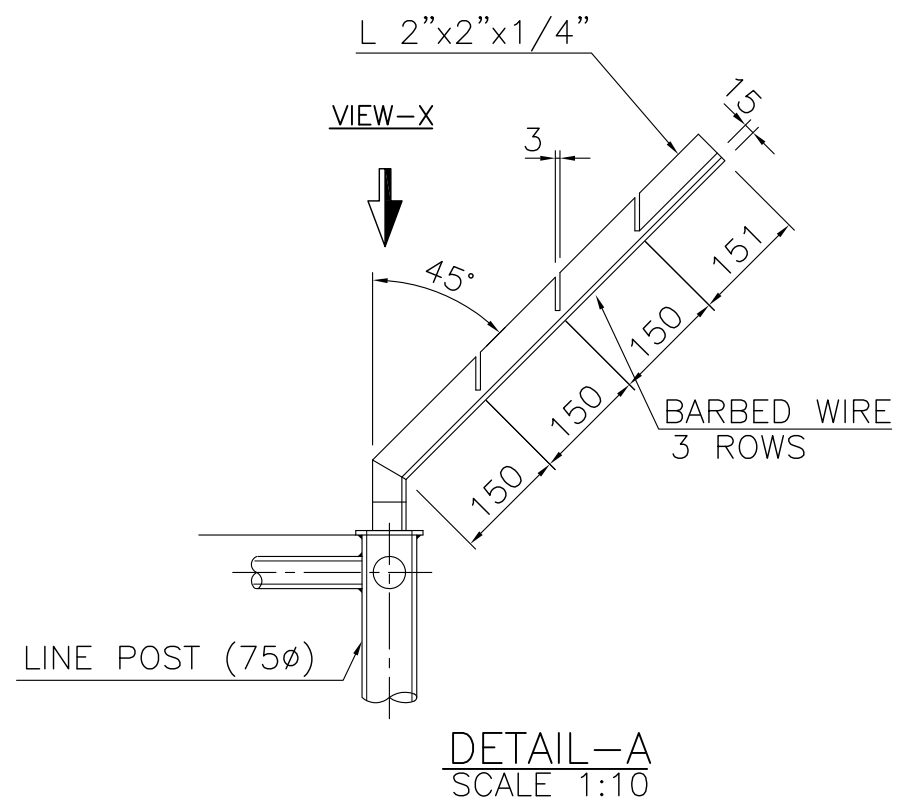


X:\165-OGDC\165-4 (KPD-TAY)\CIVIL\AS BUILT\FINAL AS BUILT\26-04-2018\DWG\CIVIL\SSTD DWGS\165-4-SSTD-029-RF0.dwg Apr 26, 2018 -- 6:07pm ZEL-COMP103

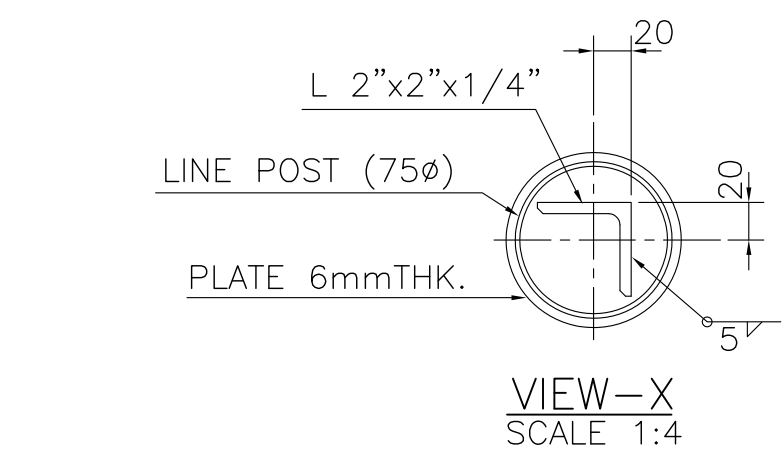

AS BUILT

NOTES:

1. THIS DRAWING SHALL BE READ IN CONJUNCTION WITH DWG. NO. 165-4-SSTD-001.
2. CONCRETE SHALL BE C.C.1:2:4.
3. THE FABRIC SHALL BE PLACED ON THE OUTWARD FACING SIDE OF THE POSTS, STRETCHED TAUT, AND FASTENED SECURELY.
4. TENSION WIRE SHALL SECURELY FASTENED TO THE TERMINAL POSTS AND BE TAUT AND FREE OF SAG.
5. FENCING DETAILS ARE TYPICAL & FOR REFERENCE ONLY THESE MAY BE MODIFIED AT SITE AS PER LOCAL AVAILABILITY OF MATERIALS AFTER APPROVAL OF OWNER'S REPRESENTATIVE.
6. PROVIDE GATE KEEPER SET IN CONCRETE TO HOLD ALL GATES OPEN 90° TO FENCE.

| | | | | | |
|--|------------|-------------------------|------------------------------------|---------|-------|
| FO | 26-04-2018 | AS BUILT | MSL | MSH | SMM |
| REV. | DATE | DESCRIPTION OF REVISION | DRAWN | CHECKED | APPR. |
| CLIENT: OIL & GAS DEVELOPMENT COMPANY LTD. OGDCL HOUSE TOWER-B, FIRST FLOOR F-6/6, BLUE AREA, JINNAH AVENUE ISLAMABAD PAKISTAN Tel: +92 051 2623033, PHONE: +92 051 9209859 | | | | | |
| CONSULTANT: Zishan Engineers (Pvt.) Ltd. An ISO 9001-2008 certified company 47/F Block 6, PECHS, Karachi-Pakistan Tel: (92-21) 3439045-46 & 34310151-54, Fax: (92-21) 34533430 & 34510156 E-Mail: contact@zishanengineers.com Website: www.zishanengineers.com | | | DWG. NO. 165-4-SSTD-029 REV. FO | | |
| PROJECT : KPD-TAY INTEGRATED DEVELOPMENT, PROJECT PHASE-II | | | JOB NO. 165-4 | | |
| TITLE : STANDARD DRAWING OF TYPICAL GATE AND FENCE | | | SIZE | SCALE | SHEET |
| | | | A1 | N.T.S. | 1 |