

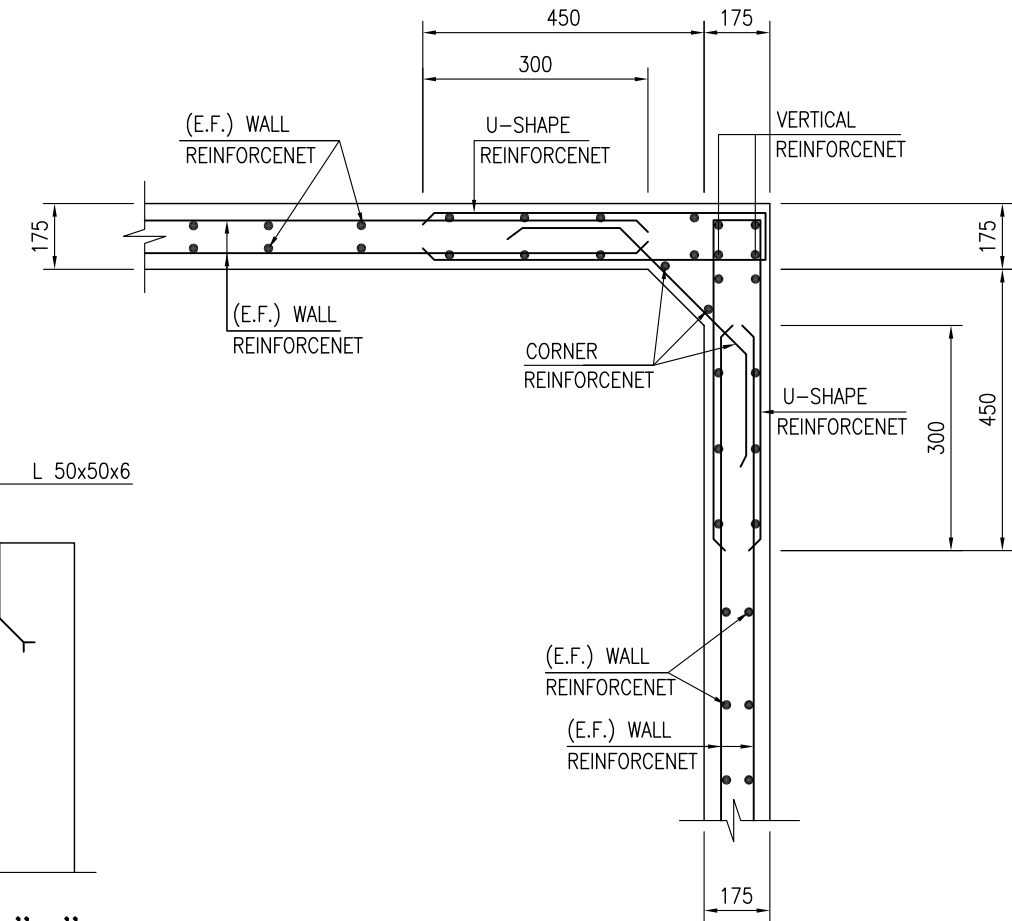
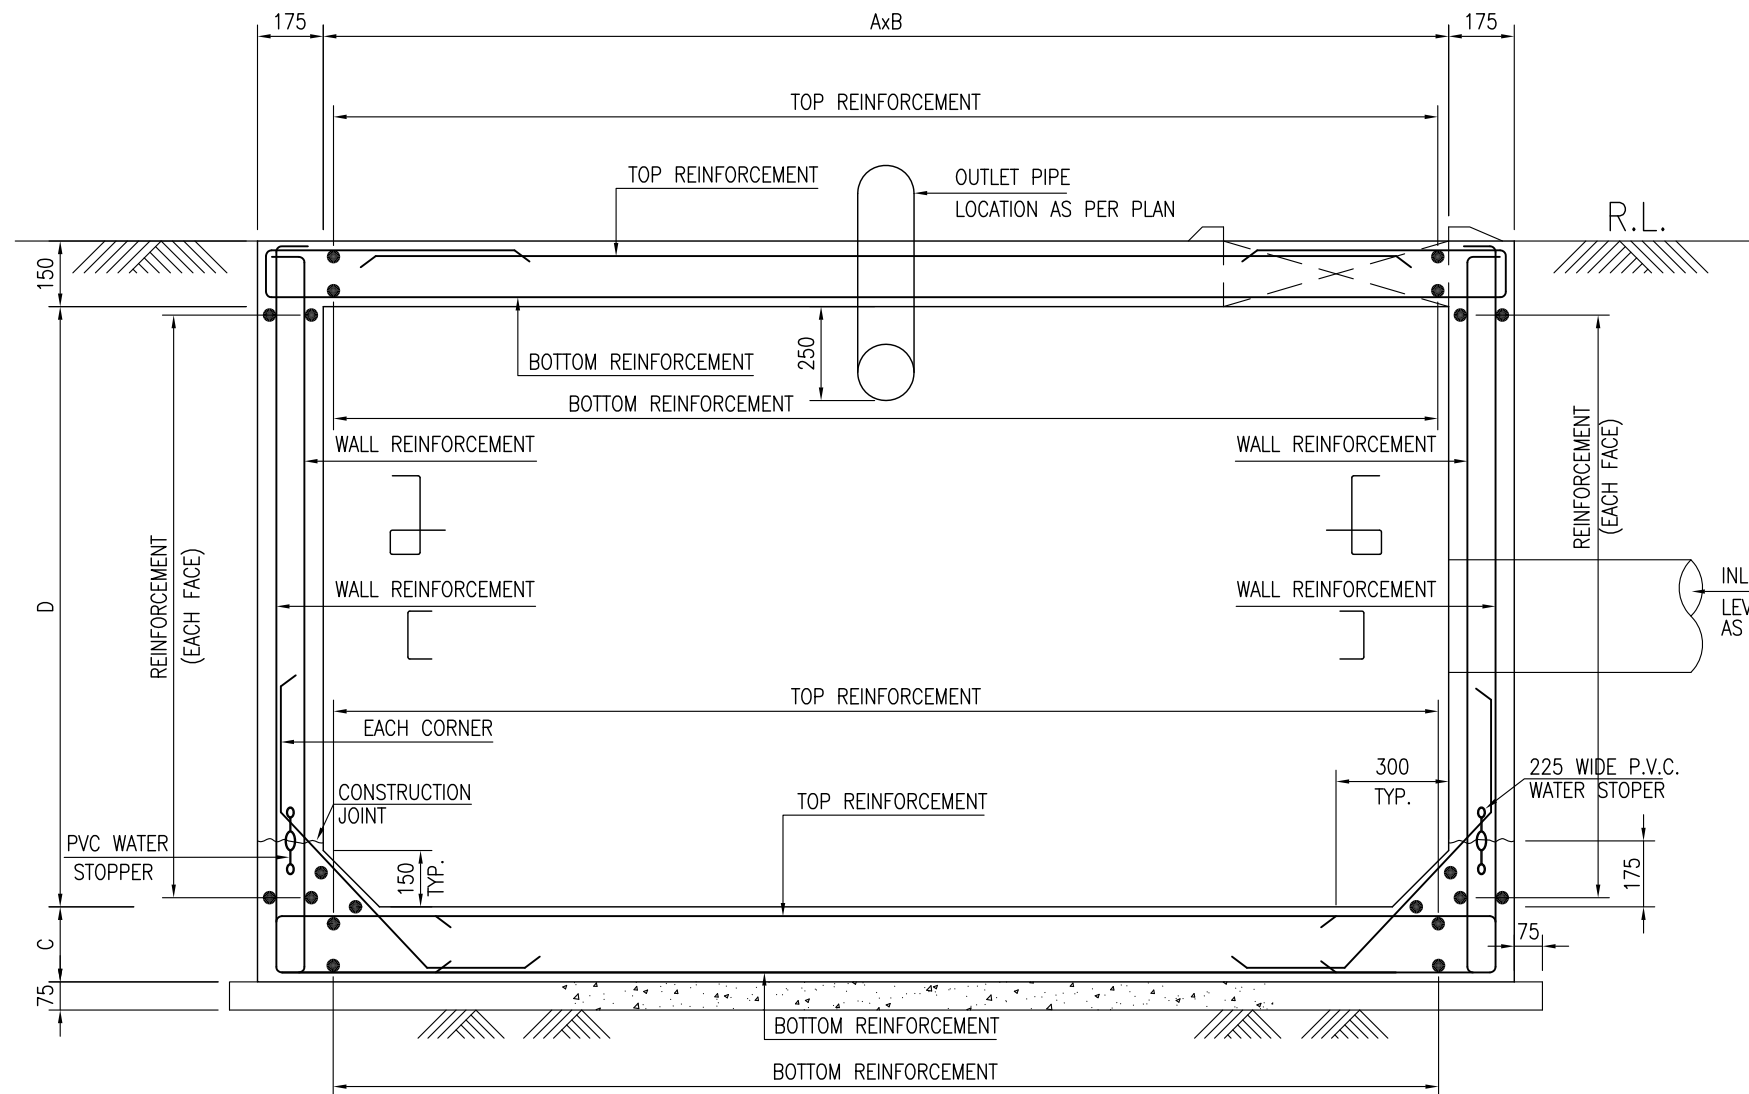
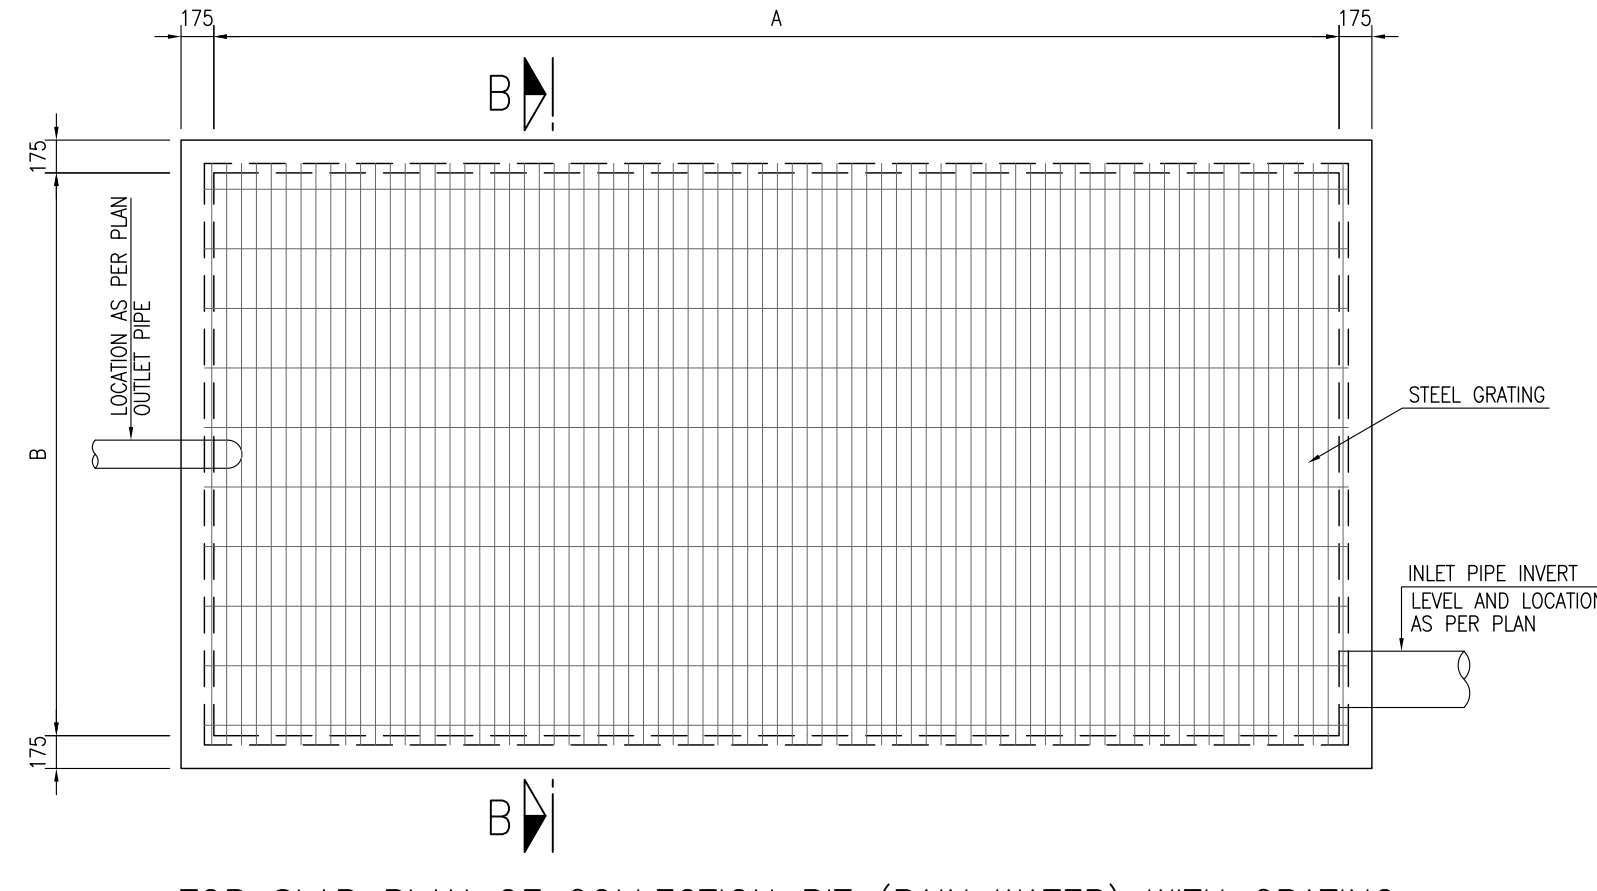
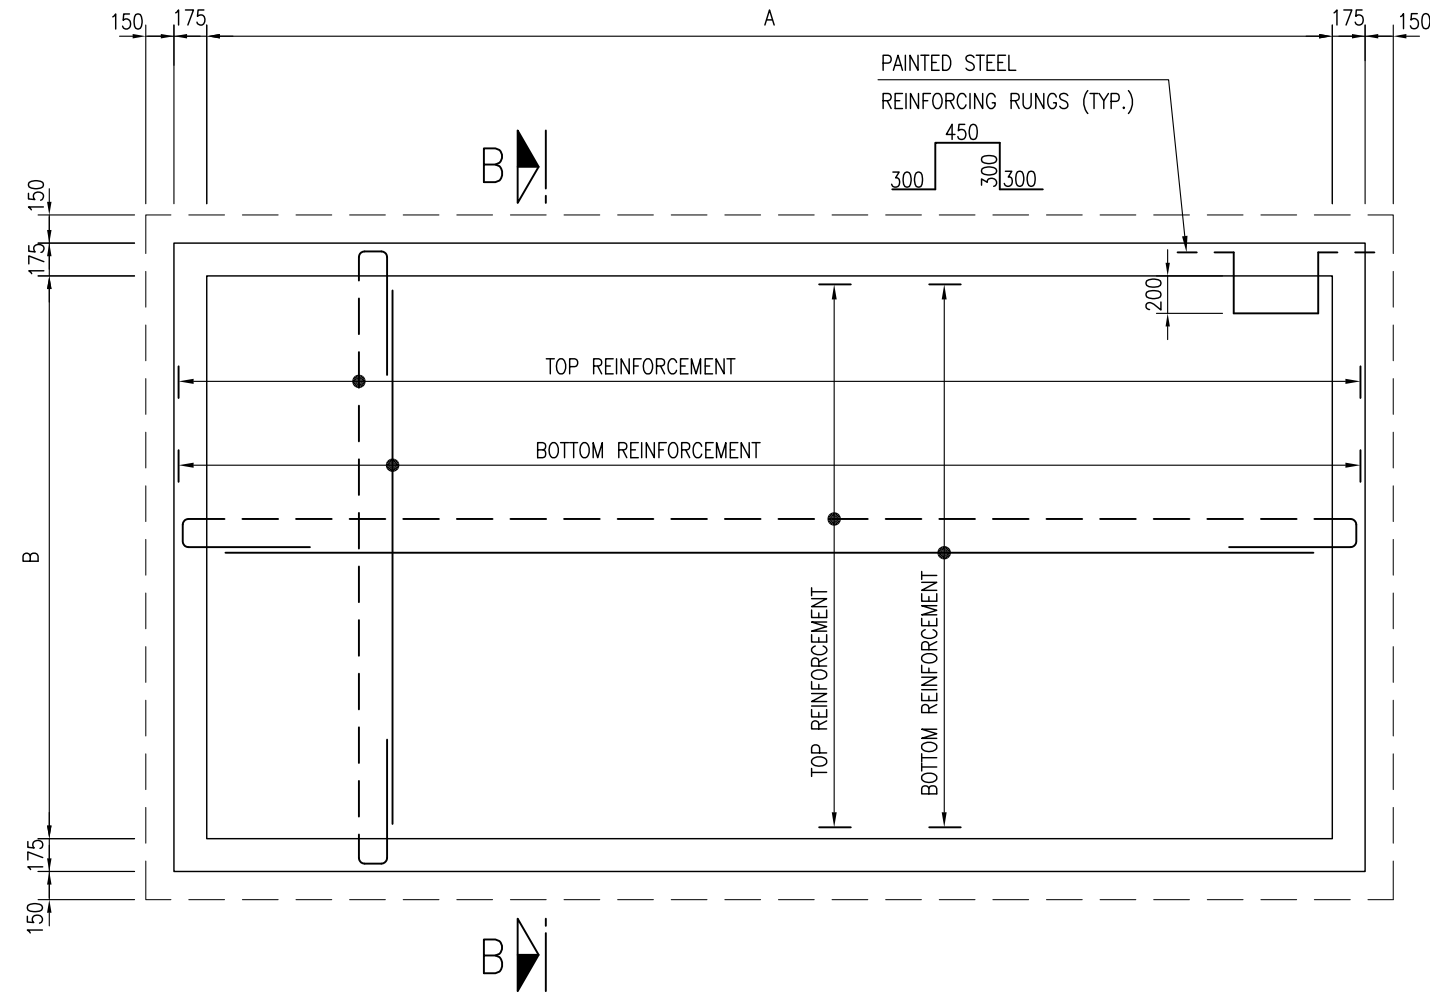
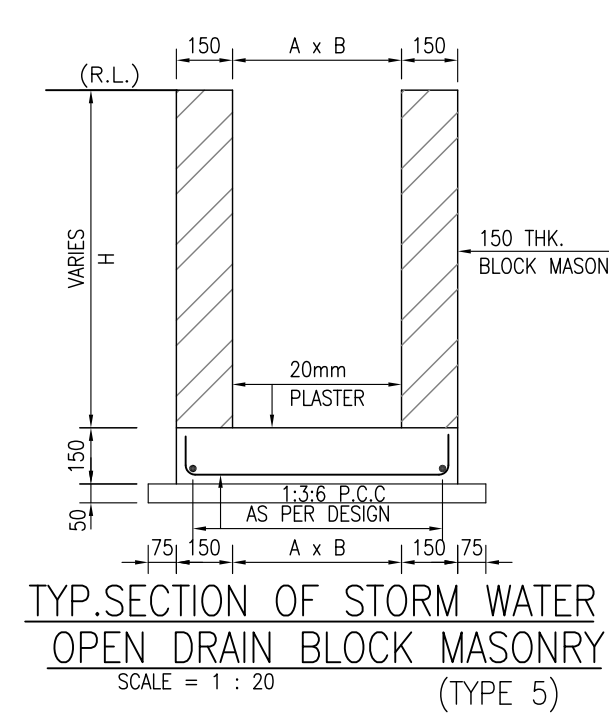
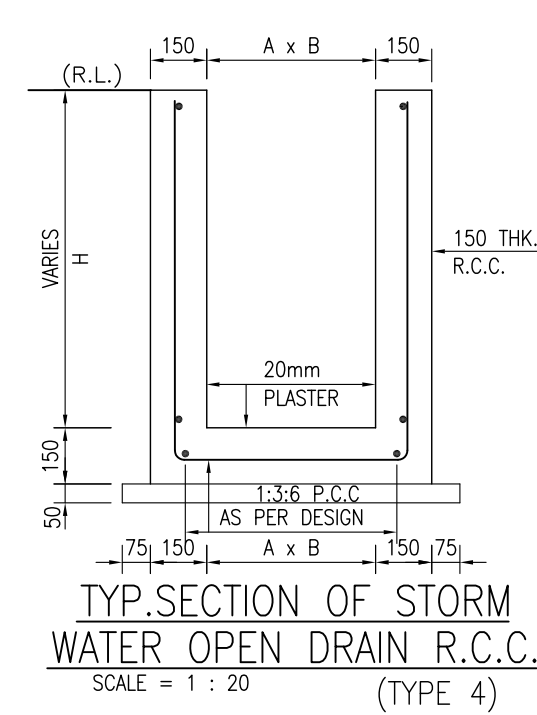
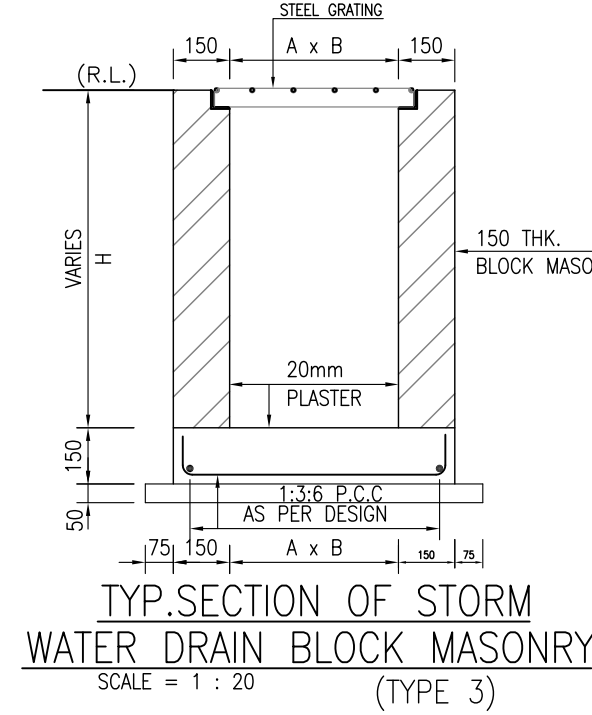
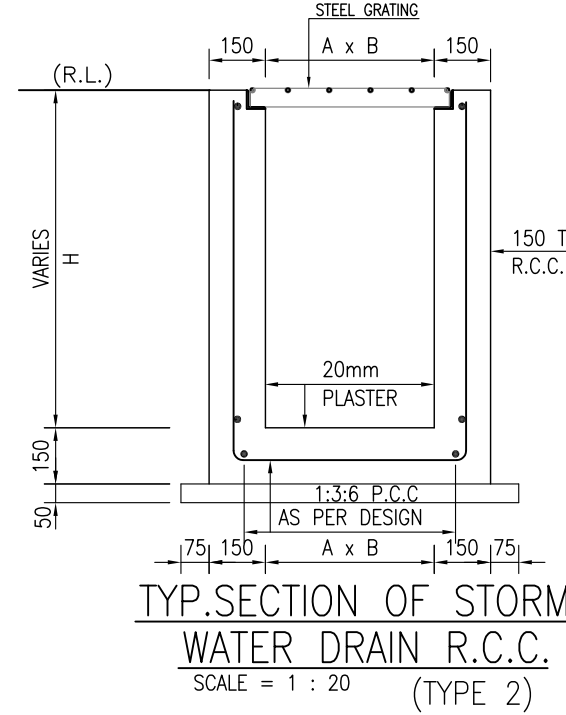



x: 1165-0000\165-4 (KPD-TAY)\CIVIL\AS BUILT\26-04-2018\DWG\CIVIL\STD DWG\165-4-CSTD-027-RFO.dwg Apr 26, 2018 - 5:57pm ZEL-COMP103

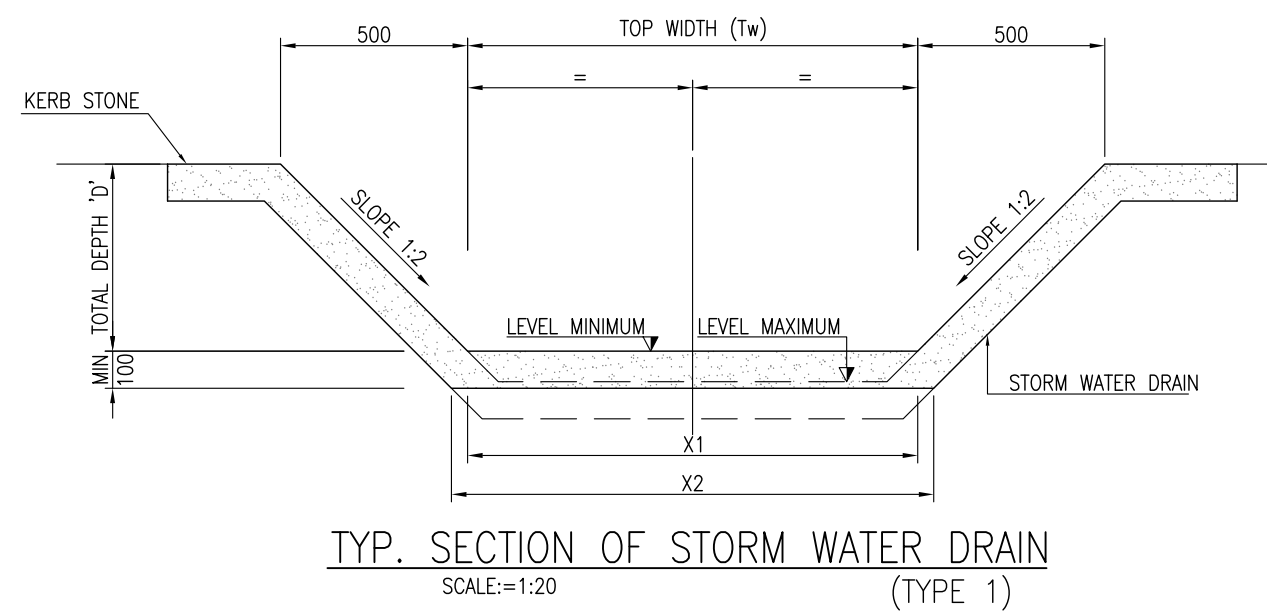


TYPICAL HORIZONTAL CORNER
DETAIL OF WALL
SCALE 1:20

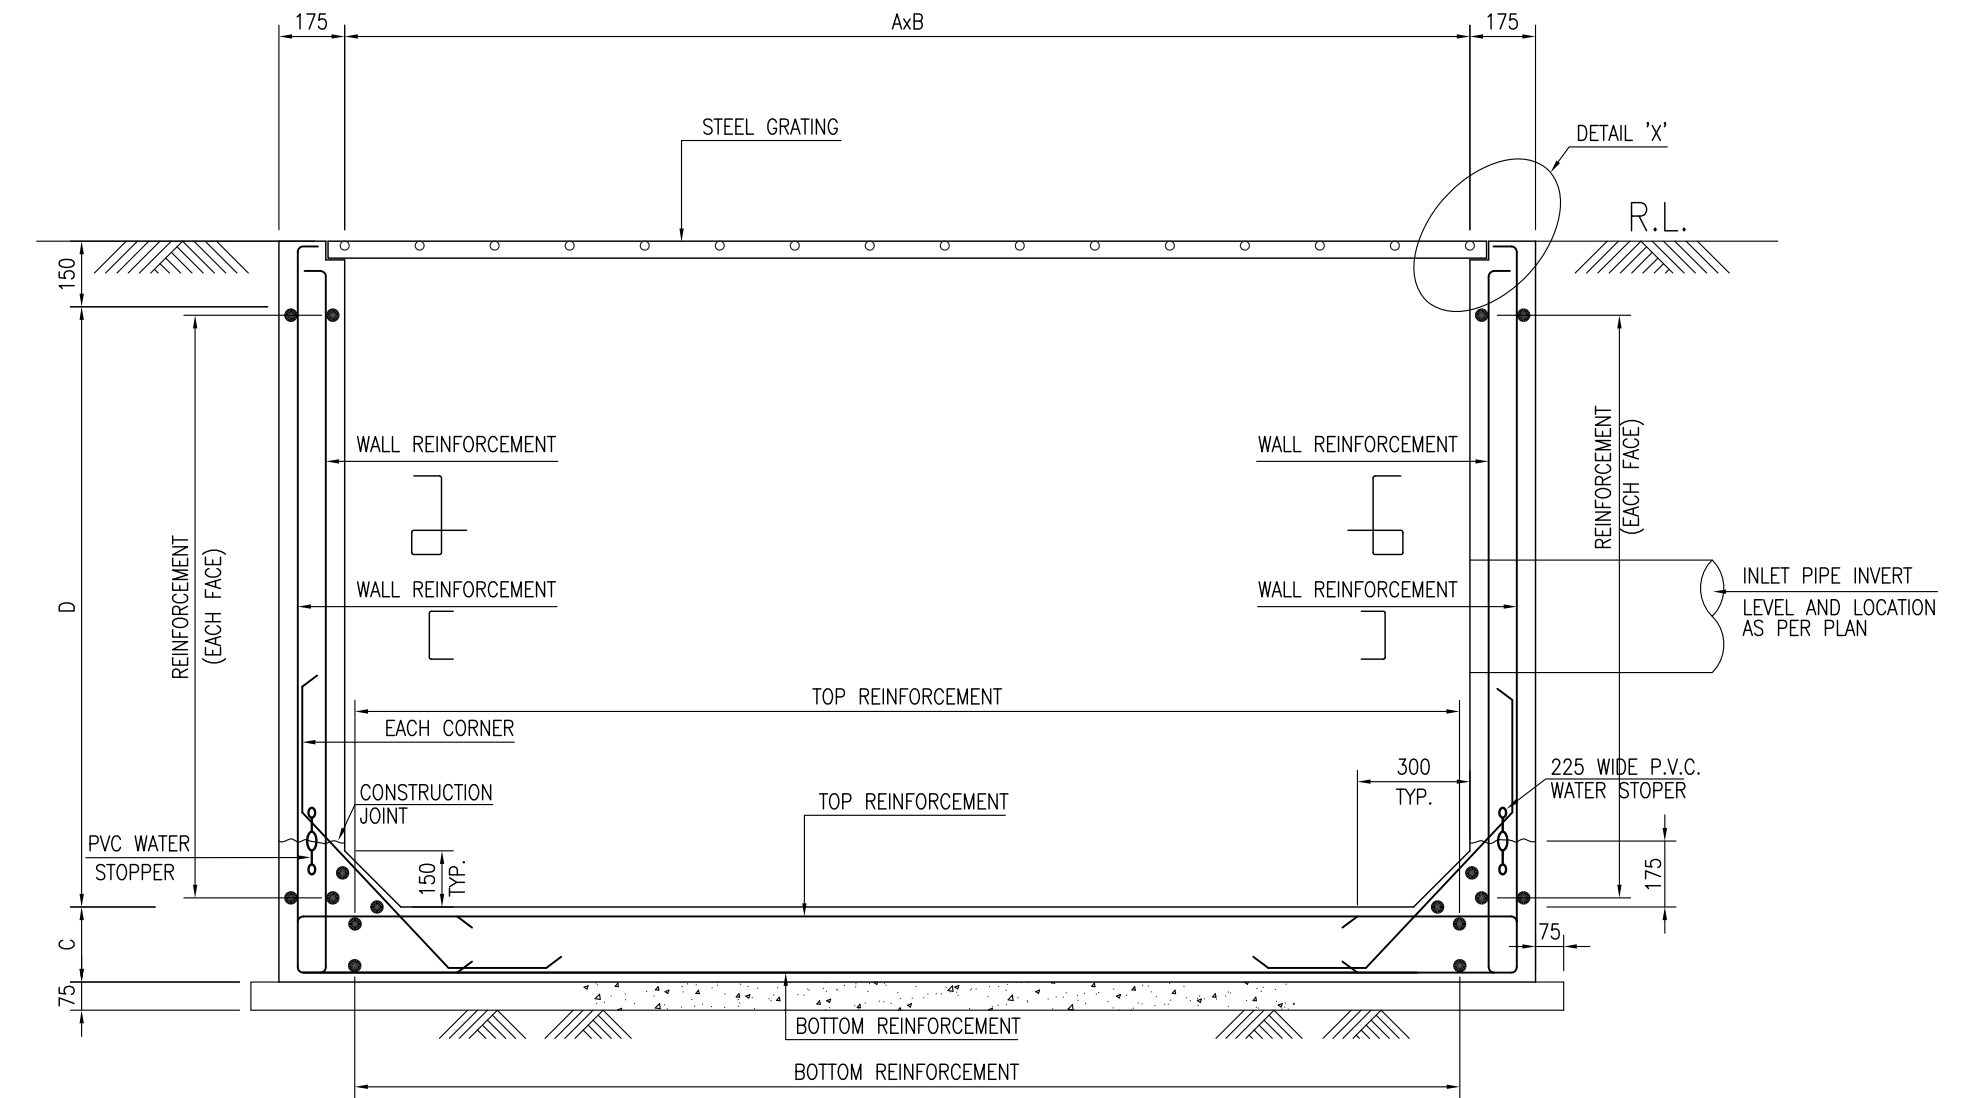


SECTION B-B
SCALE 1:20

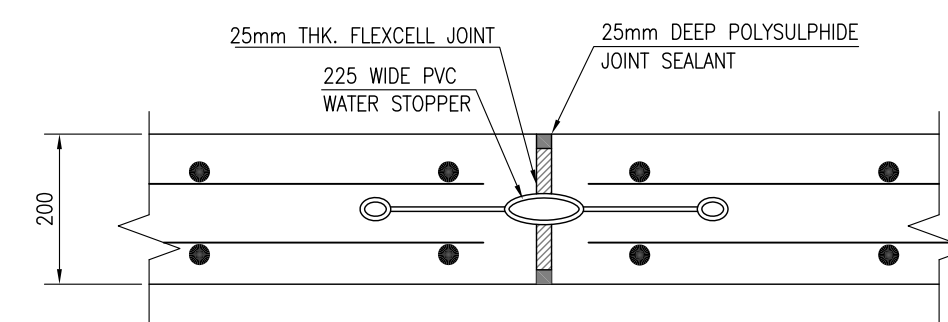


TYP. DETAIL OF EXPANSION JOINT
AT WALL
SCALE: 1:10

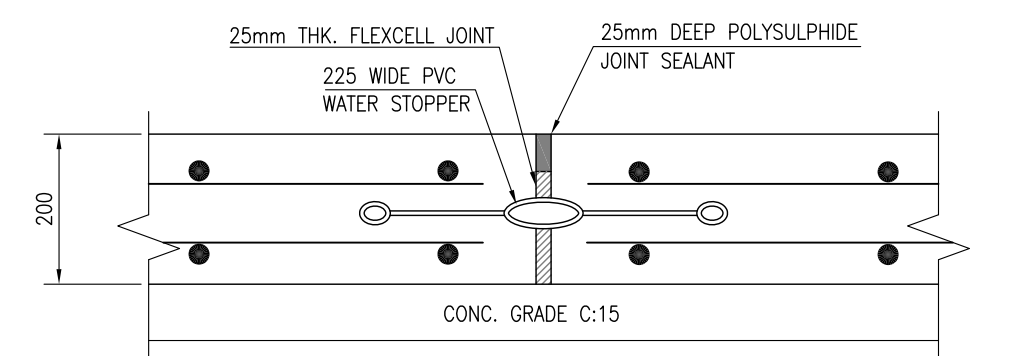


TYP. DETAIL OF EXPANSION JOINT
AT BOTTOM SLAB
SCALE: 1:10

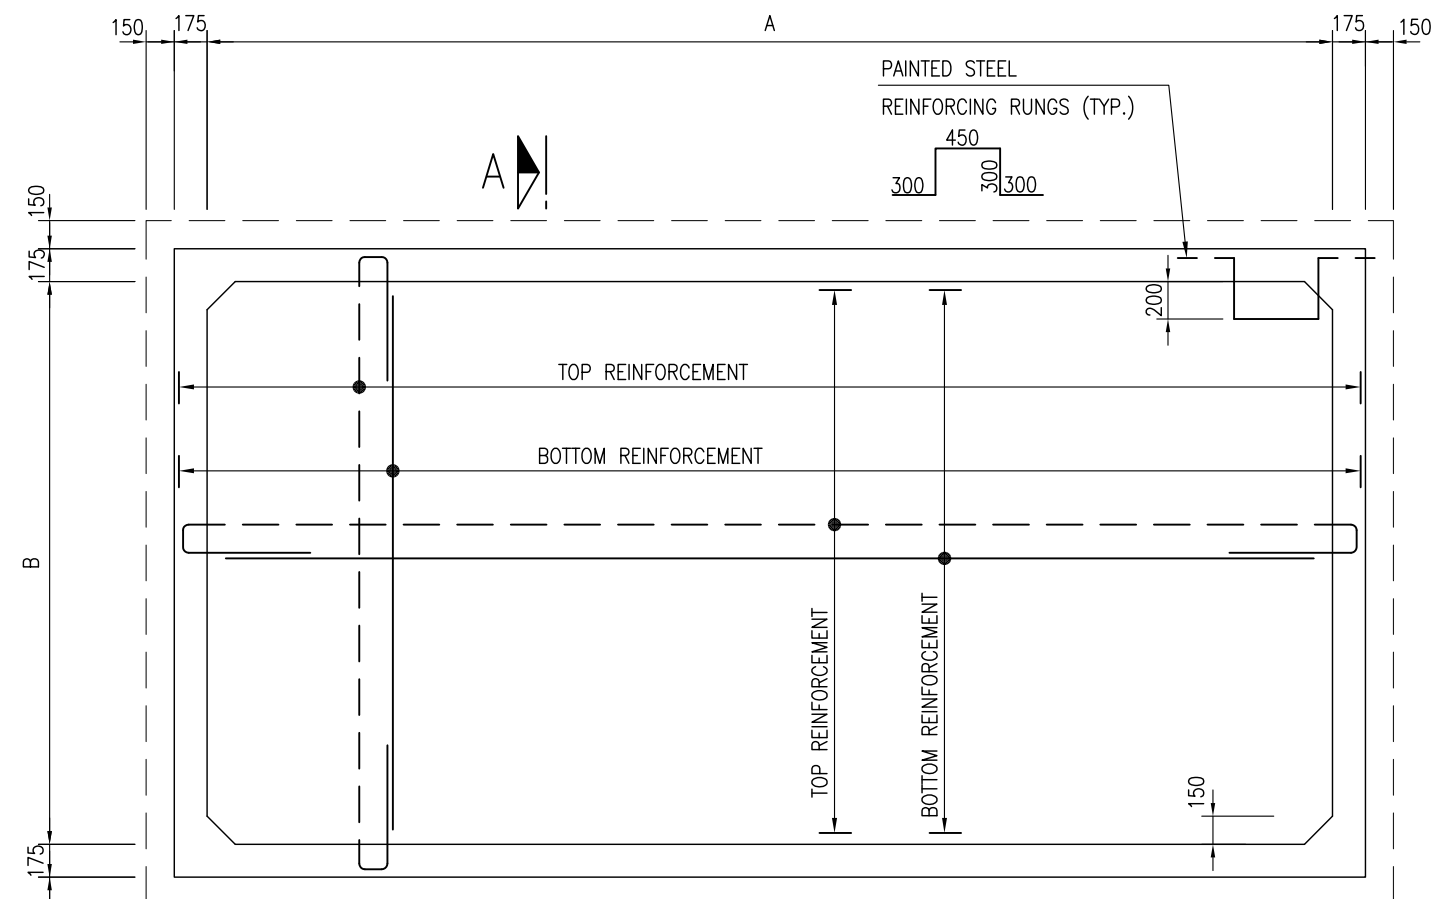

BOTTOM SLAB PLAN OF COLLECTION PIT (RAIN WATER)
SCALE 1:40

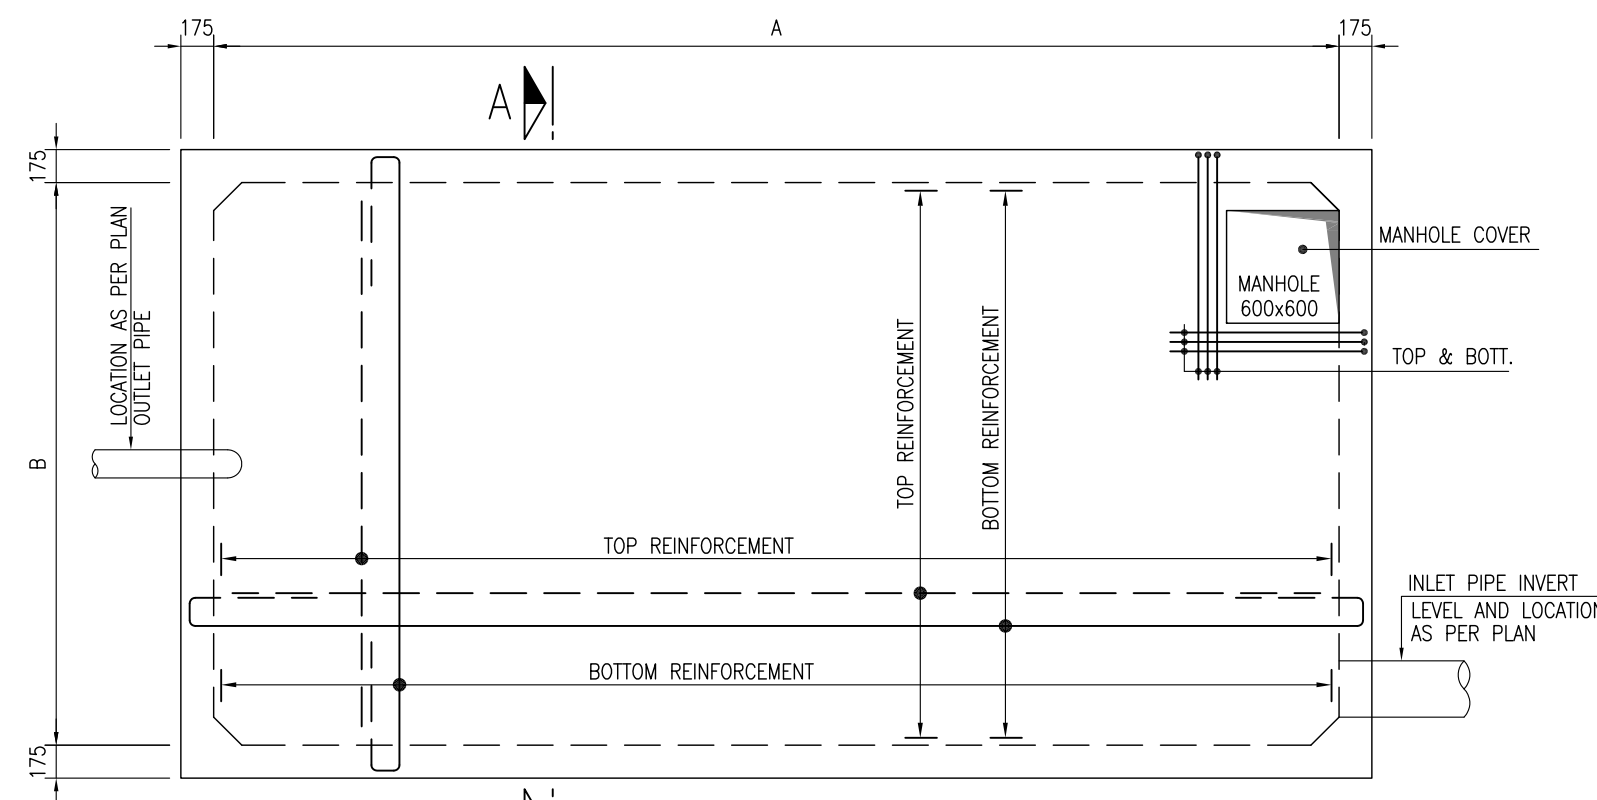

TOP SLAB PLAN OF COLLECTION PIT (RAIN WATER) WITH R.C.C. TOP
SCALE 1:40

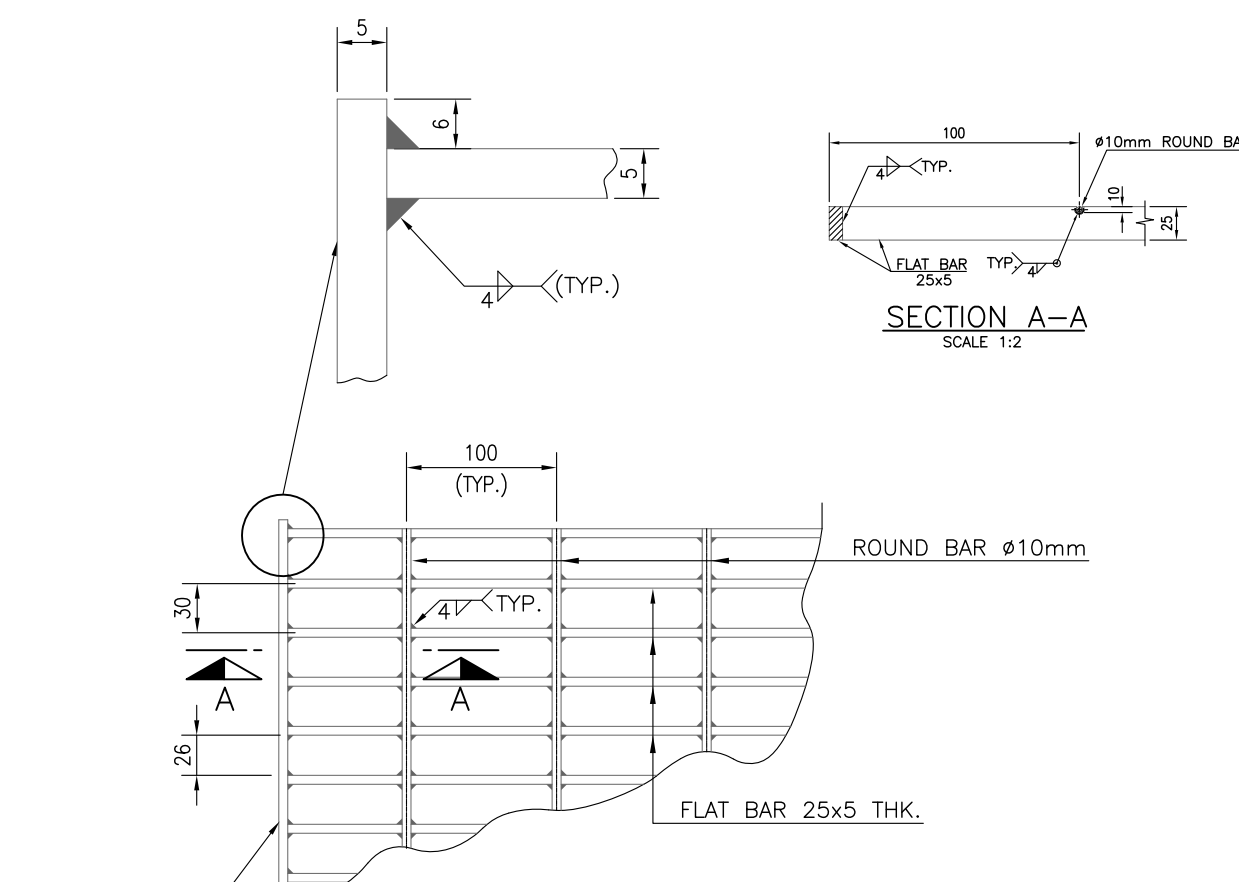

TYP. DETAIL OF GRATING
SCALE 1:5

OPEN CHANNEL SCHEDULE

SR. NO.	DRAIN TYPE	TOTAL LENGTH (L)	MIN. TOP WIDTH AT STARTING POINT (Tw)	MAX. TOP WIDTH AT END POINT (Tw)	BED SLOPE (%)	STARTING INV. LEVEL MINIMUM	TOTAL DEPTH (D)	X1	X2	A	B	H

SCHEDULE FOR COLLECTION PIT

PIT TYPE	A	B	C	D	REMARKS

NOTES:

- THIS DRAWING SHALL BE READ IN CONJUNCTION WITH DWG. NO. 165-4-CSTD-001 TO 004.

FO 26-04-2018	AS BUILT	MSL	MSH	SMM
REV.	DATE	DESCRIPTION OF REVISION	DRAWN	CHECKED
CLIENT:	OIL & GAS DEVELOPMENT COMPANY LTD.			
CONSULTANT:	Zishan Engineers (Pvt.) Ltd.			
PROJECT :	KPD-TAY INTEGRATED DEVELOPMENT, PROJECT PHASE-II			
TITLE :	STANDARD DRAWING FOR STORM WATER			
DWG. NO.	165-4-CSTD-027			
REV. FO	165-4			
JOB NO.	165-4			
SIZE	SCALE	SHEET		
A1	N.T.S.	1		

AS BUILT