


NOTES

1. ALL DIMENSIONS ARE IN MM UNLESS OTHERWISE STATED.


EQUIPMENT LIST

NO.	DESCRIPTION
1	WELLHEAD DAKHNI-01
2	HYDRAULIC PANEL
3	HEATER
4	CORROSION INHIBITOR
5	CHEMICAL STORAGE TANK
6	SOLAR PANEL
7	K.O BOTTLE
8	FLARE STACK HYDRAULIC PANAL

AS-BUILT

0	22/01/16	AS-BUILT	SS	AM		
REV.	DATE	DESCRIPTION	DRAWN	CHK'D	APP'VD	APP'VD
			CONSULTANT			CLIENT
<b>PC PETROCHEMICAL ENGINEERING CONSULTANTS</b> C-2, BLOCK NO. 17, GULSHAN-E-IOBAL, NEAR NATIONAL STADIUM, KARACHI-75300, PAKISTAN. TEL: +92 (21) 34827780, 34961088, FAX: +92 21 34961089, E-Mail: contact@pec.com.pk web site: www.pec.com.pk						
CLIENT  OIL & GAS DEVELOPMENT COMPANY LTD.						
PROJECT <b>AS BUILT OF DAKHNI &amp; SOGHARI WELLHEADS, PLANT INLET &amp; STORAGE AREA</b>						
TITLE <b>WELLHEAD DAKHNI-01 EQUIPMENT LAYOUT</b>						
DRAWING NO.			SHEET	SCALE	REV.	
2579-EL-301			NO. OF	1:350	0	
			1	1	A3	



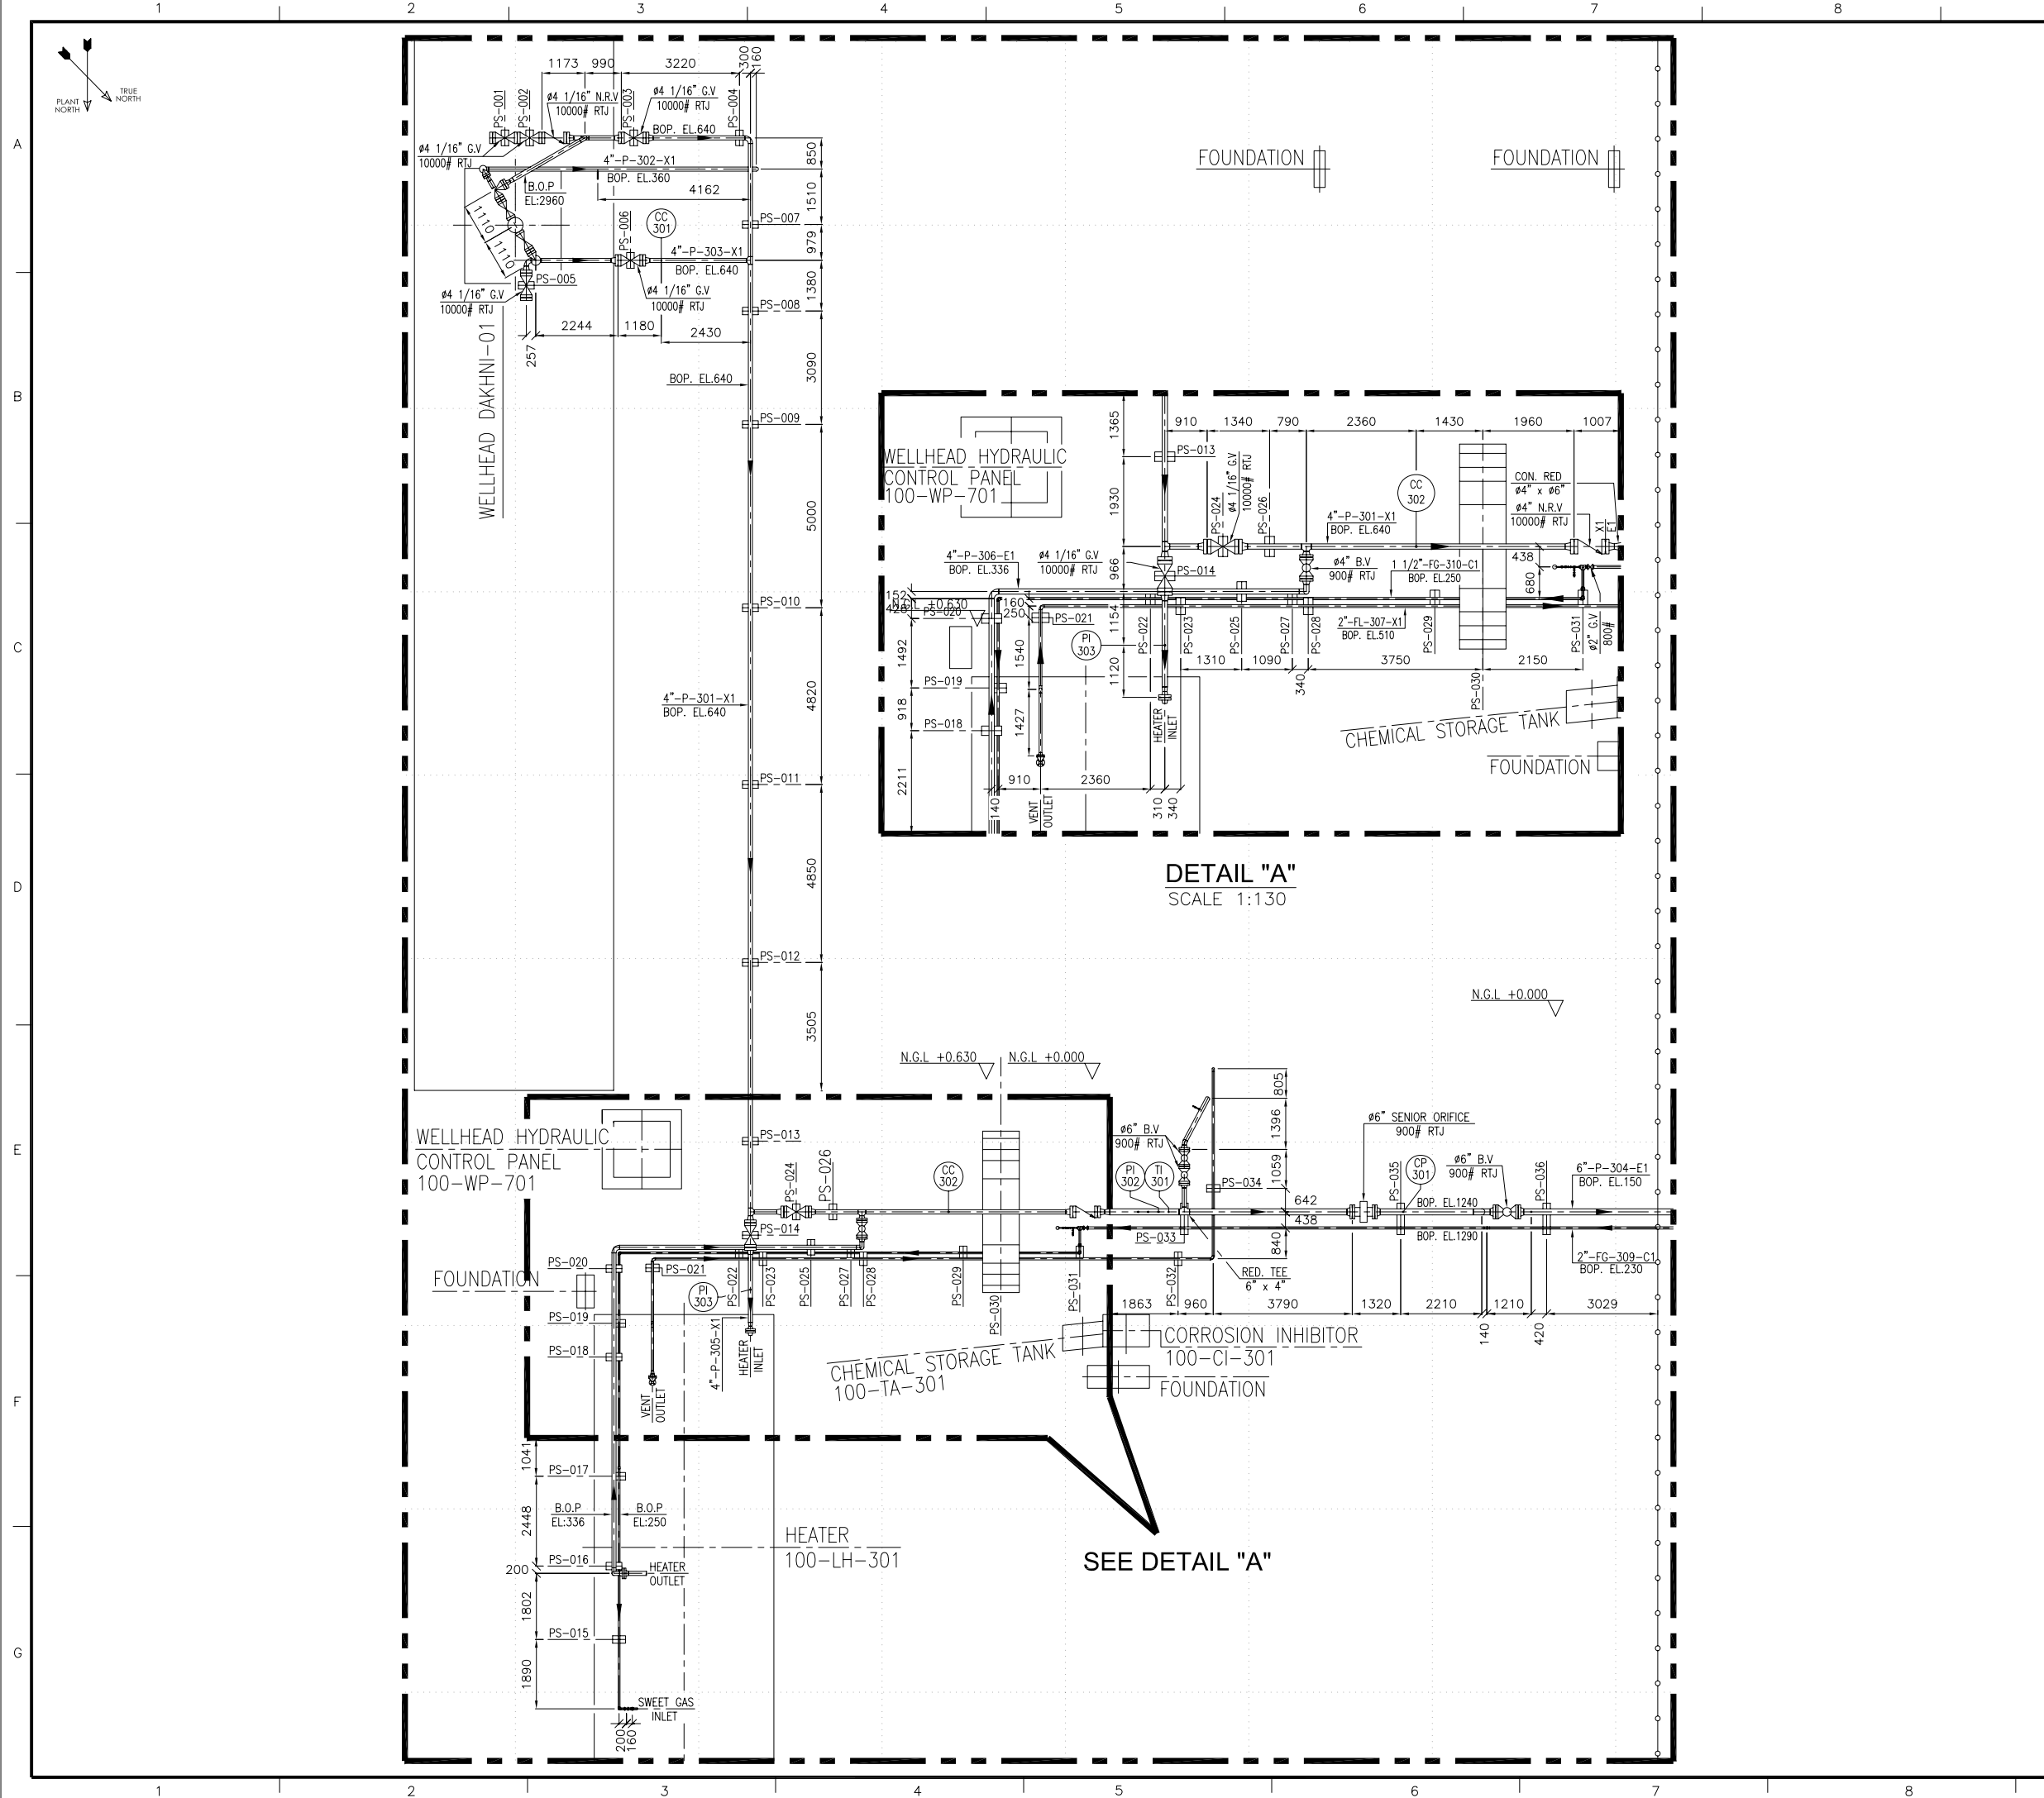

NOTES

1. ALL DIMENSIONS ARE IN MM UNLESS OTHERWISE STATED.

AS-BUILT

0	22/01/16	AS-BUILT	SS	AM		
REV.	DATE	DESCRIPTION	DRAWN	CHK'D	APP'VD	APP'VD
			CONSULTANT		CONSULTANT	CLIENT
<div><div></div><div><b>PETROCHEMICAL ENGINEERING CONSULTANTS</b> C-2, BLOCK NO. 17, GULSHAN-E-IGBAL, NEAR NATIONAL STADIUM, KARACHI-75300, PAKISTAN. TEL: +92 (21) 34827780, 34961088, FAX: +92 21 34961089, E-Mail: contact@pec.com.pk web site: www.pec.com.pk</div></div>						
CLIENT			<div><div></div><div><b>OIL &amp; GAS DEVELOPMENT COMPANY LTD.</b></div></div>			
PROJECT			AS BUILT OF DAKHNI & SOGHARI WELLHEADS, PLANT INLET & STORAGE AREA			
TITLE			WELLHEAD DAKHNI-01 PIPING LAYOUT			
DRAWING NO.				SHEET	SCALE	REV.
2579-PL-301				NO. OF	1:160	
				2	A3	0