


NOTES

1. ALL DIMENSIONS ARE IN MM UNLESS OTHERWISE STATED.

EQUIPMENT LIST	
NO.	DESCRIPTION
1	WELLHEAD DAKNI-03
2	CORROSION INHIBITOR
3	HEATER
4	SOLAR PANEL
5	HYDRAULIC PANEL
6	FIRE WATER CYLINDER PAD
7	GENERATOR PAD


AS-BUILT

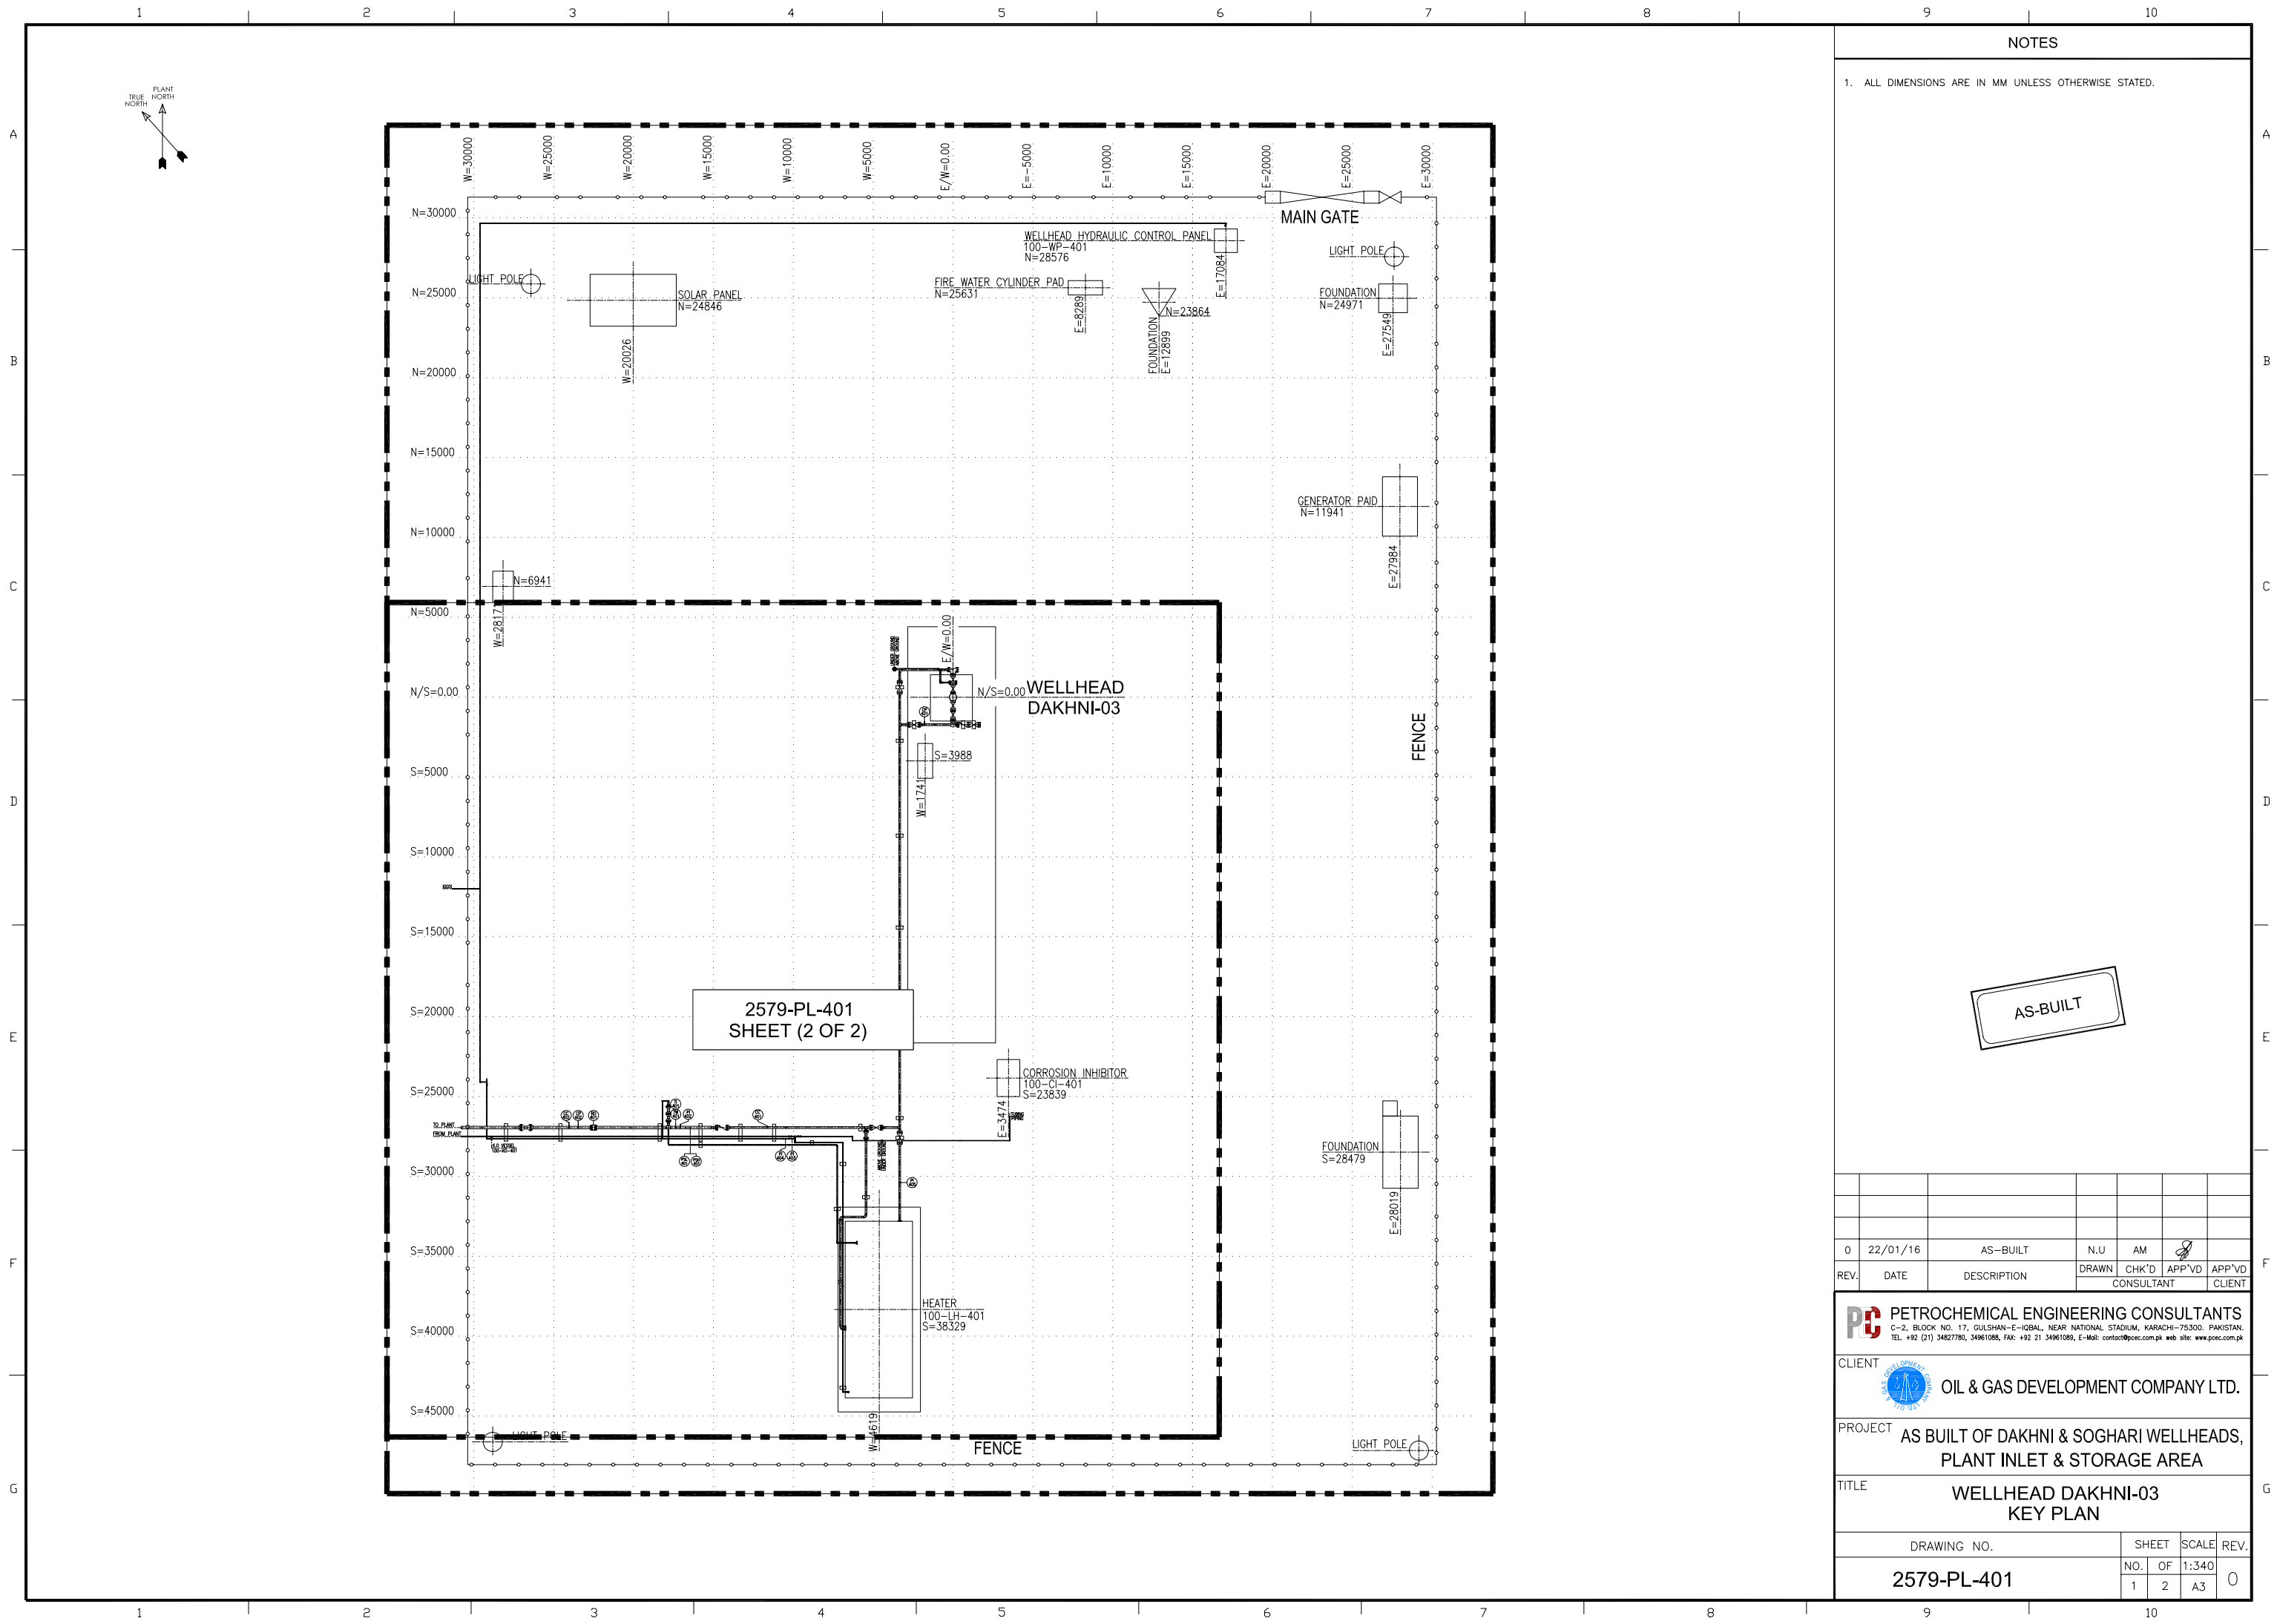

0	22/01/16	AS-BUILT	N.U	AM		
REV.	DATE	DESCRIPTION	DRAWN	CHK'D	APP'VD	APP'VD
			CONSULTANT		CONSULTANT	CLIENT
<div><div><div>PC</div><div>PETROCHEMICAL ENGINEERING CONSULTANTS</div><div>C-2, BLOCK NO. 17, GULSHAN-E-IOBAL, NEAR NATIONAL STADIUM, KARACHI-75300, PAKISTAN.</div><div>TEL: +92 (21) 34827780, 34961088, FAX: +92 21 34961089, E-Mail: contact@pec.com.pk web site: www.pec.com.pk</div></div><div><div>CLIENT</div><div><div><div></div><div>OIL &amp; GAS DEVELOPMENT COMPANY LTD.</div></div></div></div></div>						
<div><div>PROJECT</div><div>AS BUILT OF DAKHNI &amp; SOGHARI WELLHEADS, PLANT INLET &amp; STORAGE AREA</div></div>						
<div><div>TITLE</div><div>WELLHEAD DAKHNI-03 EQUIPMENT LAYOUT</div></div>						
DRAWING NO.			SHEET	SCALE	REV.	
2579-EL-401			NO. OF	1:340	0	
			1	1	A3	




NOTES

1. ALL DIMENSIONS ARE IN MM UNLESS OTHERWISE STATED.



0	22/01/16	AS-BUILT	N.U	AM					
REV.	DATE	DESCRIPTION	DRAWN	CHK'D	APP'VD	APP'VD			
			CONSULTANT			CLIENT			

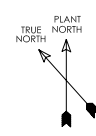	<b>PETROCHEMICAL ENGINEERING CONSULTANTS</b> C-2, BLOCK NO. 17, GULSHAN-E-IQBAL, NEAR NATIONAL STADIUM, KARACHI-75300, PAKISTAN. TEL: +92 (21) 34827780, 34961088, FAX: +92 21 34961089, E-Mail: contact@pec.com.pk web site: www.pec.com.pk															
<b>CLIENT</b>	 <b>OIL &amp; GAS DEVELOPMENT COMPANY LTD.</b>															
<b>PROJECT</b>	<b>AS BUILT OF DAKHNI &amp; SOGHARI WELLHEADS, PLANT INLET &amp; STORAGE AREA</b>															
<b>TITLE</b>	<b>WELLHEAD DAKHNI-03 KEY PLAN</b>															
<table><tr><td>DRAWING NO.</td><td>SHEET</td><td>SCALE</td><td>REV.</td></tr><tr><td rowspan="2"><b>2579-PL-401</b></td><td>NO.</td><td>OF</td><td>1:340</td></tr><tr><td>1</td><td>2</td><td>A3</td></tr><tr><td></td><td></td><td></td><td>0</td></tr></table>		DRAWING NO.	SHEET	SCALE	REV.	<b>2579-PL-401</b>	NO.	OF	1:340	1	2	A3				0
DRAWING NO.	SHEET	SCALE	REV.													
<b>2579-PL-401</b>	NO.	OF	1:340													
	1	2	A3													
			0													



1. ALL DIMENSIONS ARE IN MM UNLESS OTHERWISE STATED

0	22/01/16	AS—BUILT	N.U	AM	<i>J</i>	
REV.	DATE	DESCRIPTION	DRAWN CONSULTANT	CHK'D	APP'VD CLIENT	APP'VD CLIENT

 <b>PETROCHEMICAL ENGINEERING CONSULTANTS</b> C-2, BLOCK NO. 17, GULSHAN-E-IOBAL, NEAR NATIONAL STADIUM, KARACHI-75300, PAKISTAN. TEL. +92 (21) 34827780, 34961085, FAX: +92 21 34961085, E-Mail: contact@pec.com.pk web site: www.pec.com				
CLIENT  <b>OIL &amp; GAS DEVELOPMENT COMPANY LTD.</b>				
PROJECT <b>AS BUILT OF DAKHNI &amp; SOGHARI WELLHEADS, PLANT INLET &amp; STORAGE AREA</b>				
TITLE <b>WELLHEAD DAKHNI-03 PIPING LAYOUT</b>				
DRAWING NO.		SHEET	SCALE	REV
2579-PL-401		NO.	OF	1:200
		2	2	A3
				0