
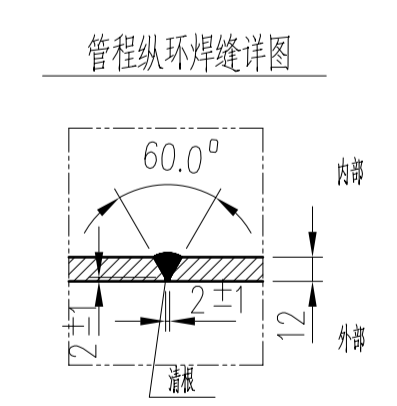
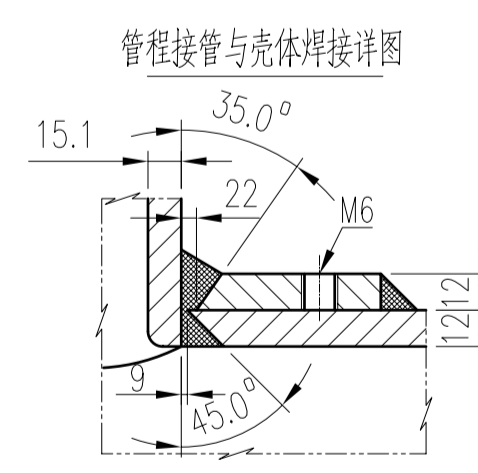
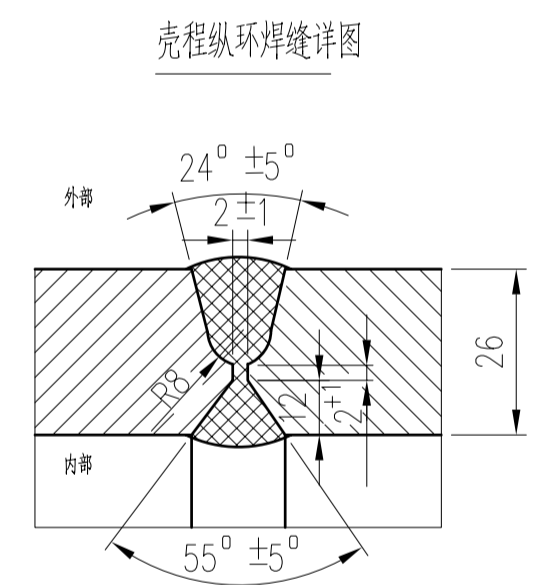
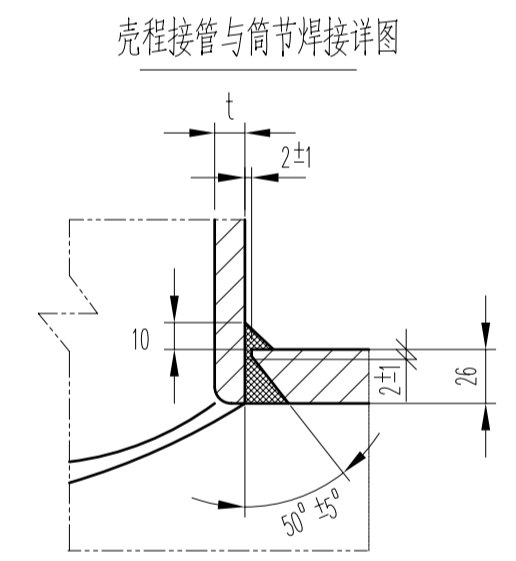
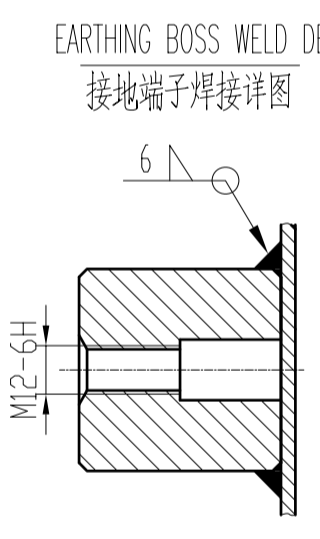
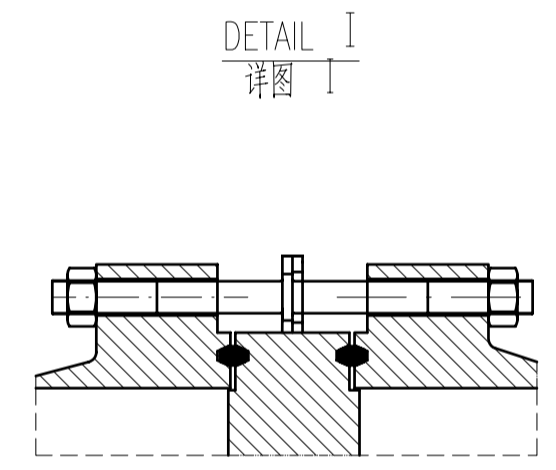
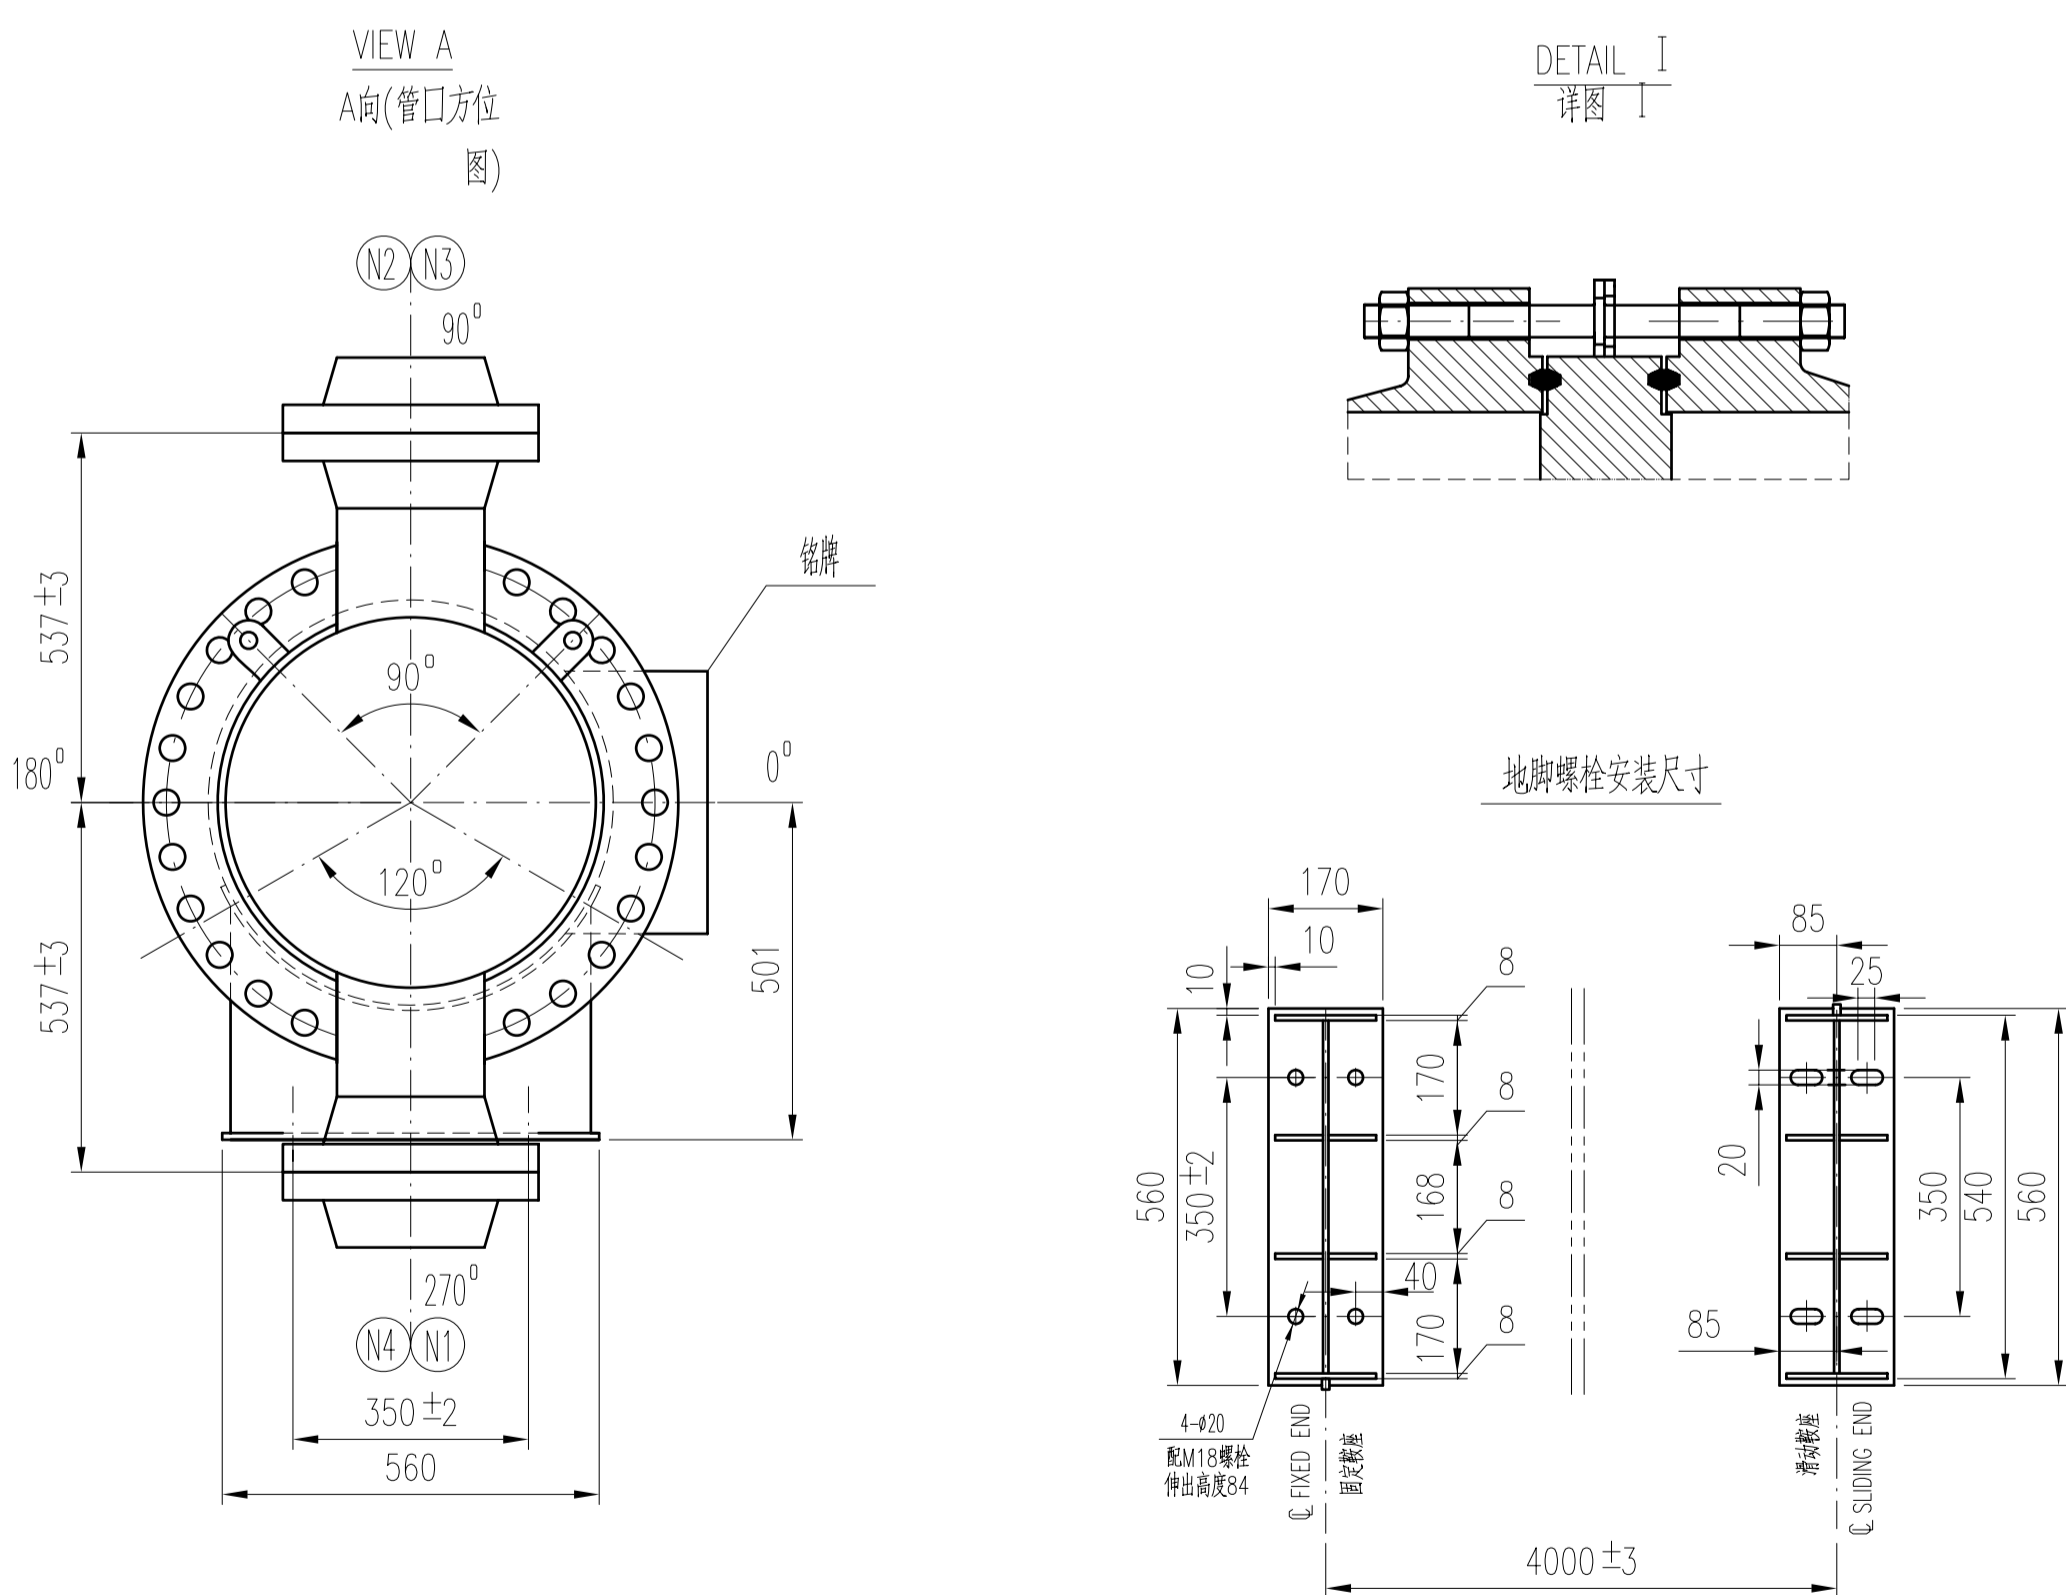
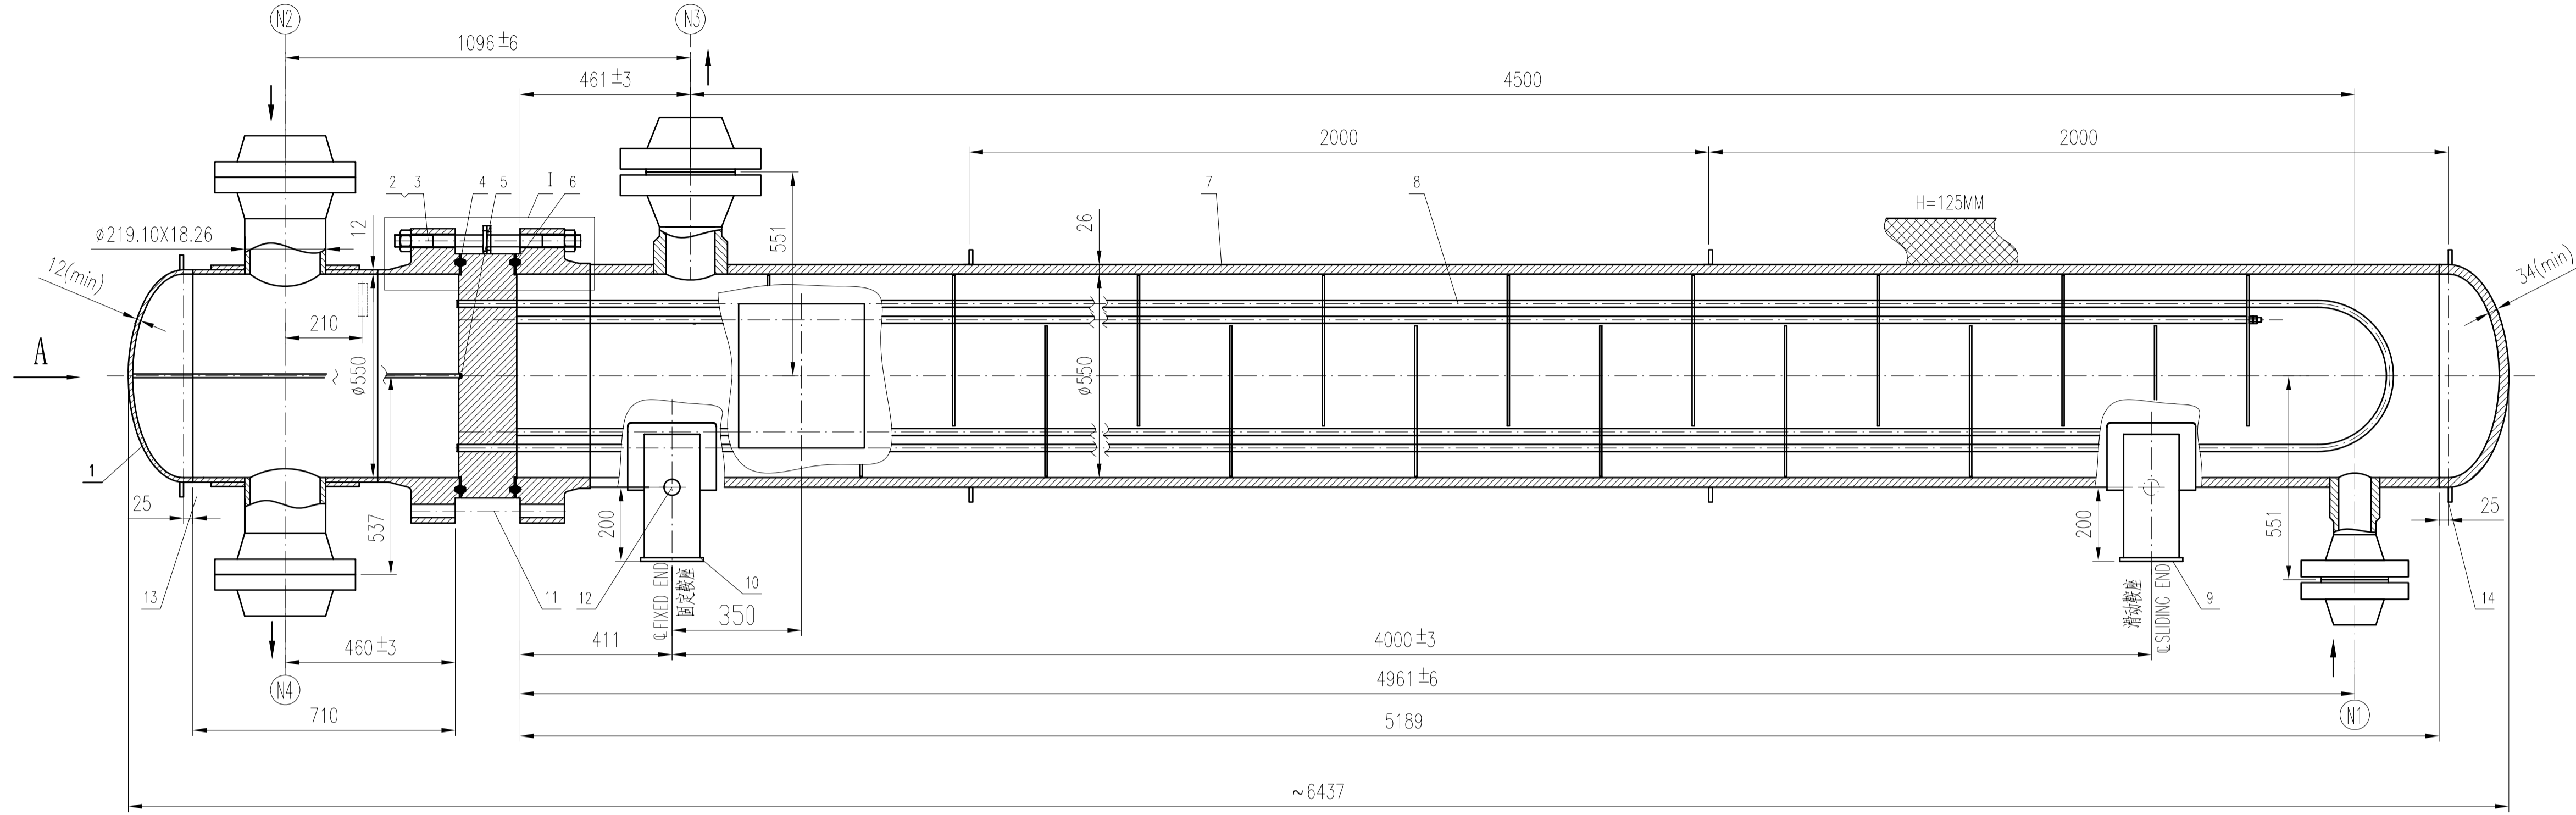
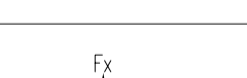


AS BUILT

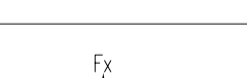

ALLOWABLE EXTERNAL LOADING OF NOZZLES 接管允许外载荷									
		NOMINAL DIAMETER	FLANGE CLASS			FORCES (kN)		MOMENTS (kN.m)	
		NPS	mm	Fx	Fy	Fz	Mx	My	Mz
	4	100	900	3.785	6.640	4.640	2.485	1.760	1.760
	6	150	900	7.250	8.880	8.880	7.185	5.080	5.080
	8	200	900	6.060	7.425	7.425	8.075	6.7	6.7

FOUNDATION DESIGN LOADS 基础设计荷载											
<div><div>Fav</div><div>ML</div><div>FvHt</div><div>FaHt</div><div>MT</div></div>		CASE	SLIDING SUPPORT				FIXED SUPPORT				
			F(kN)		M(kN.m)		F(kN)		M(kN.m)		
			FaHt	Fav	MT	ML	FaHt	Fav	MT	ML	
			FaHt	Fav	MT	ML	FaHt	Fav	MT	ML	
WIND		0.409	2.611	/	1.31	0.205	0.409	2.611	/	1.31	0.205
SEISMIC		4.418	4.418	/	2.213	2.213	4.418	4.418	/	2.213	2.213
THERMAL		17.4	/	/	/	/	17.4	/	/	/	/
EMPTY WEIGHT		/	/	29.05	/	/	/	/	22.77	/	/
OPERATING		/	/	32.50	/	/	/	/	25.50	/	/
TEST		/	/	37.35	/	/	/	/	29.29	/	/