



**OIL & GAS DEVELOPMENT COMPANY LIMITED**  
**UCH GAS FIELD, DERA BUGTI-BALUCHISTAN**

Annexure-A

**Schedule of Requirement**

**Tender Enquiry No. PROC (L)-WT/UCH-II (COOLING TOWER)/MECH-001/2022**

**“SUPPLY OF COOLING TOWER SHEETS & SERVICES”**

| <b>Sr.#</b> | <b>Item Description</b>   | <b>UOM</b>  | <b>Reqd. Qty.</b> |
|-------------|---|-------------|-------------------|
| 01          | <b><u>Supply of Cooling Tower Casing Sheets:</u></b><br>Material/Type: Fiberglass (FRP) Corrugated/Ribbed Sheets<br>(Machine Made Homogeneous finish both side):<br>Thickness of Sheet = 2mm, Color: Grey<br>i- 1750mm (5.74ft) x 7250mm (23.78ft); Qty: 32 Nos.<br>ii- 1750mm (5.74ft) x 2050mm (6.72ft); Qty: 32 Nos.<br>Total Area of 01 Cell: 61ft x 5.74 ft = 350 Sq.Ft<br>No. of Cell x No. of Cooling Towers: 08x02 = 16 | Square Feet | 5,600             |
| 02          | <b><u>Supply of Services:</u></b><br>Services for Replacement/Installation of Casing Sheets of Cooling Tower at OGDCL UCH-II Gas Plant<br>No. of Cooling Towers: 02,<br>No. of Cell/Cooling Tower: 08   | Lump sum    | 01 Job            |

**TERMS AND CONDITIONS (TECHNICAL):-**

1. Bidder must have minimum 05 years of experience in manufacturing/supply of similar sheets and must provide the evidence that offered sheets are being used in the different organizations for the same application.
2. GA Drawing of Cooling Tower is attached for technical/dimensional detail. If the bidder finds any ambiguity in specification, dimension or any technical detail / data, it should be clarified prior to bid submission. If needed, Bidders can visit UCH Gas Field via proper requisition well before bid submission deadlines.
3. Bidder to confirm that Sheets will be packed in secured and Transport worthy robust packing.
4. Material will be delivered at Uch Gas Field-OGDCL.
5. Inspection of material will be carried out by the OGDCL rep. at Uch Gas Field.
6. In case supplier fail to comply any of the above requirement the consignment may be deemed as rejected.
7. OGDCL, Uch Gas Field will provide fasteners/self-drill screws for fixing/installation of sheets.
8. OGDCL, Uch Gas Field will provide only accommodation to the manpower of successful bidder at Uch Gas Field site, provision of food will be contractor/supplier responsibility.
9. Provision of tools, consumables & PPE's will be the responsibility of contractor/supplier for execution of job at site.
10. Bids evaluation criteria will be full consignment wise.
11. The master set of tender documents (Local) available on OGDCL website ([www.ogdcl.com](http://www.ogdcl.com)) is the integral part of this tender.

**GENERAL TERMS AND CONDITIONS:**

- A. BIDS MUST BE SUBMITTED UNDER **SINGLE STAGE TWO ENVELOPES BIDDING SYSTEM** i.e. TECHNICAL & FINANCIAL BID SEPARATELY ON DUE DATE.
- B. FINANCIAL BIDS OF ONLY TECHNICALLY RESPONSIVE BIDDERS WILL BE OPENED PUBLICLY.
- C. AFTER TENDER OPENING "TECHNICAL BIDS" WILL BE REVIEWED. THE BIDS WILL BE BROUGHT TECHNICALLY AT PAR BY SEEKING CLARIFICATIONS. THE BIDDERS WILL **NOT** BE ASKED FOR ANY PRICE CHANGE IN THEIR FINANCIAL BIDS DUE TO CERTAIN CLARIFICATIONS AND SUBSEQUENT CHANGE IN THEIR TECHNICAL PROPOSALS. THE BIDDERS WILL **NOT** BE ALLOWED TO SUBMIT SUPPLEMENTARY PRICE PROPOSALS IN A SEPARATE SEALED ENVELOPE TO MAKE IT A PART OF THE ALREADY SUBMITTED UNOPENED FINANCIAL BIDS AND TO ADJUST THEIR QUOTED PRICE SUBSEQUENTLY AFFECTED DUE TO CHANGE IN TECHNICAL PROPOSALS.
- D. SEALED FINANCIAL BIDS OF TECHNICALLY NON-RESPONSIVE BIDDERS WILL BE RETURNED UN-OPENED.
- E. OGDCL RESERVES THE RIGHT TO REJECT ANY OR ALL THE BIDS WITHOUT ASSIGNING ANY REASON.
- F. PRICES MUST BE QUOTED IN PKR INCLUSIVE OF ALL TAXES AND DUTIES, INDICATING UNIT PRICE AND TOTAL BID PRICES. GST MUST BE QUOTED SEPARATELY ALONG WITH COPY OF GST CERTIFICATE.
- G. QUOTED PRICES SHALL BE VALID FOR **90 DAYS** FROM THE OPENING DATE OF THE TECHNICAL BID.
- H. OGDCL RESERVES THE RIGHT TO EVALUATE THE BID(S) EITHER ITEM-WISE OR FULL PASKAGE BASIS WITHOUT ASSIGNING ANY REASON. TO QOUTE COMPETITIVE PRICES FOR ALL OR ANY ITEMS ENABLE COMPANY TO DECIDE PURCHASE.
- I. THE MAXIMUM DELIVERY TIME FOR SUPPLY ITEMS INCLUDING JOB COMPLETION AT SITE IS **40 DAYS** FROM THE DATE OF RECEIPT OF FIRM PURCHASE ORDER.
- J. BIDDERS TO SUBMIT THEIR COMPANY PROFILES, EXPERIENCE OF SIMILAR SUPPLIES IN PAKISTAN ALONG WITH TECHNICAL BIDS.
- K. THE SUCCESSFUL BIDDER WILL HAVE TO SUBMIT A PERFORMANCE BOND IN THE SHAPE OF EITHER BANK GUARANTEE EQUAL TO 10% OF TOTAL VALUE OF PURCHASE/SERVICE ORDER EXCLUSIVE OF GST/PST/ICT WITHIN FIFTEEN DAYS AFTER ISSUANCE OF PURCHASE/SERVICE ORDER. (Refer clause 10 of master set of tender documents).
- L. THE MASTER SET OF TENDER DOCUMENTS (LOCAL) AVAILABLE ON OGDCL WEBSITE (WWW.OGDCL.COM) IS THE INTEGRAL PART OF THIS TENDER.



**OIL & GAS DEVELOPMENT COMPANY LIMITED**  
**PROCUREMENT DEPARTMENT (LOCAL), ISLAMABAD**  
**SCHEDULE OF REQUIREMENT**






**Mandatory Checklist**

Please confirm the compliance of the following mandatory information along with the bid(s) failing which bid(s) will not be accepted.

| Documents   | To be attached with the Technical / Financial Bids | Compliance                   |                             |
|---|--|------------------------------|-----------------------------|
|   |  | Yes <input type="checkbox"/> | No <input type="checkbox"/> |
| Original Bid Bond   | Technical Bid                                      | Yes <input type="checkbox"/> | No <input type="checkbox"/> |
| Copy of NTN Certificate   | Technical Bid                                      | Yes <input type="checkbox"/> | No <input type="checkbox"/> |
| Copy of GST Certificate   | Technical Bid                                      | Yes <input type="checkbox"/> | No <input type="checkbox"/> |
| Confirmation that the Firm is appearing FBR's Active Taxpayer List                            | Technical Bid                                      | Yes <input type="checkbox"/> | No <input type="checkbox"/> |
| Duly Signed and Stamped Annexure-A (Un-priced)  | Technical Bid                                      | Yes <input type="checkbox"/> | No <input type="checkbox"/> |
| Duly filled, signed and stamped Annexure-B  | Technical Bid                                      | Yes <input type="checkbox"/> | No <input type="checkbox"/> |
| Duly filled, signed and stamped Annexure-D  | Technical Bid                                      | Yes <input type="checkbox"/> | No <input type="checkbox"/> |
| Duly signed and stamped Annexure-L on Company's Letter Head                                   | Technical Bid                                      | Yes <input type="checkbox"/> | No <input type="checkbox"/> |
| Duly signed and stamped Annexure-M on Company's Letter Head                                   | Technical Bid                                      | Yes <input type="checkbox"/> | No <input type="checkbox"/> |
| Duly signed and stamped Annexure-N on Non-Judicial Stamp paper duly attested by Notary Public | Technical Bid                                      | Yes <input type="checkbox"/> | No <input type="checkbox"/> |
| Duly Filled, signed and stamped Annexure-A (Priced)   | Financial Bid                                      | Yes <input type="checkbox"/> | No <input type="checkbox"/> |
| Duly Filled, signed and stamped Annexure-C  | Financial Bid                                      | Yes <input type="checkbox"/> | No <input type="checkbox"/> |
| Duly Filled, signed and stamped Annexure-E  | Financial Bid                                      | Yes <input type="checkbox"/> | No <input type="checkbox"/> |



The above Annexures are available in MASTER SET OF TENDER DOCUMENTS (LOCAL) that can be downloaded from OGDCL website ([www.ogdcl.com](http://www.ogdcl.com)).



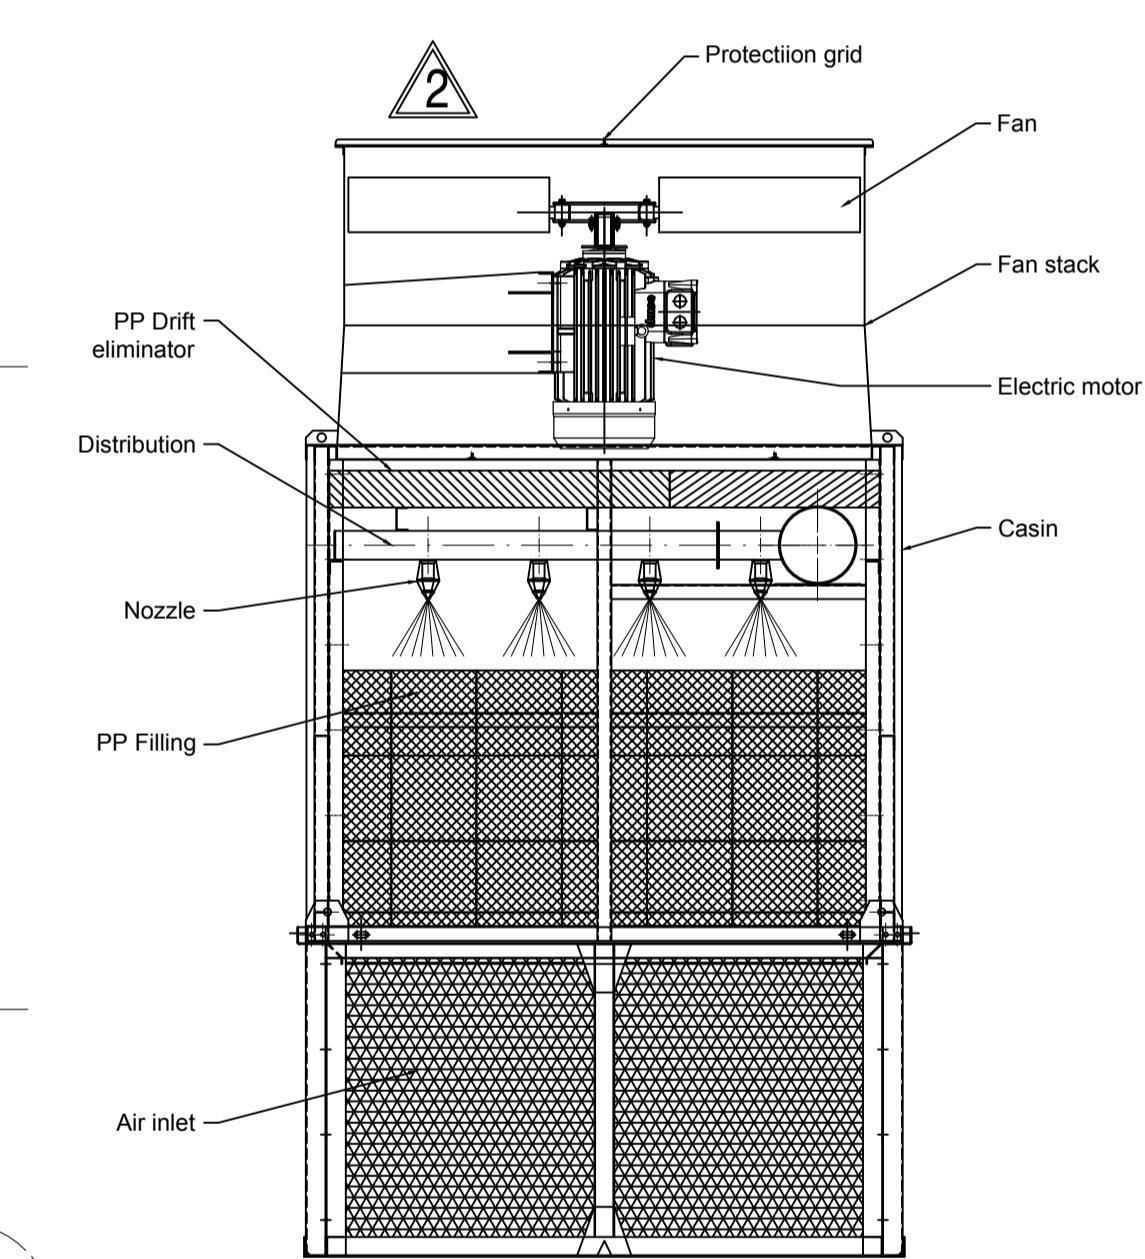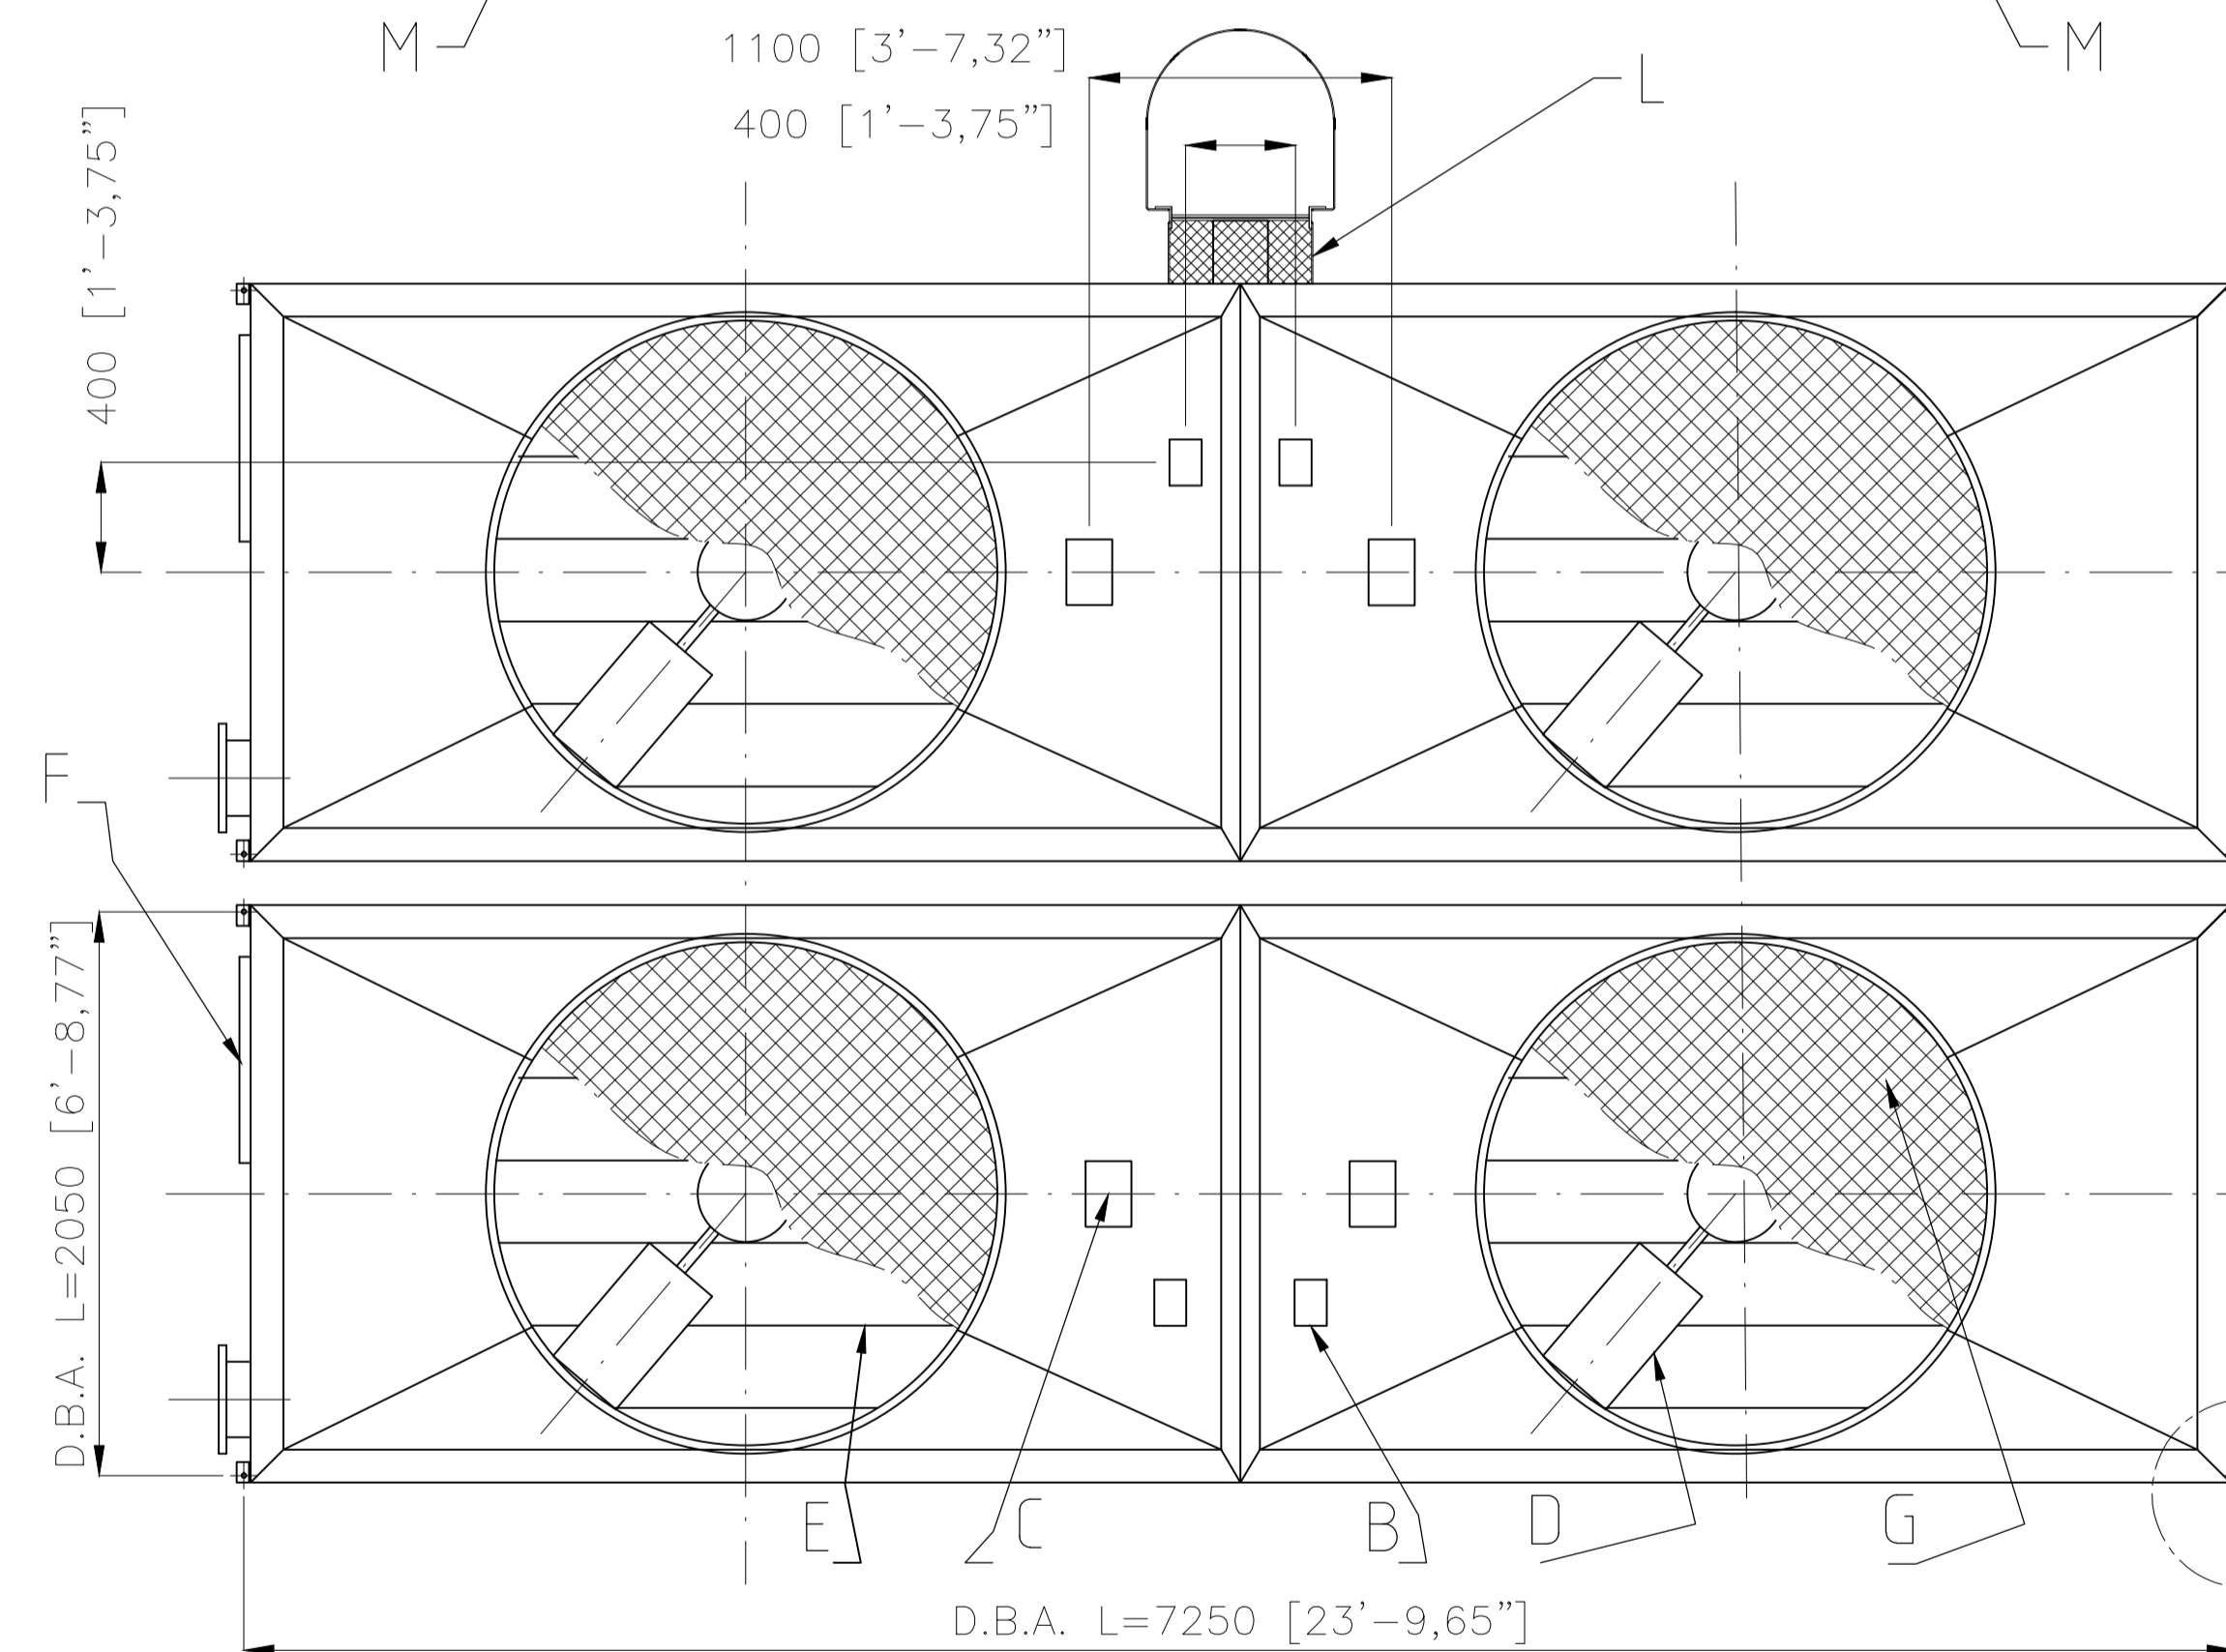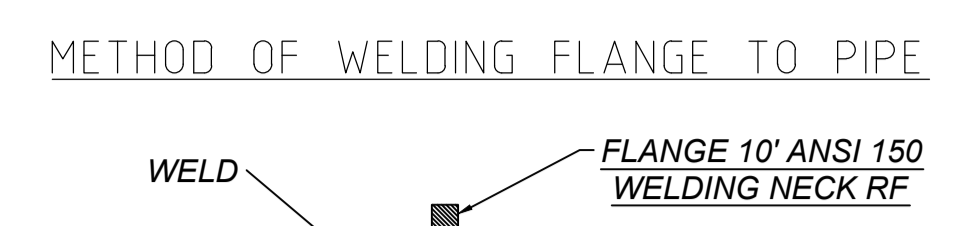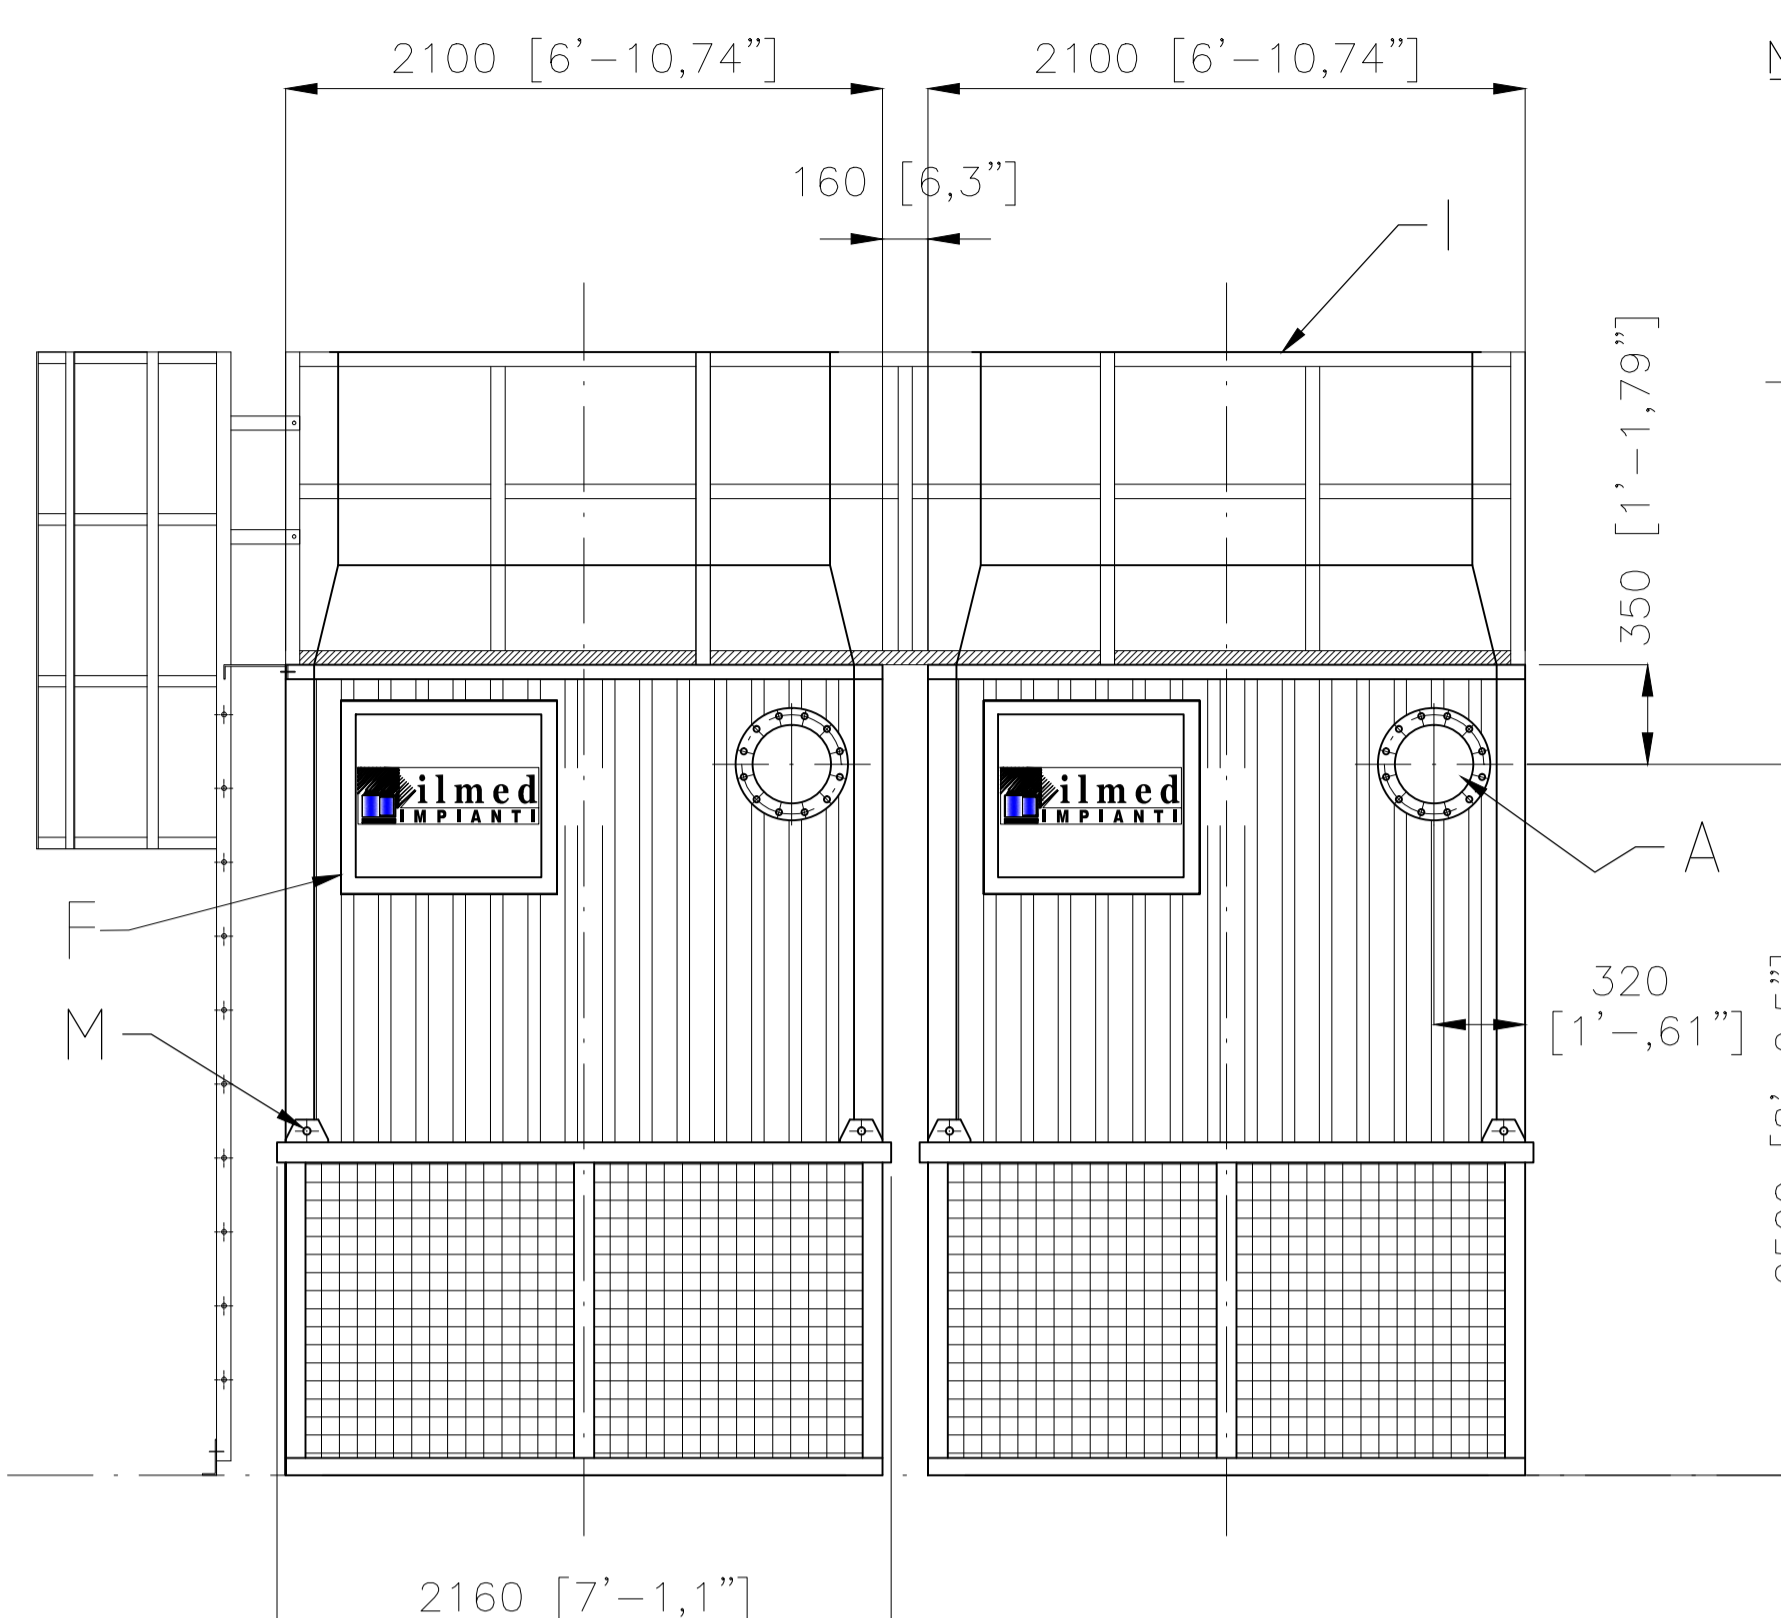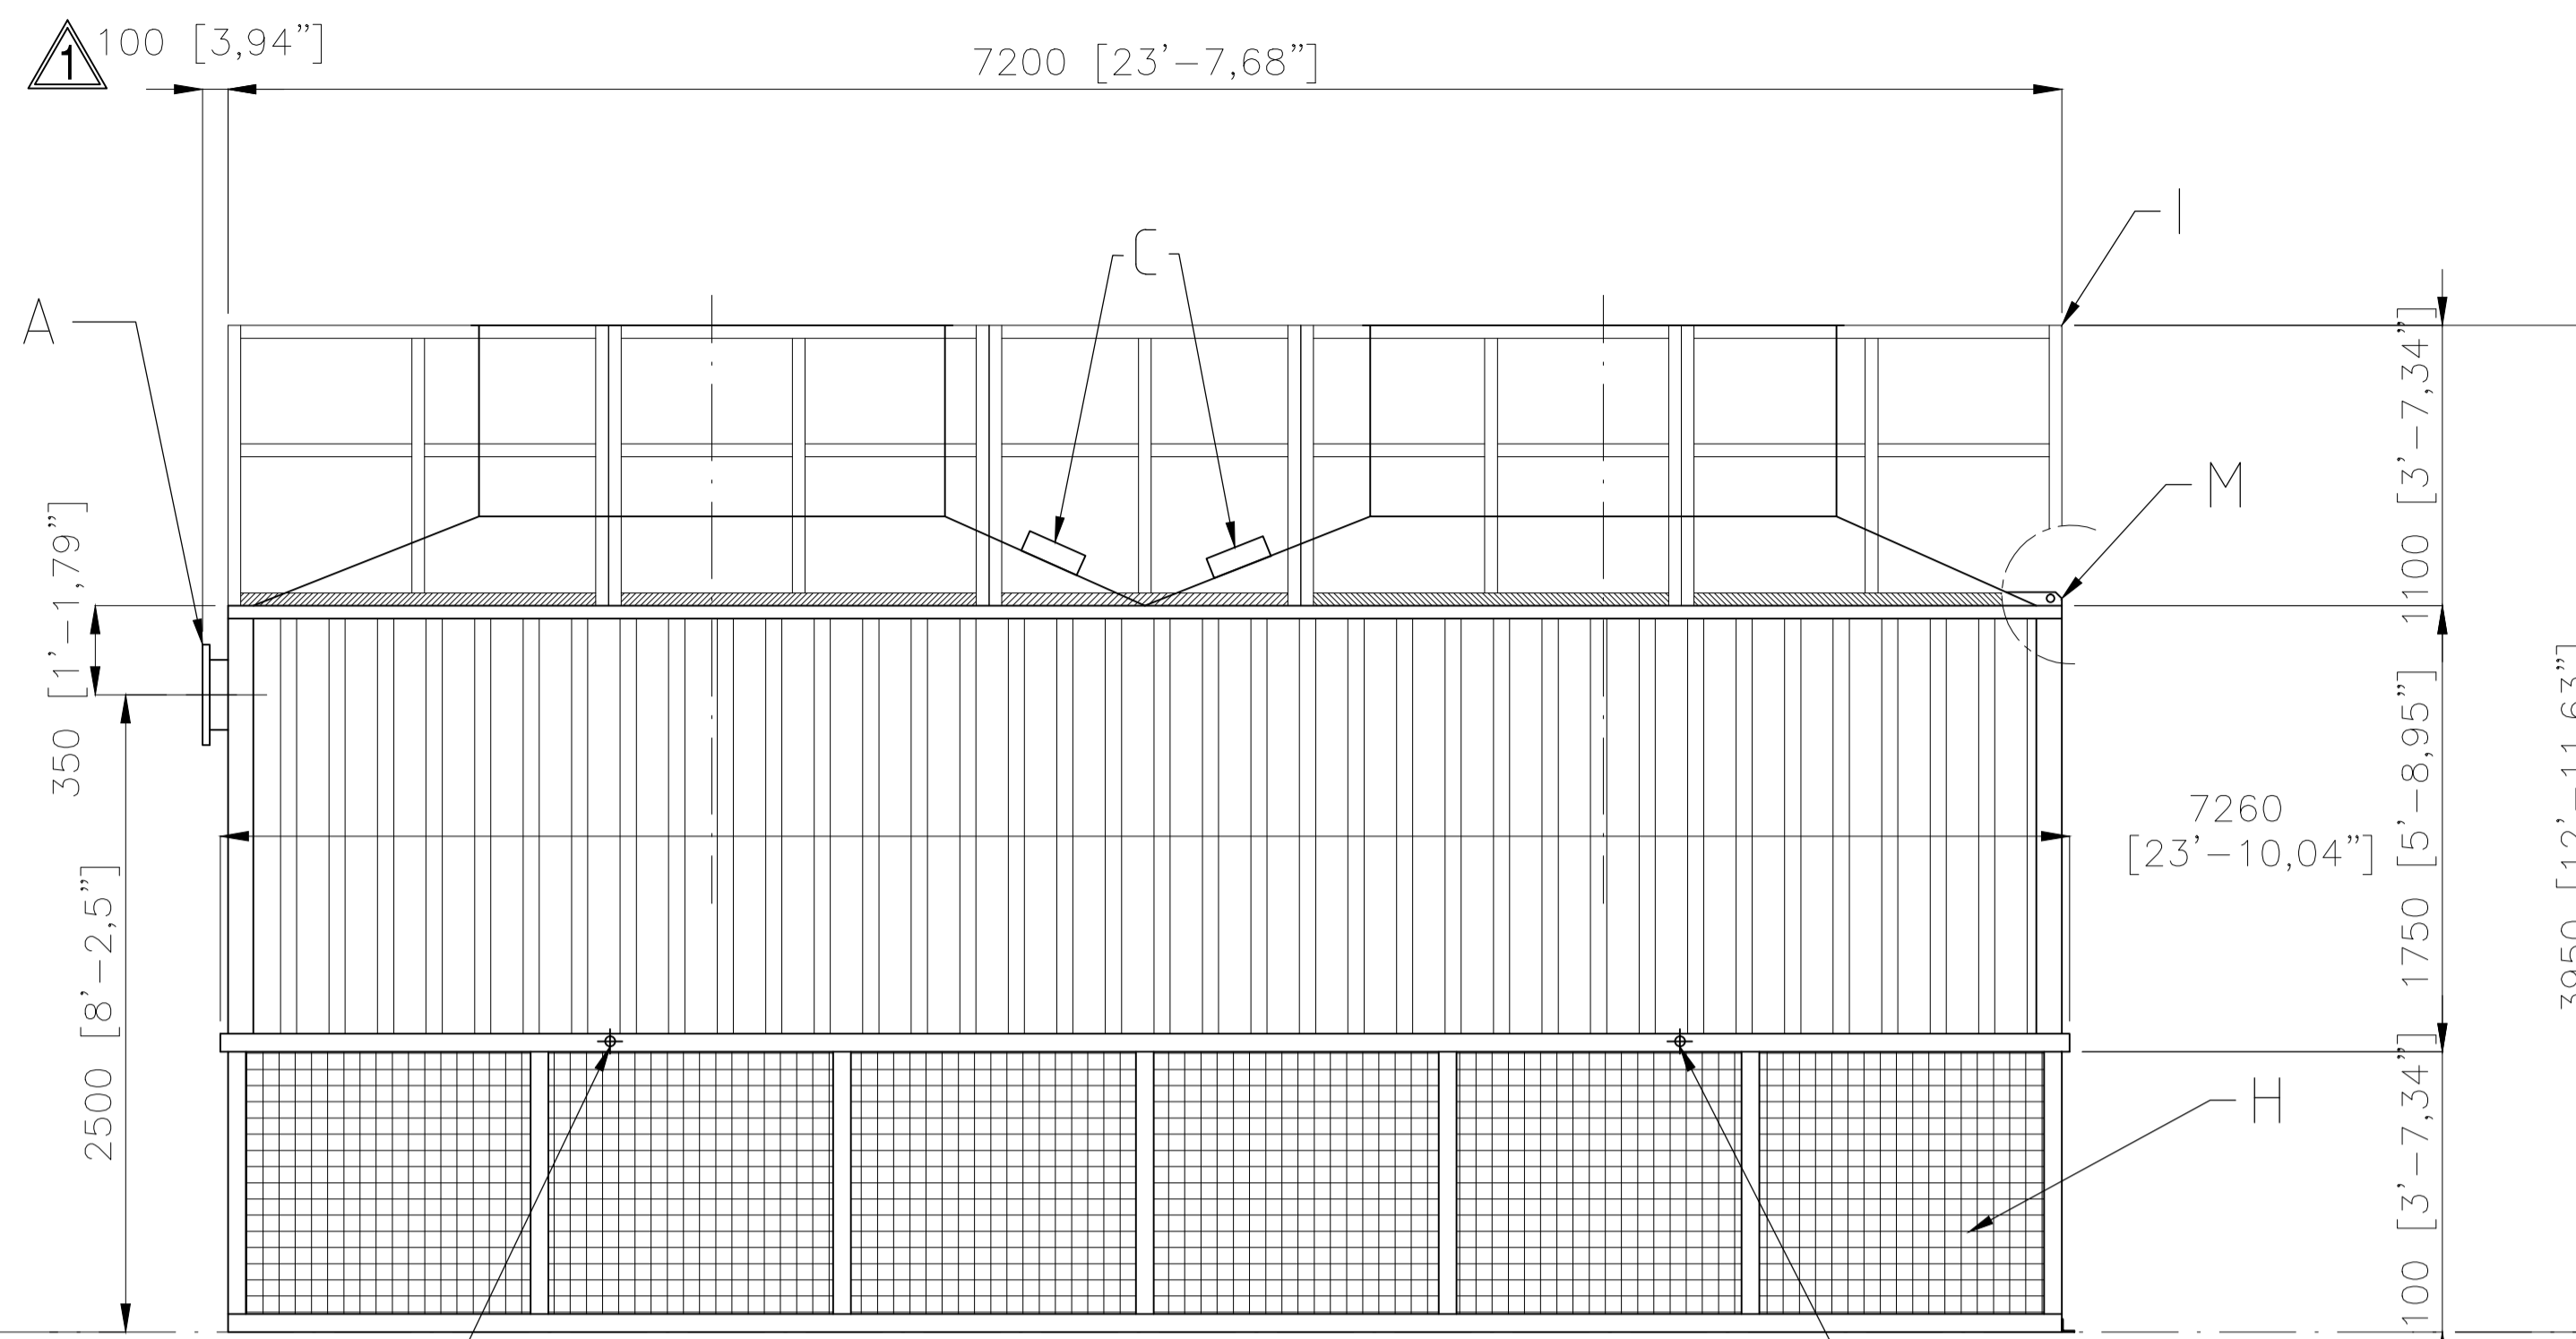

|                          |                            |
|--------------------------|----------------------------|
| <b>PERFORMANCE</b>       |                            |
| Unit water flow rate     | 1096.1 US gpm              |
| Inlet water Temperature  | 114.5 °F                   |
| Outlet water Temperature | 90.0 °F                    |
| Wet bulb Temperature     | 82.9 °F                    |
| <b>MATERIALS</b>         |                            |
| Structural elements      | HDGS (mat.al S235JR)       |
| Casing                   | HDGS (mat.al S235JR)       |
| Fan Stack                | HDGS (mat.al S235JR)       |
| Water dispersion system  | HDGS (mat.al S235JR)       |
| Nozzles                  | polyprop. glass reinforced |
| Drift eliminators        | polypropylene              |
| Filling system           | polypropylene              |
| Filling system supports  | HDGS (mat.al S235JR)       |
| Louvers                  | HDGS (see above)+polyprop. |
| <b>ELECTRIC MOTOR</b>    |                            |
| Power                    | 14.75 hp                   |
| Voltage                  | 400 ± 10% V                |
| Frequency                | 50 ± 2% Hz                 |
| <b>FAN</b>               |                            |
| Type                     | ALU/32n/03n/CA1/1800/AP    |
| Rotation speed           | 720 rot/min                |
| Pitch angle              | 15.5°                      |

4 FOR SKID COORDINATES REFER TO FOUNDATION LAYOUT AND LOADS DOC. 3-PU101-ME-DW-106

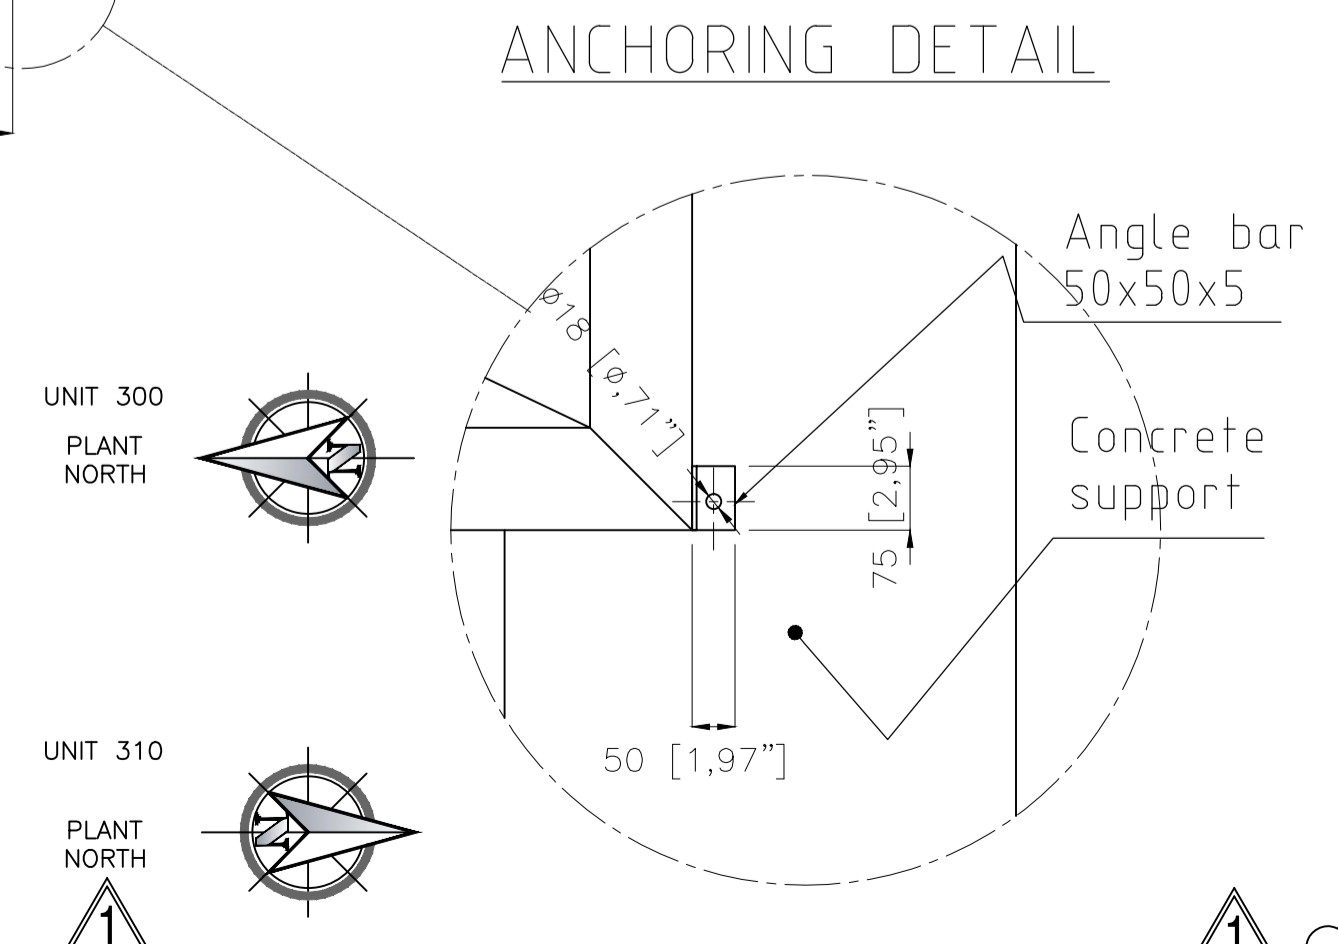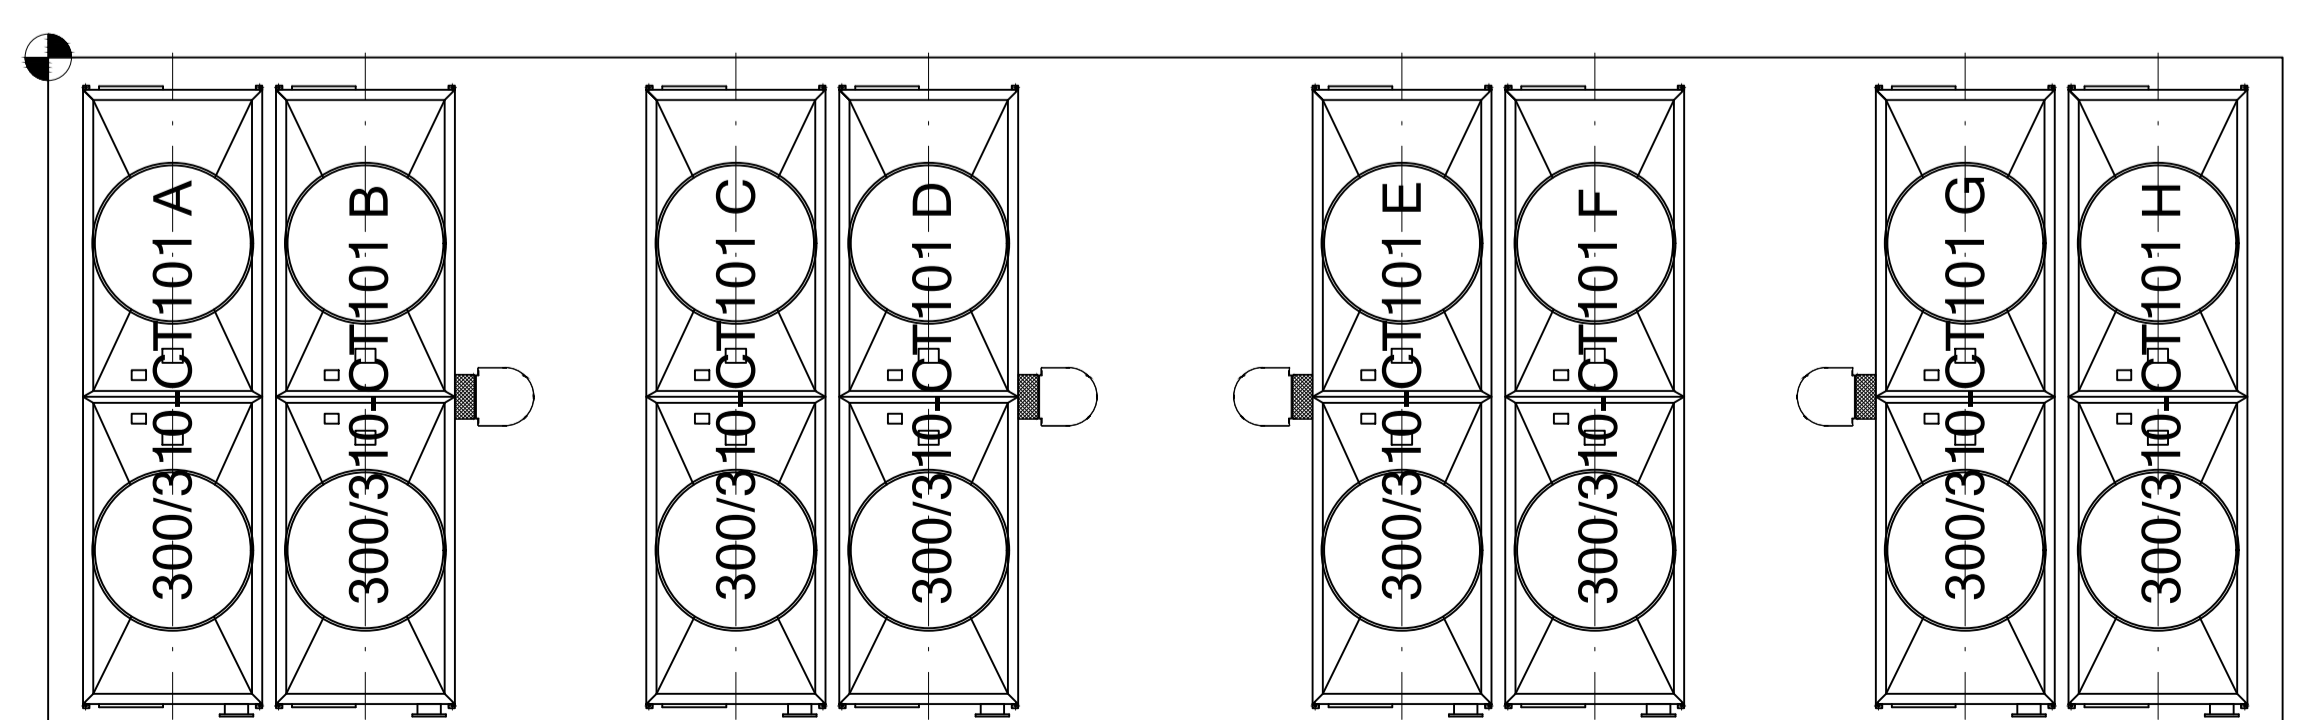

|   |   |   |
|---|---|---|
| A | Water inlet flange 10' ANSI 150 WELDING NECK RF | 1 |
| B | Vibraswitch: cable connection 3/4' NPT          | 2 |
| C | Junction box: motor cable M40 + PTC cable M20   |   |
| D | Fan   |   |
| E | Drift eliminators                               |   |
| F | Inspection door                                 |   |
| G | Protection grid                                 |   |
| H | Louvers   |   |
| I | Handrail  |   |
| L | Caged ladder                                    |   |
| M | Lifting hooks                                   |   |

| NO. | REV. | DATE       | DESCRIPTION | APP. | CHK. |
|-----|------|------------|-------------|------|------|
| 01  | REV. | 08/04/2013 | DIS DATA    | N.M. | N.M. |
| 02  | REV. | 09/03/2013 | DIS DATA    | N.M. | N.M. |
| 03  | REV. | 27/02/2013 | DIS DATA    | N.M. | N.M. |
| 04  | REV. | 26/02/2013 | DIS DATA    | N.M. | N.M. |
| 05  | REV. | 22/02/2013 | DIS DATA    | N.M. | N.M. |
| 06  | REV. | 15/02/2013 | DIS DATA    | N.M. | N.M. |
| 07  | REV. | 12/02/2013 | DIS DATA    | N.M. | N.M. |
| 08  | REV. | 31/01/2013 | DIS DATA    | N.M. | N.M. |
| 09  | REV. | 11-12-2012 | DIS DATA    | N.M. | N.M. |
| 10  | REV. | 07/11/2012 | DIS DATA    | N.M. | N.M. |

**ilmed IMPIANTI**  
 10051 Avigliana (TO) Tel. +39 011 9325.555  
 www.ilmed.it

**BELLELLI ENGINEERING S.p.A.**  
 COOLING TOWER TYPE TG/Q2/43/HT/S/CONT  
**OVERALL DIMENSIONS**

PART NAME: AUTOCAD / TG/Q2/43/HT/S/CONT

**REFERENCE DOCUMENTS**

| DOCUMENT TYPE   | DOCUMENT NUMBER   |
|---|-------------------|
| DATASH. FOR COOLING TOWER                                   | 3-CT101-PR-DS-018 |
| COOLING WATER SYSTEM P&ID                                   | 3-PU501-PR-DI-003 |
| ERECTION INSTALLATION ASSEMBLY INSTRUCTION OF COOLING TOWER | 3-CT101-ME-DW-025 |
| FOUNDATION LAYOUT AND LOADS                                 | 3-PU101-ME-DW-106 |

**GENERAL NOTES**

- ALL DIMENSIONS ARE IN MILLIMETERS AND INCHES.
- COOLING TOWER DIMENSIONS ARE SPECIFIC FOR 40' HIGH CUBE CONTAINER

**ENAR PETROTECH SERVICES (PRIVATE) LTD.**  
 Job No. 14-4985

**OIL & GAS DEVELOPMENT COMPANY LTD.**


| REV | DESCRIPTION             | DRAWN | CHECKED | APPROVED | DATE       |
|-----|-------------------------|-------|---------|----------|------------|
| 04  | AS BUILT                | NM    | NM      | AV       | 18.09.2013 |
| 03  | REVISION AFTER COMMENTS | NM    | NM      | AV       | 05.04.2013 |
| 02  | REVISION AFTER COMMENTS | NM    | NM      | AV       | 08.03.2013 |
| 01  | GENERAL REVISION        | NM    | NM      | AV       | 22.02.2013 |
| 00  | ISSUED FOR APPROVAL     | NM    | NM      | AV       | 20.12.2012 |

**BELLELLI ENGINEERING S.p.A.**  
 Via Antonio Meucci 232 - 45021 BADIA POLESINE (RO)  
 Tel. 0039.0425.595.074 - Fax. 0039.0425.590.372  
 www.bellelliling.com / info@bellelliling.com


DOCUMENT TYPE: GENERAL ARRANGEMENT OF COOLING TOWERS 300/310 CT101  
 DOCUMENT NUMBER: 3-CT101-ME-DW-017

| BELLELLI PROJECT CODE | LOCATION | PLANT                     | SCALE | SHEET  | REV No. |
|-----------------------|----------|---------------------------|-------|--------|---------|
| 1896-12               | PAKISTAN | AMINE GAS SWEETENING UNIT | -     | 1 of 3 | 04      |



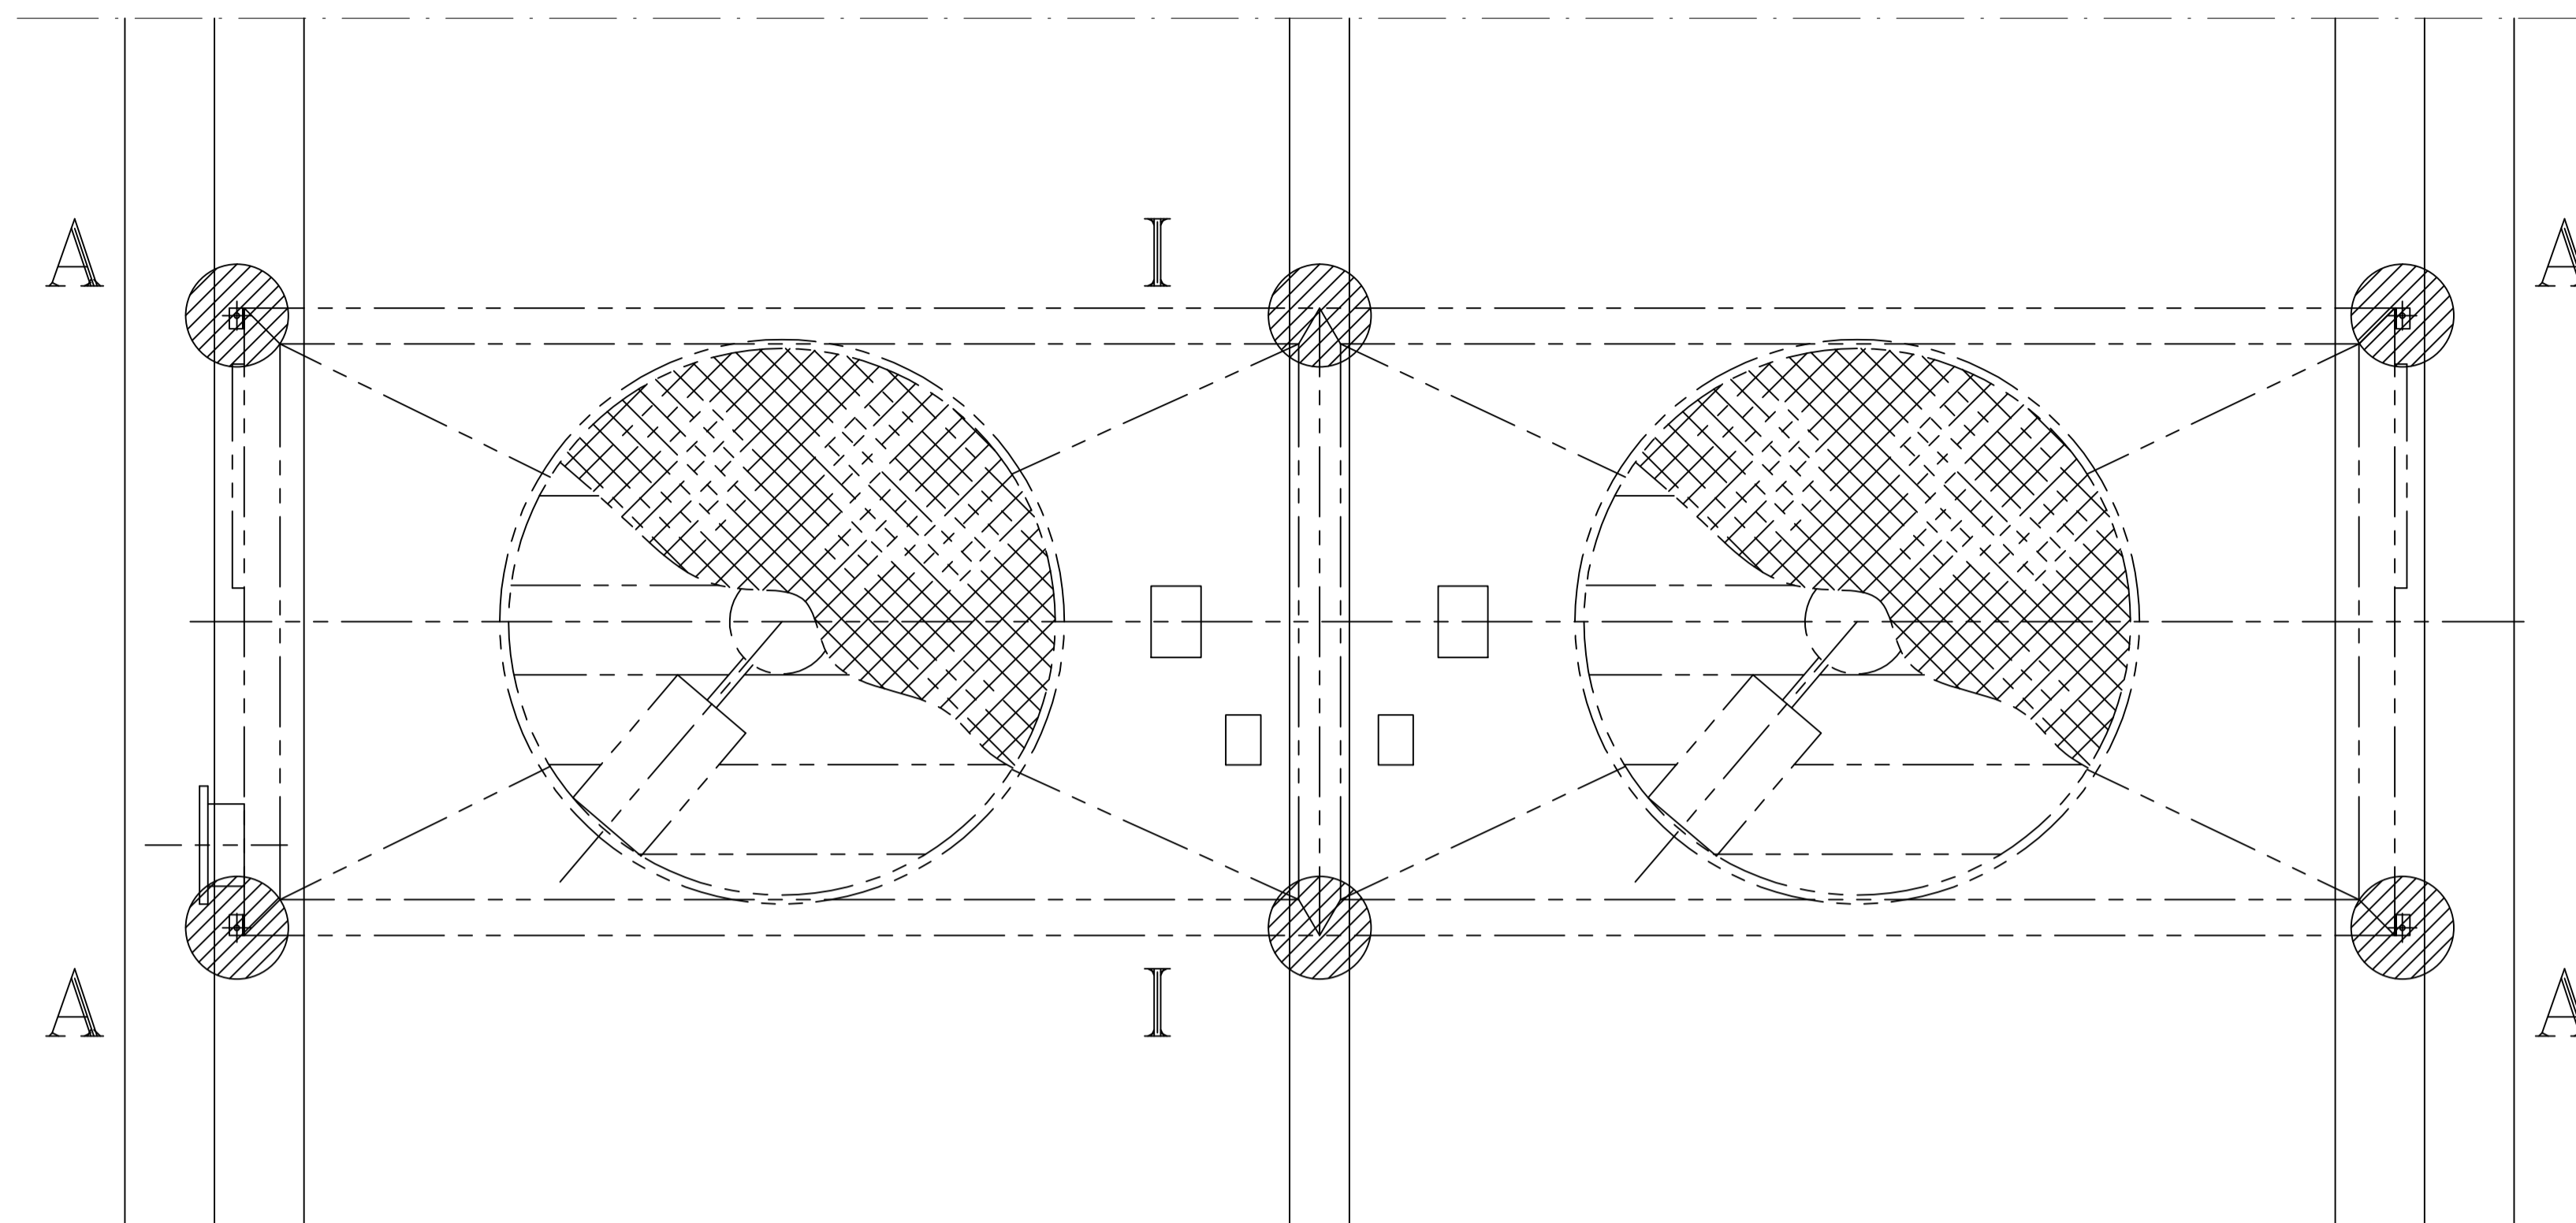

ANCHORING DETAIL

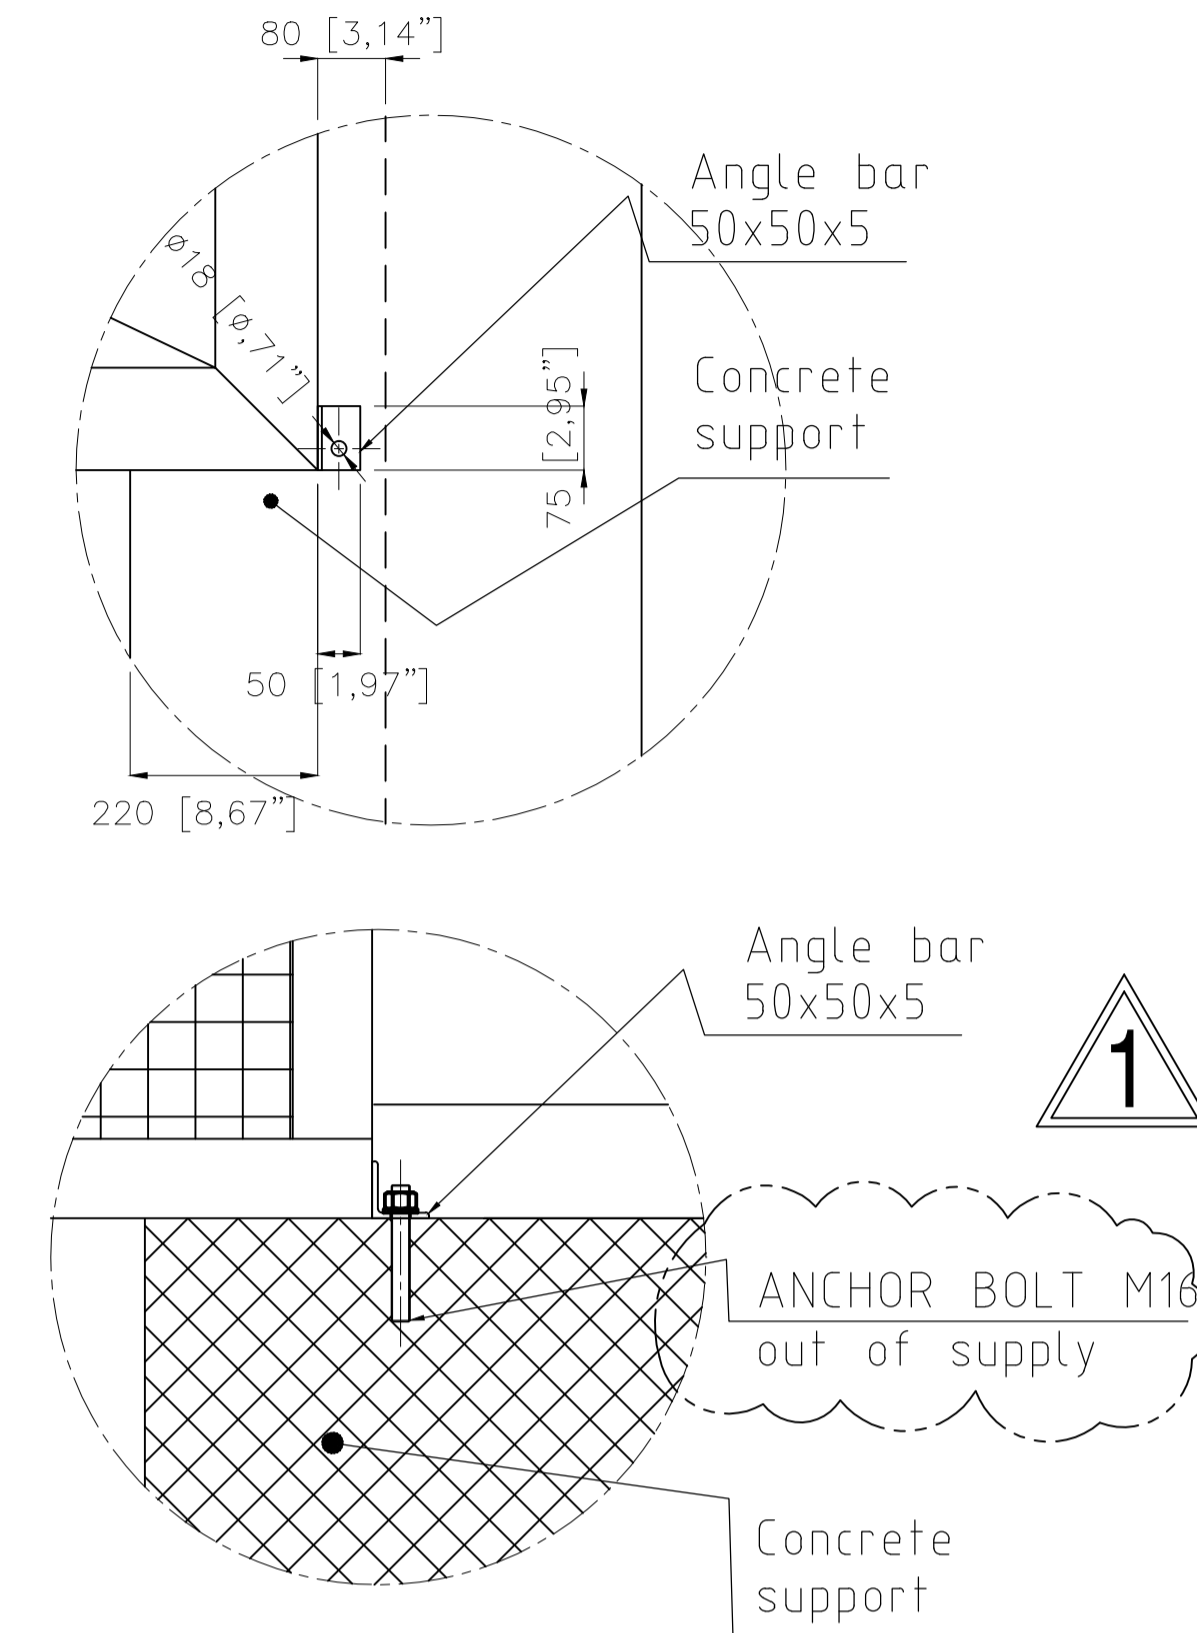

|                  |  |------------------|--|------|------------|------------|------------|------------|------------|------------|------|------|------------|------------|------|------|-----------|------|------|------|------|------|--|
| GENERAL REVISION | DESCRIZIONE REVISIONI / Revisions Descriptions | AV.  | AV.        | AV.        | AV.        | AV.        | AV.        | AV.        | AV.  | AV.  | AV.        | AV.        | AV.  | AV.  | AV.       | AV.  | AV.  | AV.  | AV.  | AV.  |  |
| N.M.             | CONTR. CHECK                                   | N.M. | N.M.       | N.M.       | N.M.       | N.M.       | N.M.       | N.M.       | N.M. | N.M. | N.M.       | N.M.       | N.M. | N.M. | N.M.      | N.M. | N.M. | N.M. | N.M. | N.M. |  |
| N.M.             | DIS. DWG.                                      | N.M. | N.M.       | N.M.       | N.M.       | N.M.       | N.M.       | N.M.       | N.M. | N.M. | N.M.       | N.M.       | N.M. | N.M. | N.M.      | N.M. | N.M. | N.M. | N.M. | N.M. |  |
| 08/04/2013       | REV. DATA Date                                 | 09   | 09/03/2013 | 27/02/2013 | 26/02/2013 | 22/02/2013 | 15/02/2013 | 12/02/2013 | 04   | 03   | 31-01-2013 | 11-12-2012 | 07   | 07   | DATA Date |      |      |      |      |      |  |
| AV.              | AV.  |  |

**ilmed IMPIANTI**  
 TORRE REFRIGERANTE D'ACQUA / WATER COOLING TOWER

Modello / Model : TG/Q2/43/EX/HT/S/CONT  
 Targa / Serial N° : 12T107941  
 Portata / Flow Rate: 248.9 mc/h 1096.1 US gpm  
 Anno / Year : 2013  
 Item / Rif. : 300-CT101 A

**CE**

WEIGHT FOR ONE MODULE TG/Q2/43/HT/S/CONT:  
 SHIPPING Kg. 3400  
 OPERATING Kg. 5100

| ITEM                        |              |                   | ERECTION (FULL WIND) |       | OPERATING (SEISMIC) |      | HYDROTEST (PARTIAL WIND) |      |
|-----------------------------|--------------|-------------------|----------------------|-------|---------------------|------|--------------------------|------|
|                             |              |                   | kN                   | lb    | kN                  | lb   | kN                       | lb   |
| I<br>(intermediate support) | SHEAR (T)    | Longitudinal load | /                    | /     | /                   | /    | /                        | /    |
|                             |              | Transversal load  | /                    | /     | /                   | /    | /                        | /    |
|                             | MOMENT (M)   | kN*m              | /                    | /     | /                   | /    | /                        | /    |
| A<br>(corner support)       | SHEAR (T)    | Longitudinal load | 35,0                 | 25,0  | 20,0                | 77,2 | 55,1                     | 44,1 |
|                             |              | Transversal load  | 77,2                 | 55,1  | 44,1                | 22,0 | 11,0                     | 11,0 |
| A<br>(corner support)       | SHEAR (T)    | Longitudinal load | ± 5,0                | ± 5,0 | ± 2,5               | 11,0 | 11,0                     | 5,5  |
|                             |              | Transversal load  | ± 10                 | ± 10  | ± 5                 | 22,0 | 22,0                     | 11,0 |
|                             | MOMENT (M)   | Transversal load  | /                    | /     | /                   | /    | /                        | /    |
| A<br>(corner support)       | VERTICAL (Q) | Longitudinal load | 25,0                 | 15,0  | 10,0                | 55,0 | 33,1                     | 22,0 |
|                             |              | Transversal load  | 55,0                 | 33,1  | 22,0                |      |                          |      |

**ilmed IMPIANTI**  
 BELLELLI ENGINEERING S.p.A.  
 COOLING TOWER TYPE TG/Q2/43/HT/S/CONT

**OVERALL DIMENSIONS**

PART NAME : AUTOCAD / TG/Q2/43/HT/S/CONT

REFERENCE DOCUMENTS

| DOCUMENT TYPE   | DOCUMENT NUMBER   |
|---|-------------------|
| ERECTION INSTALLATION ASSEMBLY INSTRUCTION OF COOLING TOWER | 3-CT101-ME-DW-025 |
| FOUNDATION LAYOUT AND LOADS                                 | 3-PU101-ME-DW-106 |

**GENERAL NOTES**

- ALL DIMENSIONS ARE IN MILLIMETERS AND INCHES.
- COOLING TOWER DIMENSIONS ARE SPECIFIC FOR 40' HIGH CUBE CONTAINER
- TAG FOR COOLING TOWER ARE: 300-CT101 A, 310-CT101 B, 300-CT101 C, 310-CT101 D, 300-CT101 E, 310-CT101 F, 300-CT101 G, 310-CT101 H, 300-CT101 I, 310-CT101 J

**ENAR PETROTECH SERVICES (PRIVATE) LTD.** Job No. 14-4985

**OIL & GAS DEVELOPMENT COMPANY LTD.**

| REV | DESCRIPTION             | DRAWN | CHECKED | APPROVED | DATE       |
|-----|-------------------------|-------|---------|----------|------------|
| 04  | AS BUILT                | NM    | NM      | AV       | 18.09.2013 |
| 03  | REVISION AFTER COMMENTS | NM    | NM      | AV       | 05.04.2013 |
| 02  | REVISION AFTER COMMENTS | NM    | NM      | AV       | 08.03.2013 |
| 01  | GENERAL REVISION        | NM    | NM      | AV       | 22.02.2013 |
| 00  | ISSUED FOR APPROVAL     | NM    | NM      | AV       | 20.12.2012 |

**BELLELLI ENGINEERING S.p.A.**  
 Via Antonio Meucci 232 - 45021 BADIA POLESINE (RO)  
 Tel. 0039.0425.595.074 - Fax. 0039.0425.590.372  
 www.bellellieng.com / info@bellellieng.com

DOCUMENT TYPE: GENERAL ARRANGEMENT AND LAYOUT OF COOLING TOWERS (300/310-CT101)

DOCUMENT NUMBER: 3-CT101-ME-DW-017

| BELLELLI PROJECT CODE | LOCATION | PLANT                     | SCALE | SHEET  | REV No. |
|-----------------------|----------|---------------------------|-------|--------|---------|
| 1896-12               | PAKISTAN | AMINE GAS SWEETENING UNIT | -     | 2 of 3 | 04      |

**ilmed IMPIANTI**  
 TORRE MOD. TG/Q2/43/EX/HT/S/CONT  
 N°. Serie 12T107941 Anno 2013  
 Viale dei Mareschi, 15 10051 AVIGLIANA (Torino) Italy Rif. Cliente 300-CT101-A


**CE Ex II 3G T3**  
 Apparecchiatura in accordo alla direttiva 94/9/CE











WIND VELOCITY 120 Mph  
 SEISMIC ZONE FACTOR 0,1 g  
 Loads listed in the above table are calculated by means of structural calculation software: for details refer to mechanical calculation sheet.

# Identification of fan ducts, caged ladder and handrails position

Identify all supplied items and their position on the cooling towers according to present drawing. Components are all itemized with same identification tag hereby reported.

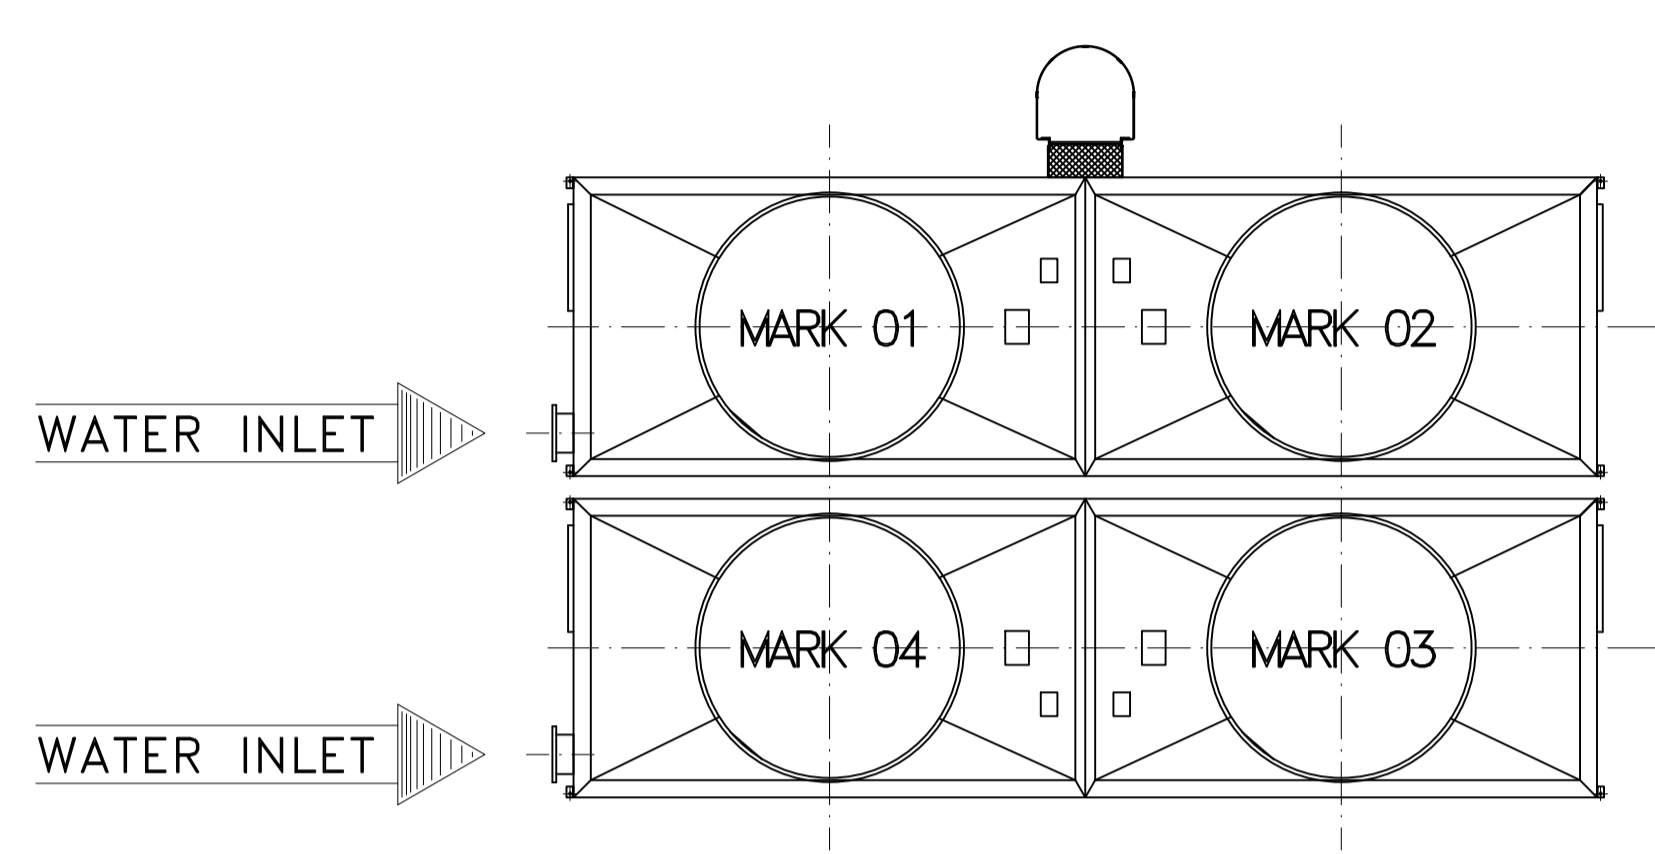

item  
 01 = fan duct  
 02 = fan duct  
 03 = fan duct  
 04 = fan duct

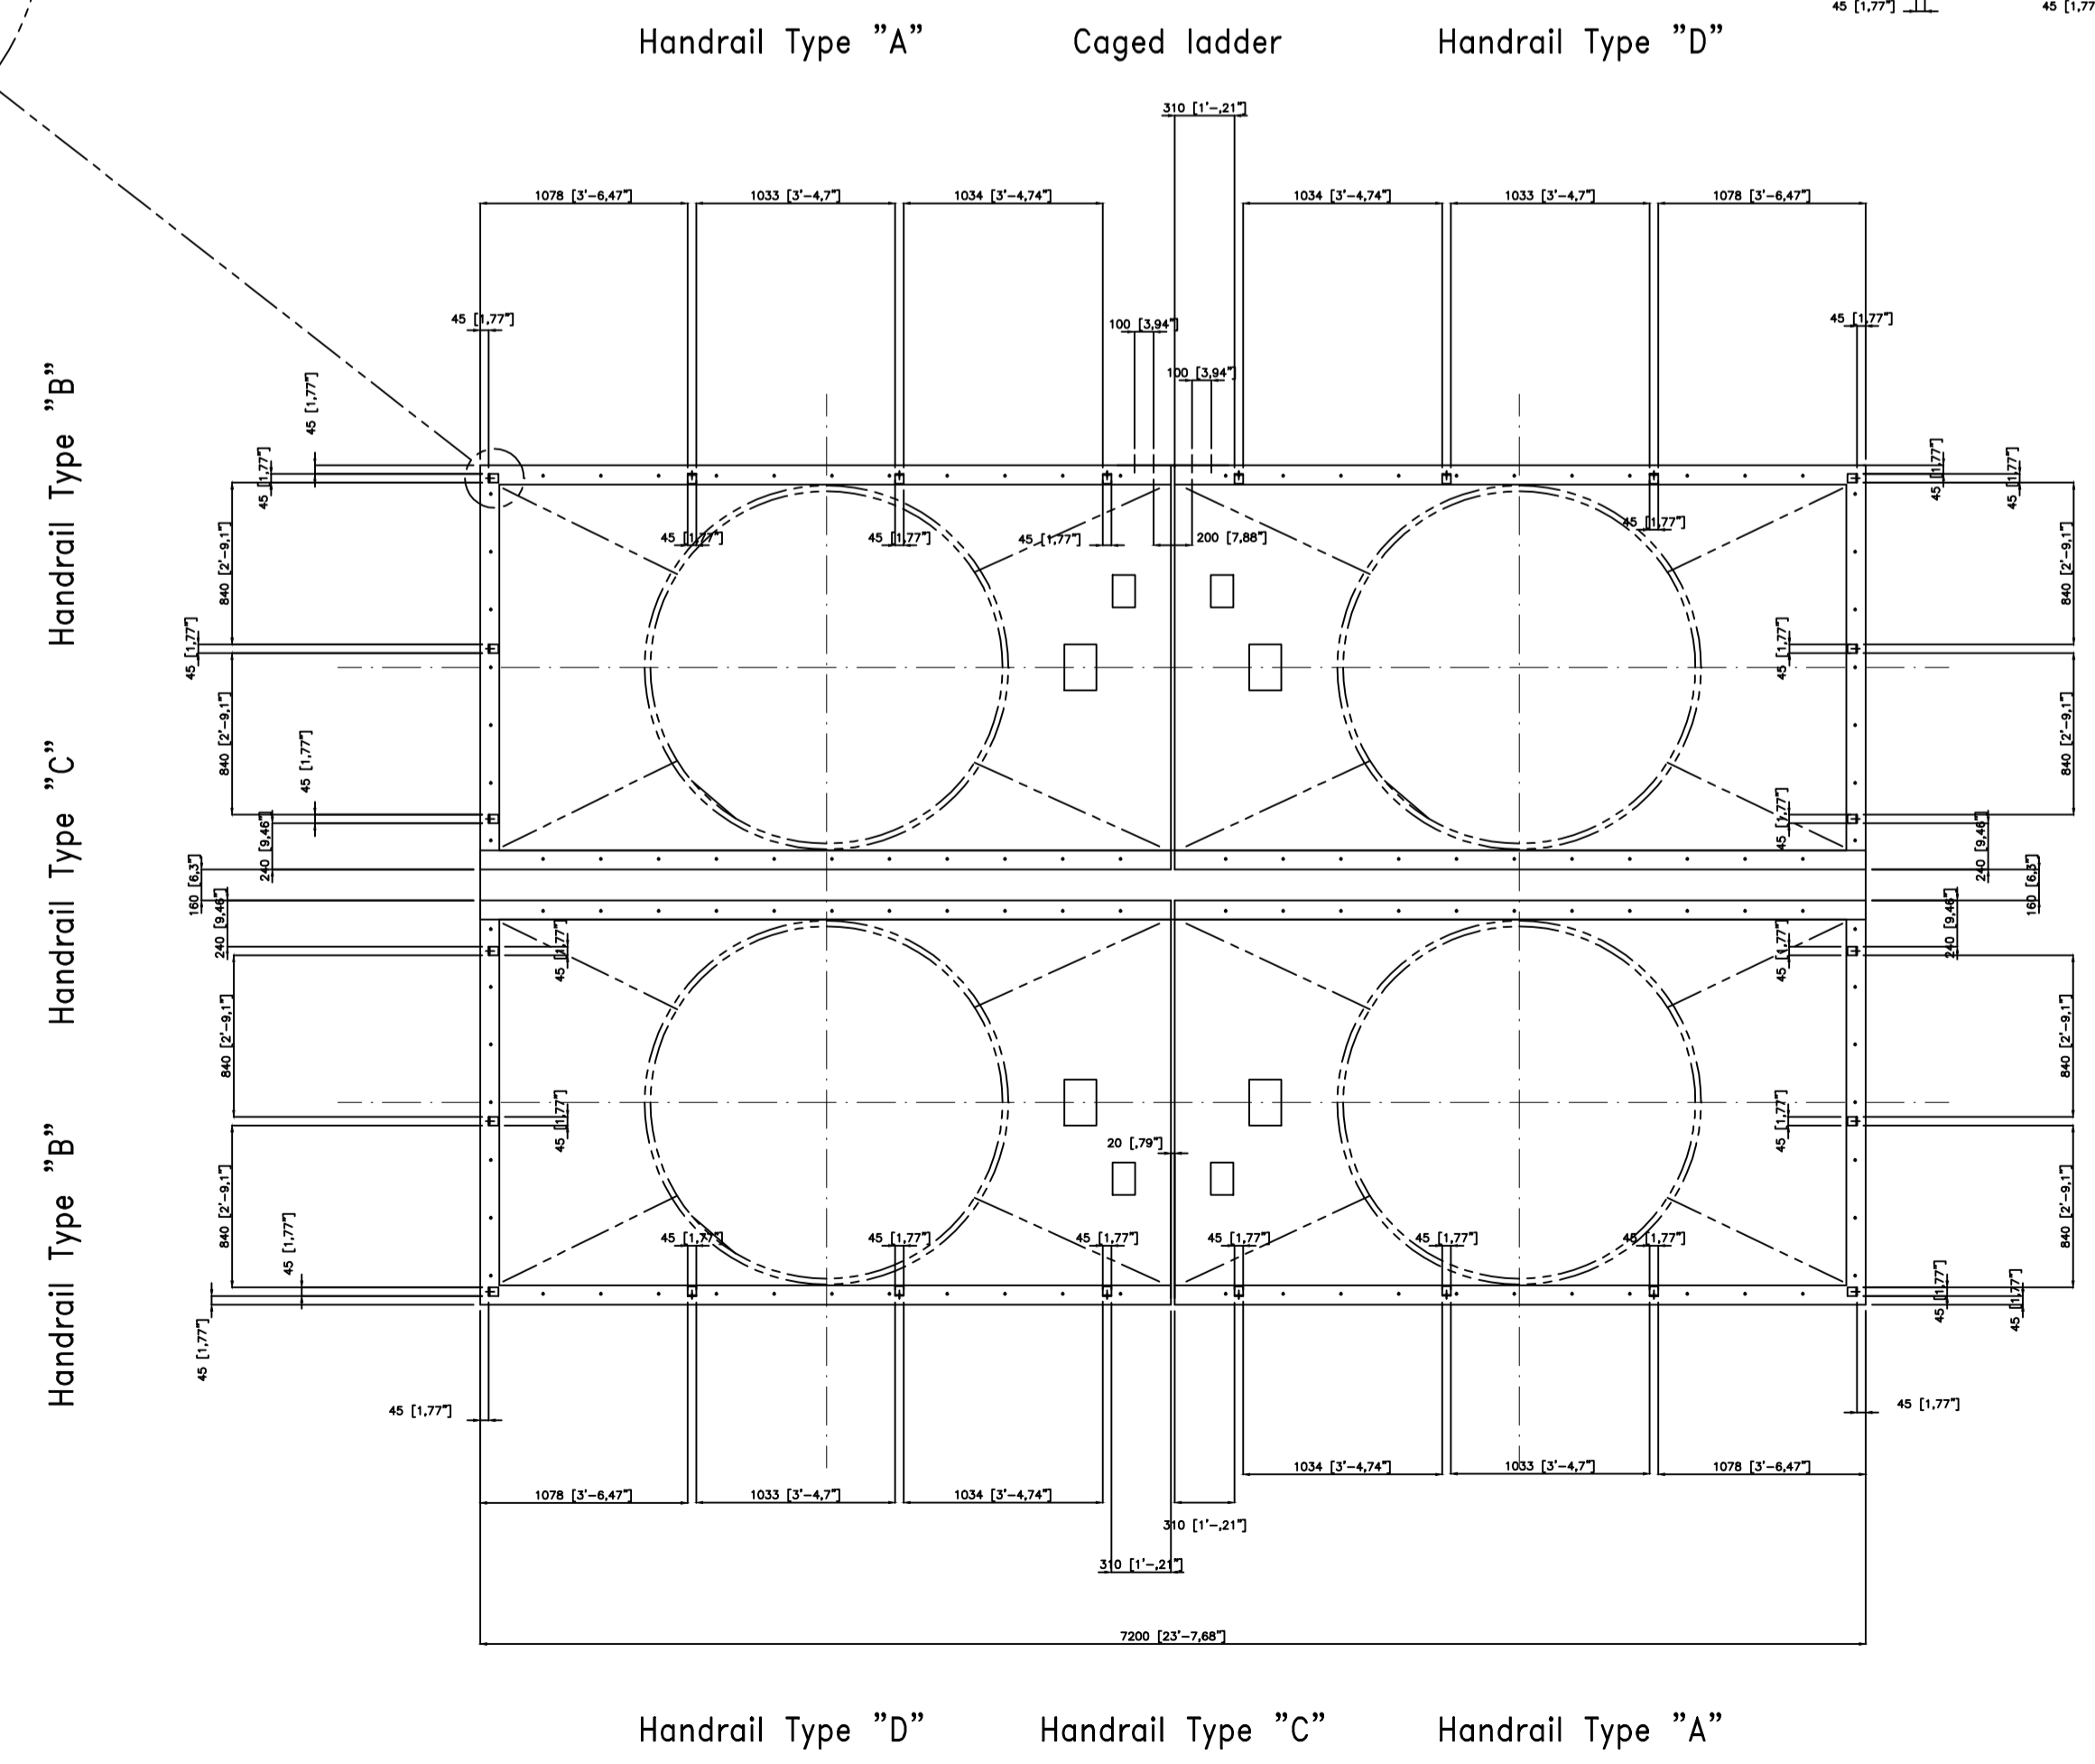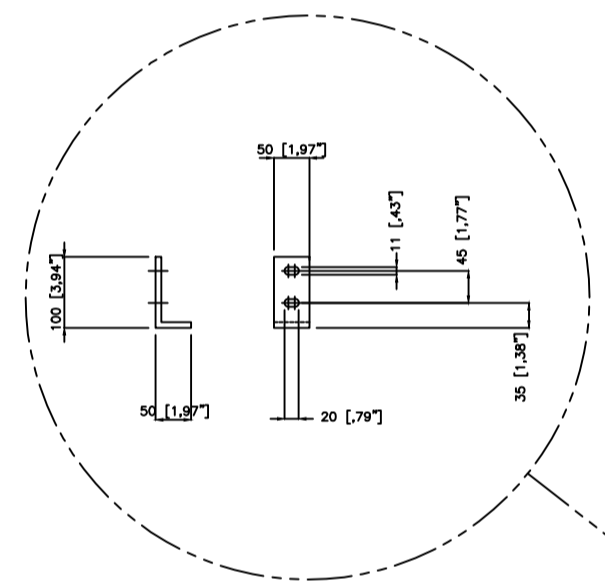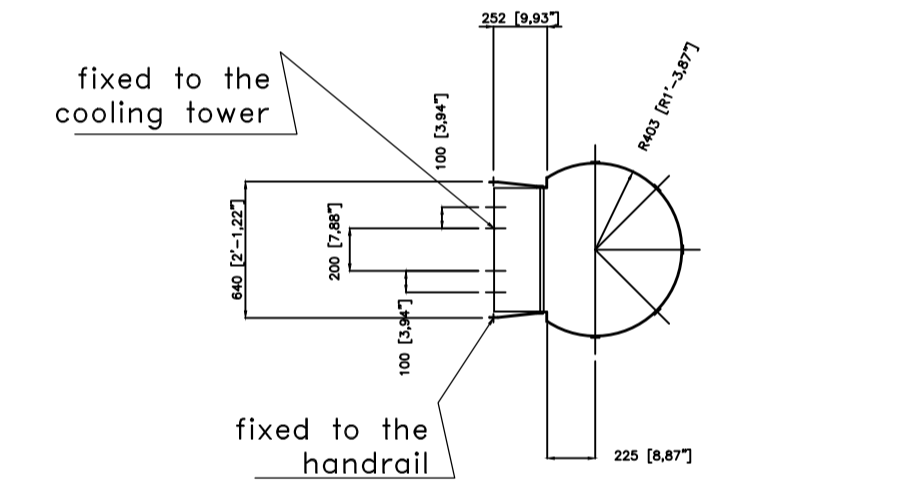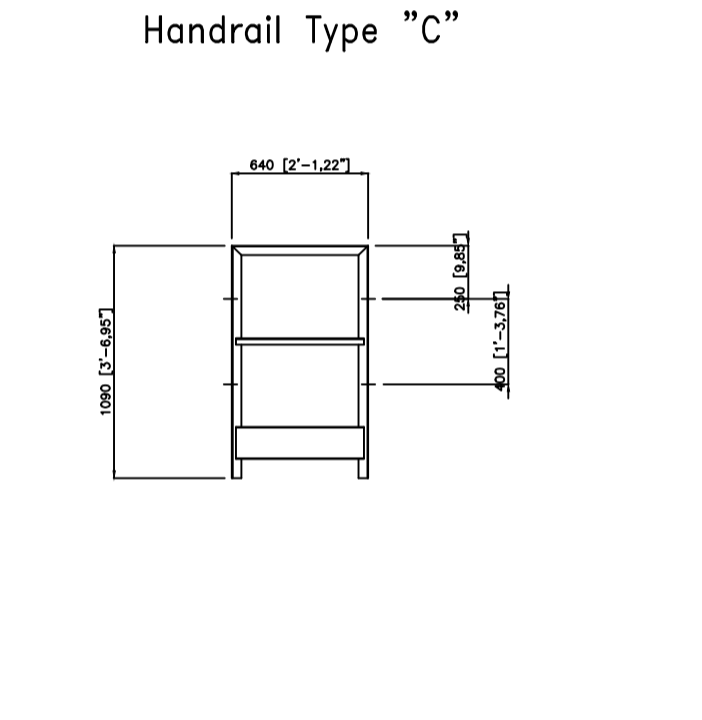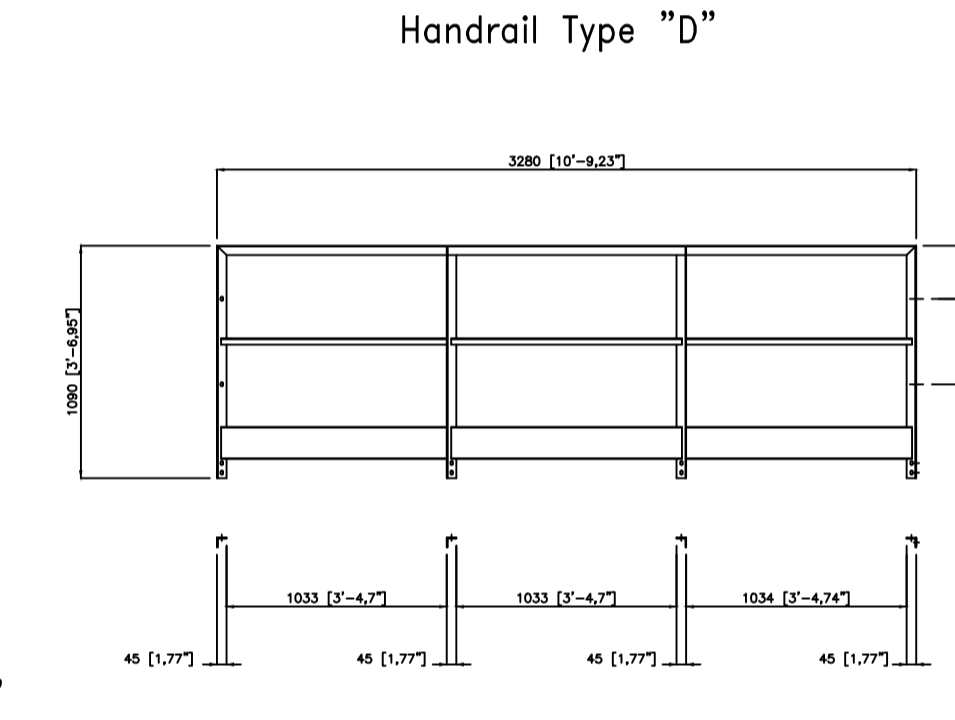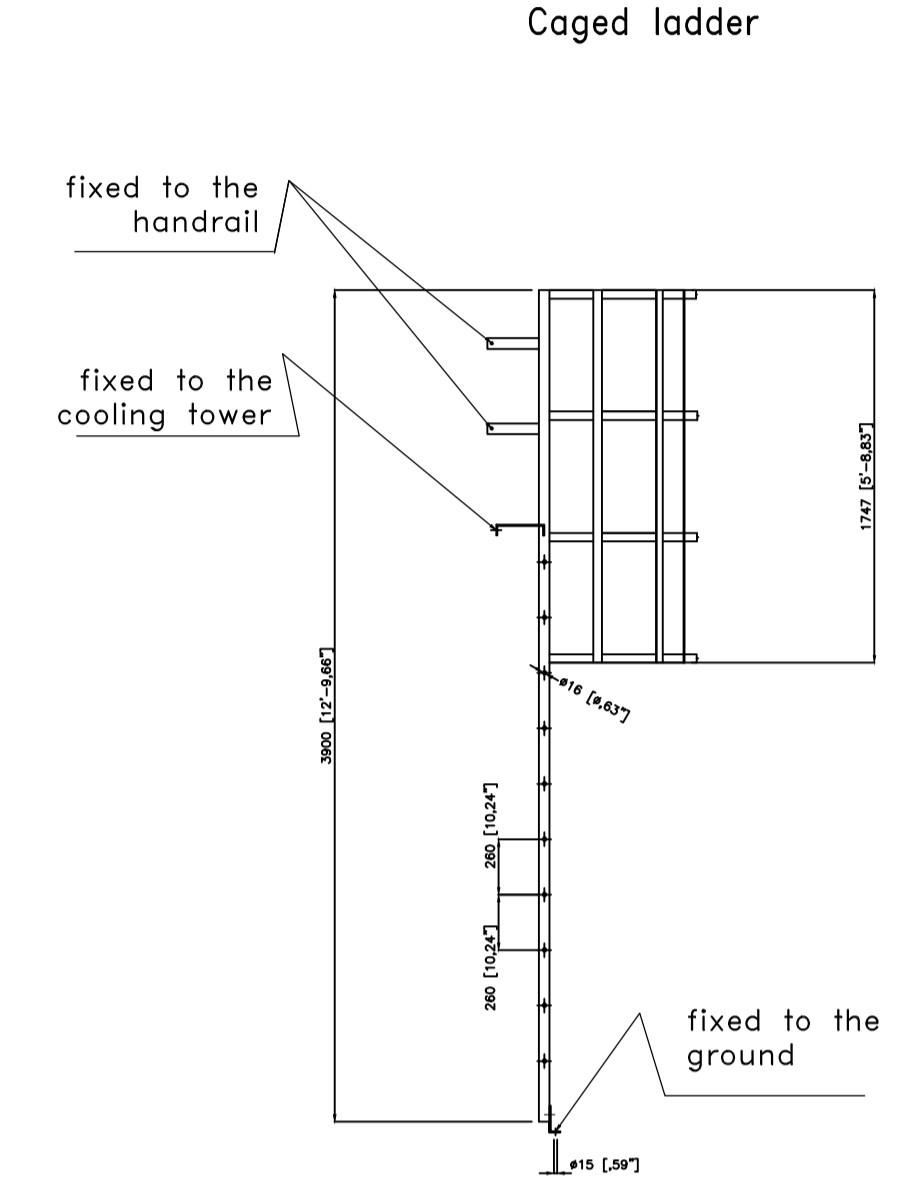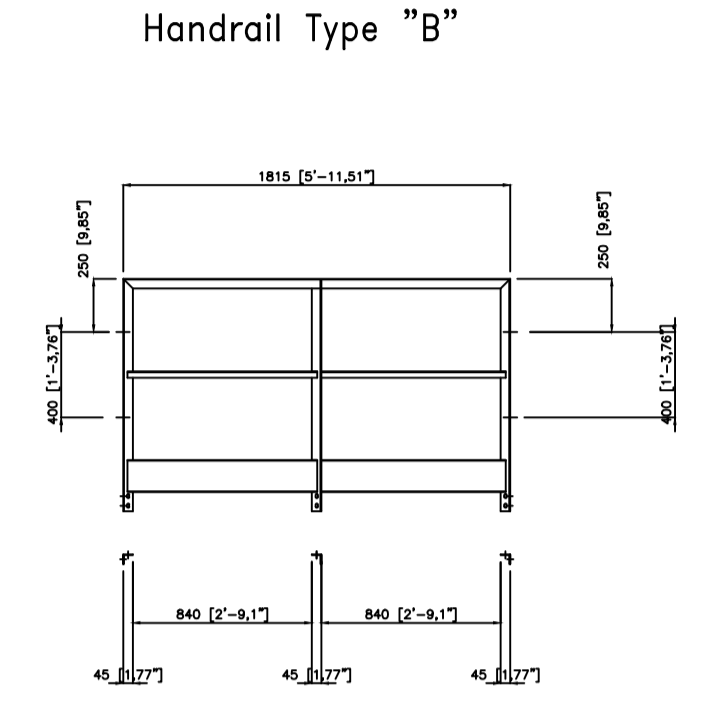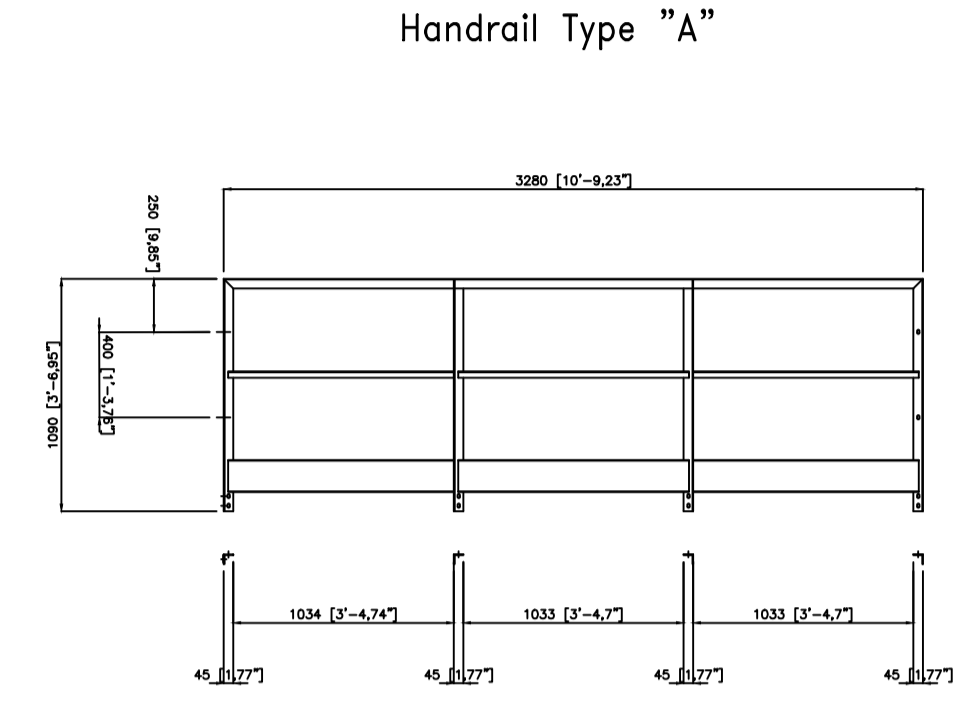

**B0Q about typical installation of two moduls**

| ITEM         | QUANTITY | Material |
|--------------|----------|----------|
| Type "A"     | 2        | S235JR   |
| Type "B"     | 4        | S235JR   |
| Type "C"     | 3        | S235JR   |
| Type "D"     | 2        | S235JR   |
| Caged ladder | 1        | S235JR   |
| 01           | 1        | S235JR   |
| 02           | 1        | S235JR   |
| 03           | 1        | S235JR   |
| 04           | 1        | S235JR   |

item  
 Type "A" = handrail  
 Type "B" = handrail  
 Type "C" = handrail  
 Type "D" = handrail

For assembly and lifting refer to the drawing  
 3-CT101-ME-DW-025 / 13124 IMPS

| REFERENCE DOCUMENTS  | |
|---|
| DOCUMENT TYPE  | DOCUMENT NUMBER         |  |         | ERECTION INSTALLATION ASSEMBLY INSTRUCTION OF COOLING TOWER  | 3-CT101-ME-DW-025       |  |         | FOUNDATION LAYOUT AND LOADS  | 3-PU101-ME-DW-106       |  |         | GENERAL NOTES  | |
| 1. ALL DIMENSIONS ARE IN MILLIMETERS AND INCHES.   | |
| 2. COOLING TOWER DIMENSIONS ARE SPECIFIC FOR 40' HIGH CUBE CONTAINER   | |
| <b>ENAR PETROTECH SERVICES (PRIVATE) LTD.</b><br>A COMPANY OF<br>TEL: 5062791 FAX: 5067522 KARACHI-PAKISTAN  |                         | Job No. <b>14-4985</b><br>   |         |          | <table border="1"> <thead> <tr> <th>REV</th> <th>DESCRIPTION</th> <th>DRAWN</th> <th>CHECKED</th> <th>APPROVED</th> <th>DATE</th> </tr> </thead> <tbody> <tr> <td>04</td> <td>AS BUILT</td> <td>NM</td> <td>NM</td> <td>AV</td> <td>18.09.2013</td> </tr> <tr> <td>03</td> <td>REVISION AFTER COMMENTS</td> <td>NM</td> <td>NM</td> <td>AV</td> <td>05.04.2013</td> </tr> <tr> <td>02</td> <td>REVISION AFTER COMMENTS</td> <td>NM</td> <td>NM</td> <td>AV</td> <td>08.03.2013</td> </tr> <tr> <td>01</td> <td>GENERAL REVISION</td> <td>NM</td> <td>NM</td> <td>AV</td> <td>25.02.2013</td> </tr> <tr> <td>00</td> <td>ISSUED FOR APPROVAL</td> <td>NM</td> <td>NM</td> <td>AV</td> <td>20.12.2012</td> </tr> </tbody> </table> |                         |  |         | REV      | DESCRIPTION | DRAWN | CHECKED | APPROVED | DATE | 04 | AS BUILT | NM | NM | AV | 18.09.2013 | 03 | REVISION AFTER COMMENTS | NM | NM | AV | 05.04.2013 | 02 | REVISION AFTER COMMENTS | NM | NM | AV | 08.03.2013 | 01 | GENERAL REVISION | NM | NM | AV | 25.02.2013 | 00 | ISSUED FOR APPROVAL | NM | NM | AV | 20.12.2012 |
| REV  | DESCRIPTION             | DRAWN  | CHECKED | APPROVED | DATE        |       |         | 04   | AS BUILT                | NM   | NM      | AV       | 18.09.2013  |       |         | 03   | REVISION AFTER COMMENTS | NM   | NM      | AV       | 05.04.2013  |       |         | 02   | REVISION AFTER COMMENTS | NM   | NM      | AV       | 08.03.2013  |       |         | 01   | GENERAL REVISION        | NM   | NM      | AV       | 25.02.2013  |       |         | 00   | ISSUED FOR APPROVAL     | NM   | NM      | AV       | 20.12.2012  |       |         | <b>BELLELLI ENGINEERING S.p.A.</b><br>Via Antonio Meucci 232 - 45021 BADIA POLESINE (RO)<br>Tel. 0039.0425.595.074 - Fax. 0039.0425.590.312<br>www.bellellieng.com / info@bellellieng.com  |                         | UCH-II DEVELOPMENT PROJECT<br>DOCUMENT TYPE<br>DOCUMENT NUMBER<br>GENERAL ARRANGEMENT OF COOLING TOWERS 300/310 CT101<br>3-CT101-ME-DW-017 |         |          | BELLELLI PROJECT CODE  | LOCATION                | PLANT  | SCALE   | SHEET    | REV No.     |       |         | 1896-12  | PAKISTAN                | AMINE GAS SWEETENING UNIT  | -       | 3 of 3   | 04          |       |         
|   |  |  |
|---|--|--|
| <b>BELLELLI ENGINEERING S.p.A.</b><br>COOLING TOWER TYPE TG/Q2/43/HT/S/CONT<br>OVERALL DIMENSIONS<br>PART NAME : AUTOCAD / TG-Q2/43/HT/S/CONT | ILMED IMPIANTI S.r.l. Viale dei Mareschi,15<br>35051 Avigliana (TO) Tel:+39 011 9325555<br>www.ilmed.it<br>31/11/2012<br>1275567_5618<br>12989 IMP/I | AV<br>NM<br>NM<br>A1<br>3/3<br>1275567_5618<br>12989 IMP/I |
|---|--|--|