





Type	F	M1	F	F	F
Equipment Tag No.	E-8001	P-8301A	K-8601B	PU-9801	AC-1GT
Description	Power Distribution Cabinet	Slop Pump-A	Instrument Air Compressor	Chemical Injection Package Unit	Sale Gas Compressor (1# GT) - (MCC-31)
Power Rating (kW/A)	350/631.5	11/19.8	90/162.4	3/5.4	172/311
Schematic Type	---	S51	---	---	---

C	Revised	-07-16	Sulaiman	Date	-10-15	Descon Engineering Ltd.	SIEMENS	102-MCC-03	SB No. 3-4565200	P.O.No.8-3211617	Sh. 1
B	Revised	-02-16	Kamran	Worked	Kamran	OGCD KPD-TAY Project					
D	ASBULT	01-17	RA	Checked	Burhan						
Index	Alteration	Date	Name	Approved	Shanil	Item: 03					
		1		2		3	4	5	6	7	8
						Quantity: 01	Switchboard Engg.	Single Line Diag.	SBE No. A6585	(3)G76003-A6585-S112-D	7 Shs.


D	
J	
A	

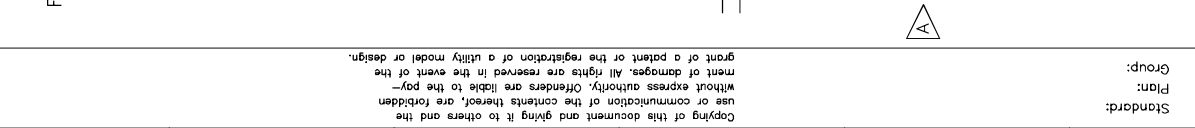

 

--	--	--	--	--


	Sh. 3
	7 Shs.

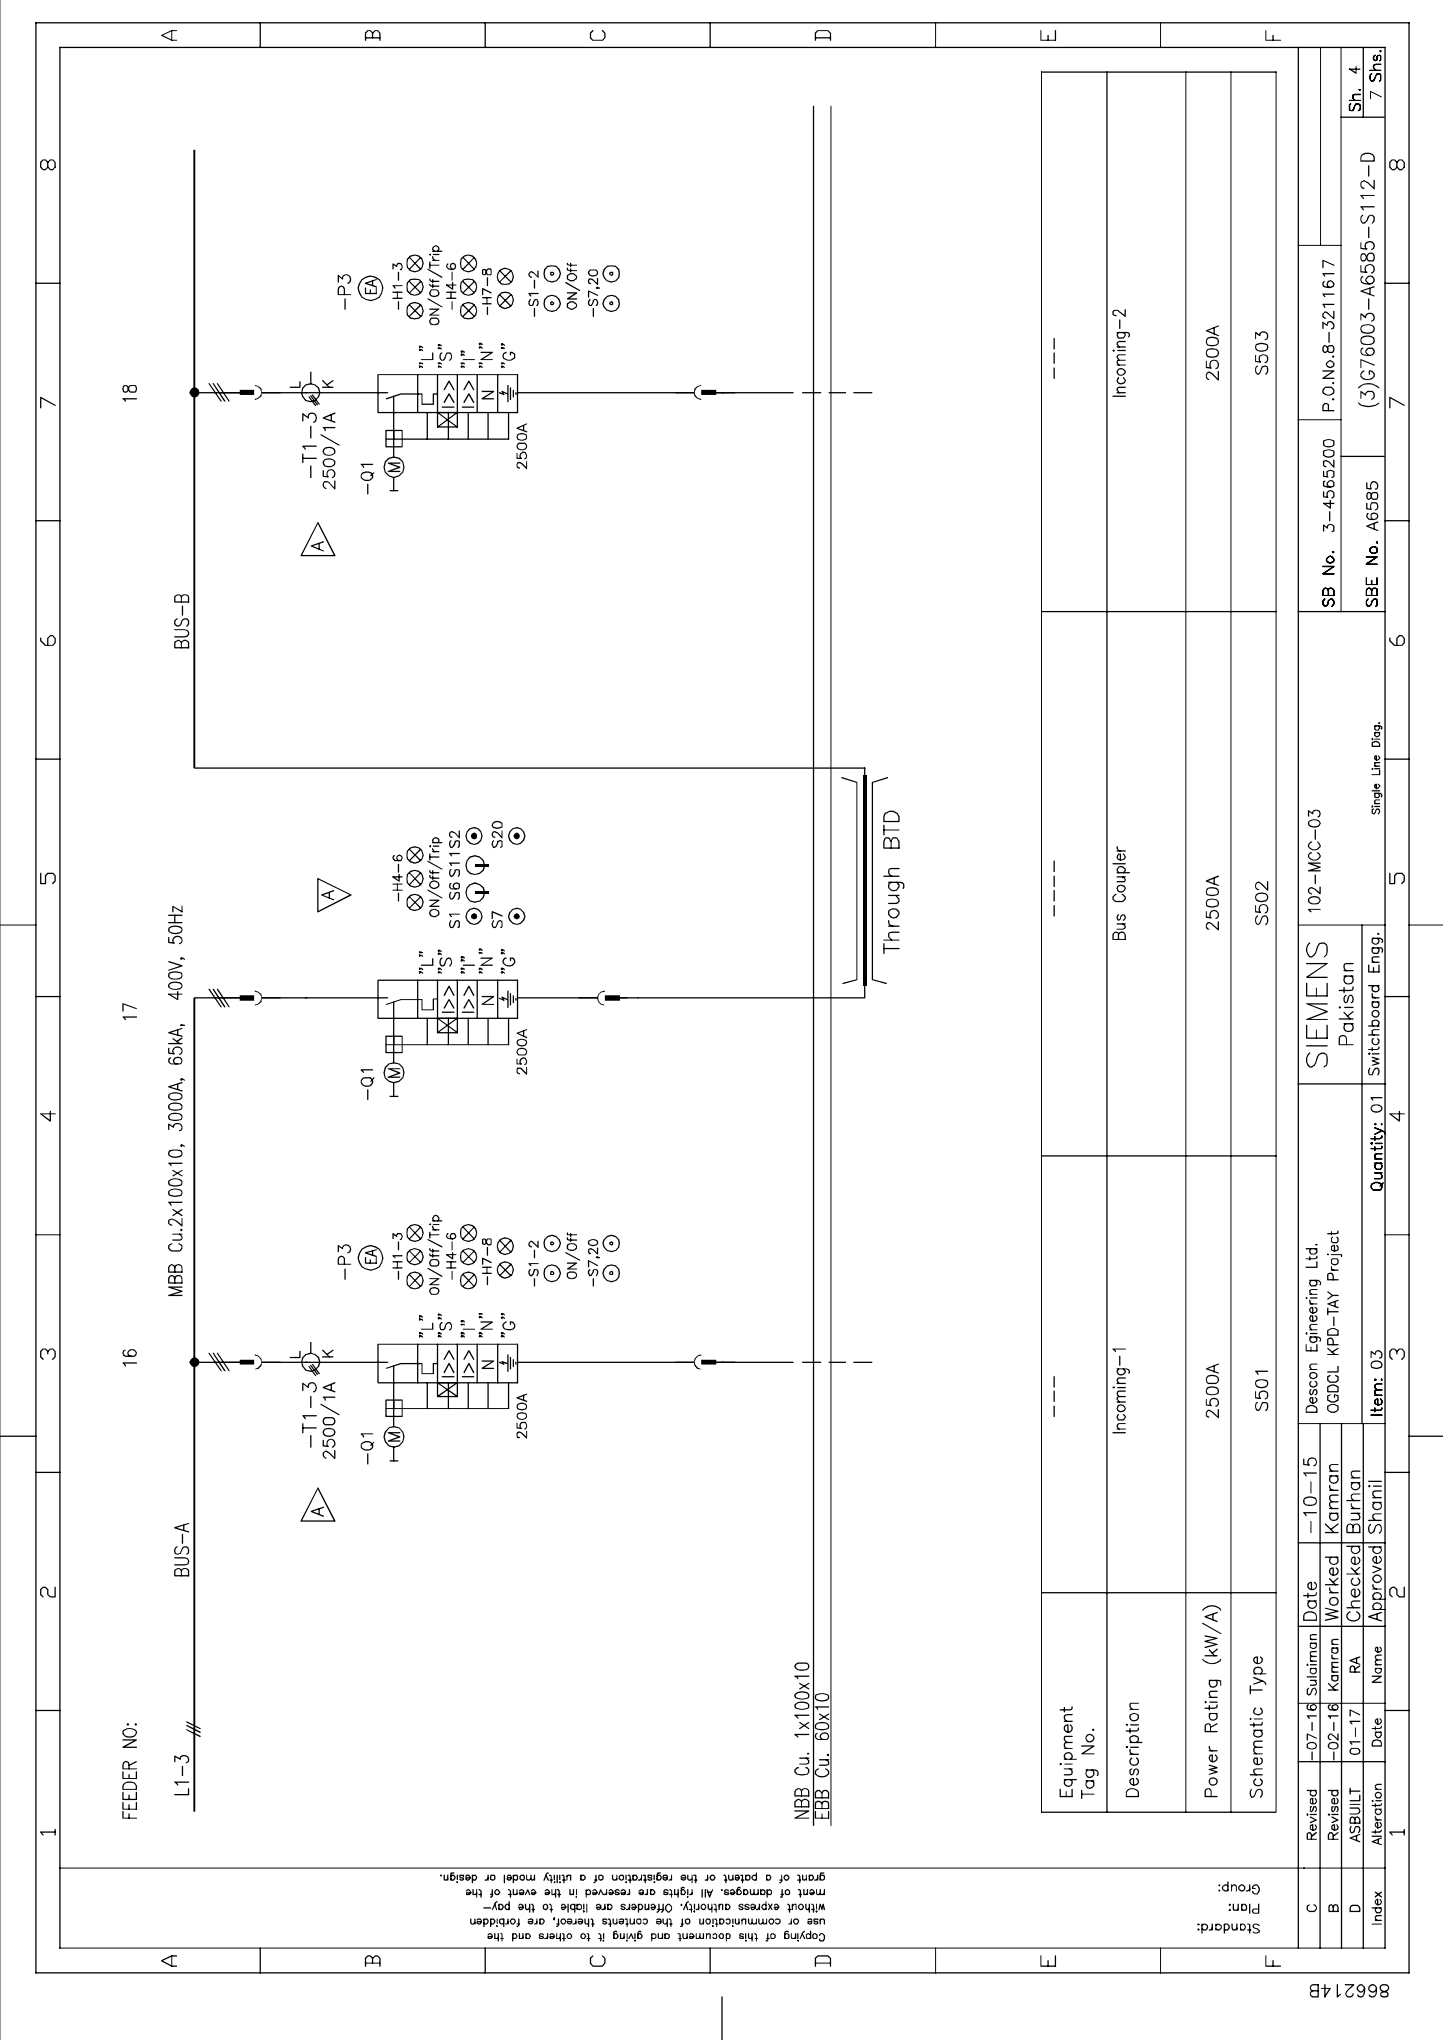

Copying of this document and giving it to others and the use or communication of the contents thereof, are forbidden without express authority. Offenders are liable to the payment of damages. All rights are reserved in the event of the grant of a patent or the registration of a utility model or design.


Equipment Tag No.	---	---	---
Description	Incoming-1	Bus Coupler	Incoming-2
Power Rating (kW/A)	2500A	2500A	2500A
Schematic Type	S501	S502	S503

C	Revised	-07-16	Sulaiman	Date	-10-15	Descon Engineering Ltd.	SIEMENS Pakistan	102-MCC-03	SB No. 3-4565200	P.O.No.8-3211617	Sh. 4				
B	Revised	-02-16	Kamran	Worked	Kamran	OGDCL KPD-TAY Project									
D	ASBUILT	01-17	RA	Checked	Burhan										
Index	Alteration	Date	Name	Approved	Shanil	Item: 03									
1		2		3		4		5		6		7		8	

 

--	--	--	--	--

D	Sh. 5
	7 Shs.

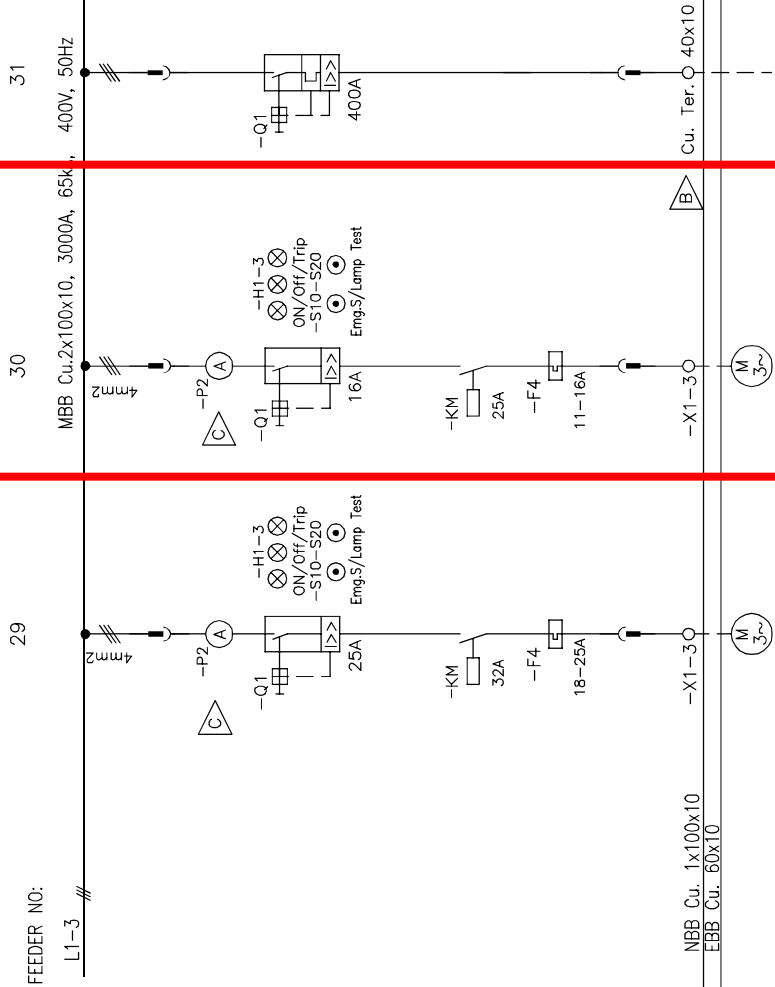

Type	M1		M1	F
Equipment Tag No.	----		----	---
Description	Spare		Spare	Spare
Power Rating (kW/A)	11/19.8		7.5/13.5	-/-
Schematic Type	S51		S51	----

C	Revised	-07-16	Sulaiman	Date	-10-15	Descon Engineering Ltd. OGDCL KPD-TAY Project	SIEMENS Pakistan	102-MCC-03	SB No. 3-4565200	P.O.No.8-3211617			
B	Revised	-02-16	Kamran	Worked	Kamran								
D	ASBUILT	01-17	RA	Checked	Burhan								
Index	Alteration	Date	Name	Approved	Shanil								
1				2		Item: 03	Quantity: 01	Single Line Diag.	5	6	7	8	9
									SBE No. A6585	(3)G76003-A6585-S112-D	Sh. 7	7	Shs. 7

Existing spare motor starter shall be utilized for LP Condensate pump motor. Any modification if required in starter module due to any load variation or additional protection / metering devices required during detailed engineering stage shall be carried out by EPC Contractor.