


NOTES:

1. INLET MANIFOLDS HAVE BEEN PLACED AT GPP LOCATION.
2. MOBILE SCRAPER RECEIVER SHALL BE CONNECTED AT THIS VALVE.
3. INSTRUMENT VALVE MANIFOLD (BLOCK AND BLEED), PART OF INSTRUMENT VALVE ASSEMBLY.
4. DETAIL FOR TYPICAL ARRANGEMENT FOR ALL PRESSURE INSTRUMENTS P1/P2/PSHH/PSLL/PSH/PSL.

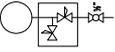


ISSUED FOR CONSTRUCTION

NO.	REV.	DESCRIPTION	BY	CHK.	DATE
1	15-01-2015	ISSUED FOR CONSTRUCTION	AA	K	15-01-2015
2	15-02-2015	ISSUED FOR CONSTRUCTION	AA	K	15-02-2015
3	15-02-2015	RESUBMITTED FOR TENDER	AA	K	15-02-2015
4	15-02-2015	RESUBMITTED FOR TENDER	AA	K	15-02-2015
5	15-02-2015	FINAL ISSUED FOR TENDERS	AA	K	15-02-2015
6	28-02-2015	ISSUED FOR TENDERS	AA	K	28-02-2015
7	28-02-2015	ISSUED FOR TENDERS	AA	K	28-02-2015
Oil & Gas Development Company Ltd.
 CONSULTANT
Zishon Engineers (Pvt.) Ltd.
 AN ISO 9001:2008 CERTIFIED COMPANY

DWG. NO.	165-4-PID-032
REV. CO	
JOB NO.	165-4
SCALE	-
SHEET	2 OF 3

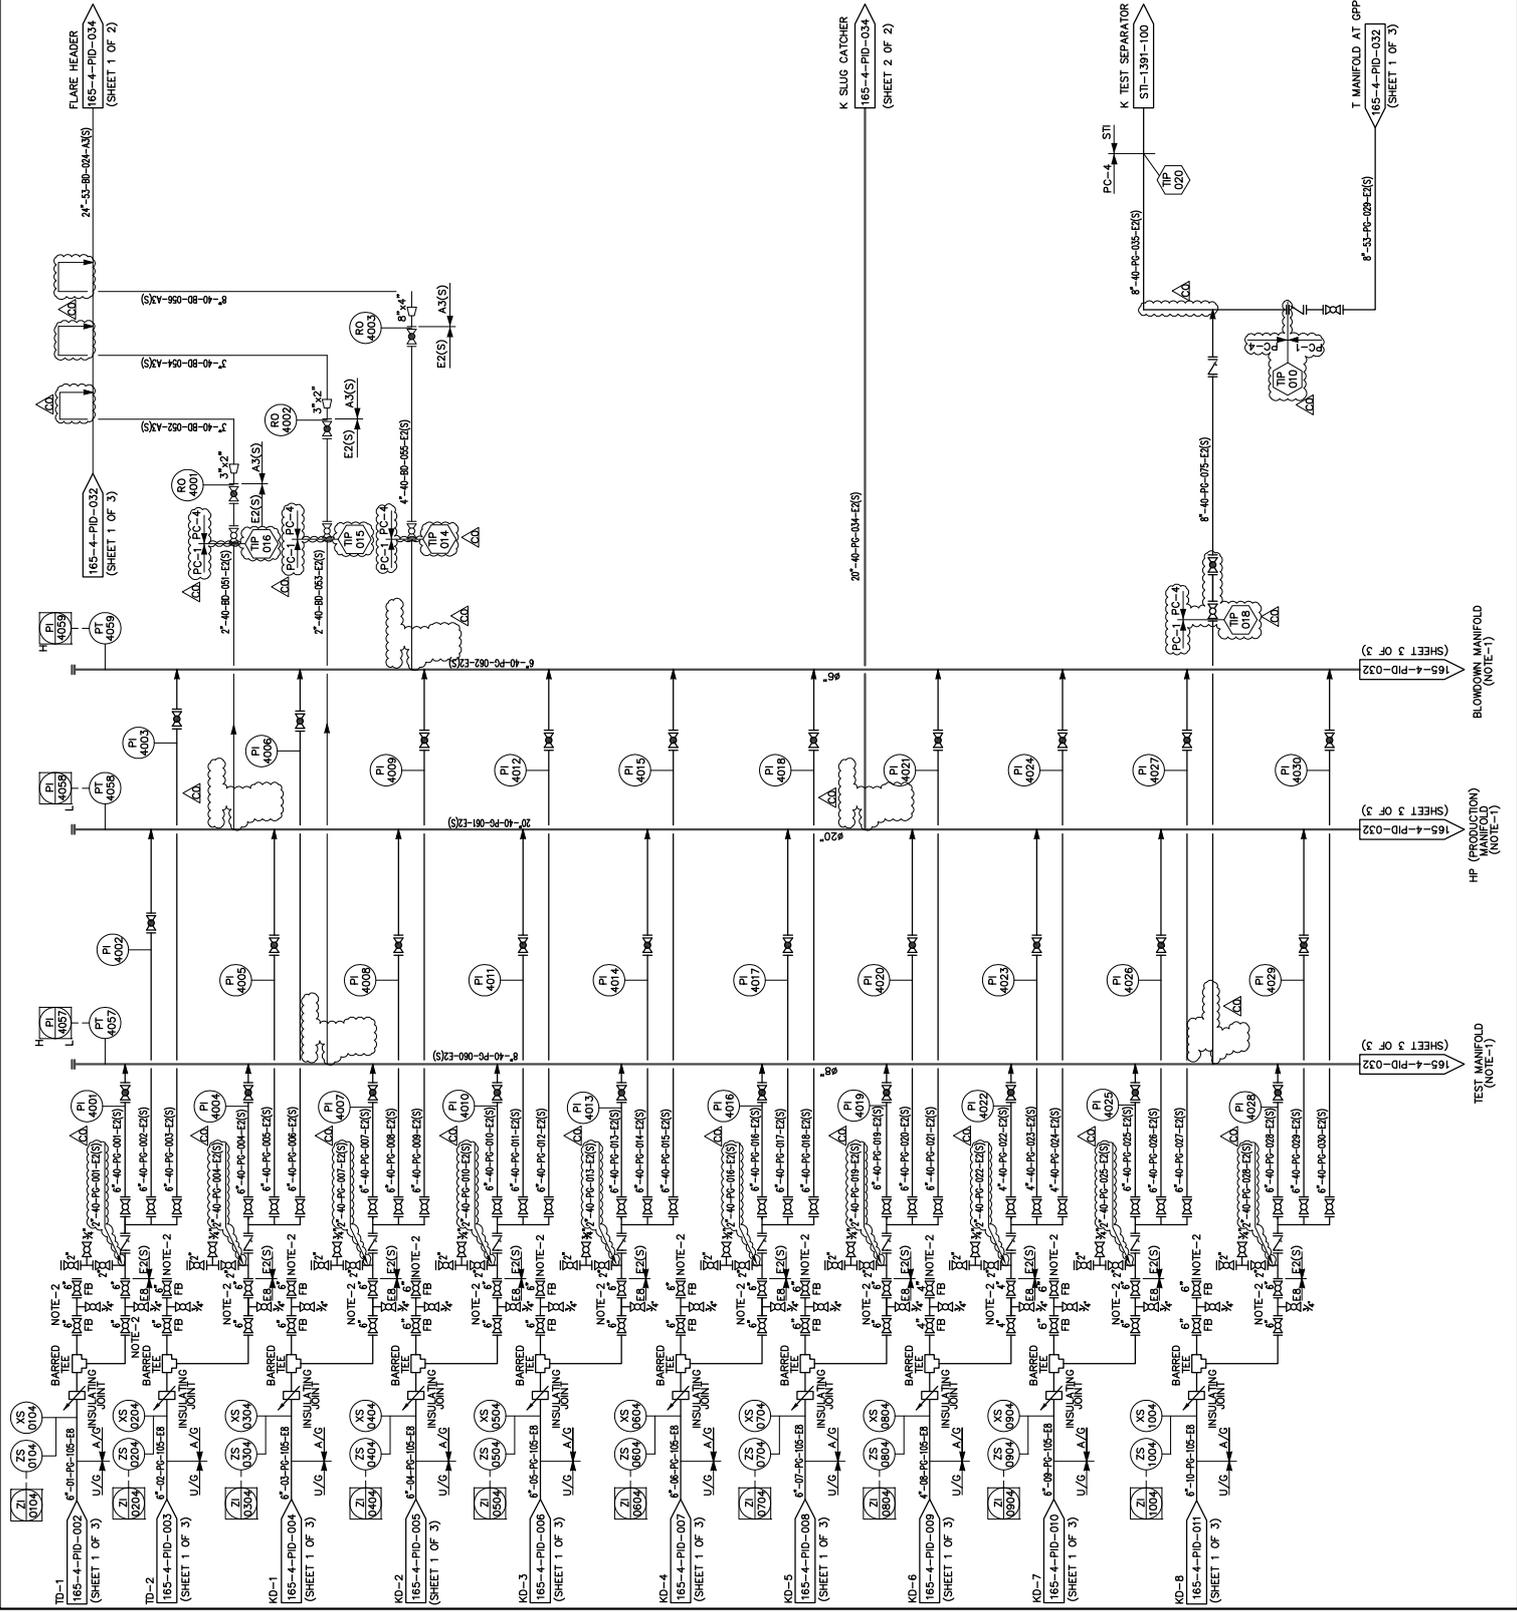

TEST MANIFOLD (NOTE-1)
 HP (PRODUCTION) MANIFOLD (NOTE-1)
 BLOWDOWN MANIFOLD (NOTE-1)

PROJECT : KPD-TAXY INTEGRATED DEVELOPMENT
 TITF : K MANIFOLD AT GPP

