CONCRETE PAVING

100 THK (LIGHT DUTY)

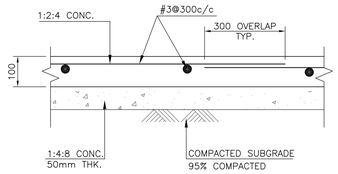

150 THK (HEAVY DUTY)

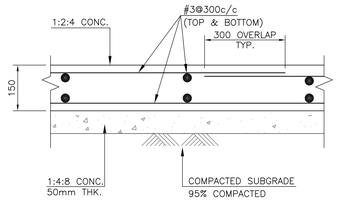

GRAVEL PAVING

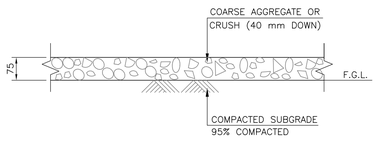

JUNCTION B/W 150THK AND 100 THK CONCRETE PAVING

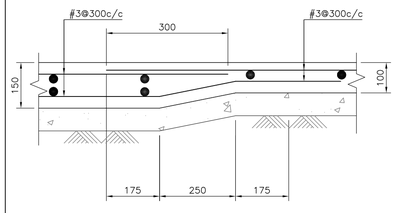

FREE EDGE

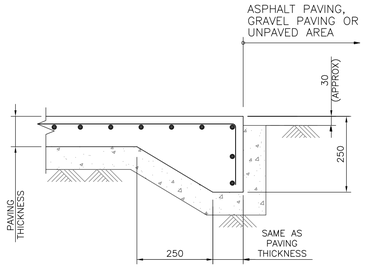

JOINT

EXPANSION JOINT FOR 100 THK CONCRETE PAVING

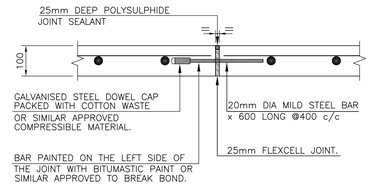

EXPANSION JOINT FOR 150 THK CONCRETE PAVING

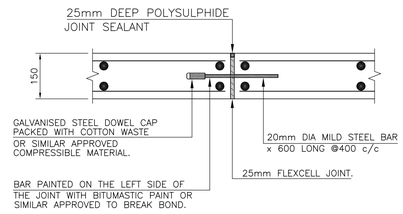

CONSTRUCTION JOINT

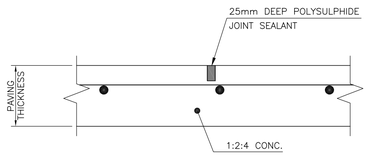

ISOLATION JOINT (GENERAL)

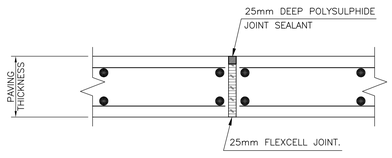

ISOLATION TO PIPE

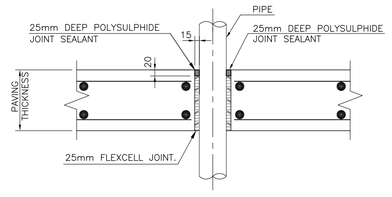

CONCRETE CURB

GENERAL

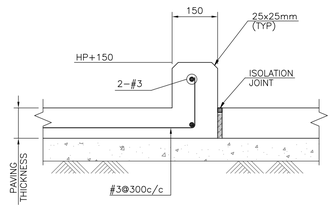

HP = HIGH POINT OF CURBED AREA PAVING

WITH GUTTER, IF REQUIRED

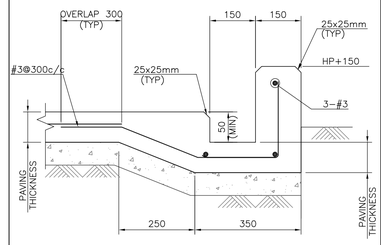

HP = HIGH POINT OF CURBED AREA PAVING

AS BUILT

NOTES:-

1. THIS DRAWING SHALL BE READ IN CONJUNCTION WITH DWG. NO. 165-4-CSTD-001 TO 004.
2. CONCRETE PAVING SHALL BE PROVIDED WITH JOINTS. EXPANSION JOINTS SHALL BE MAX 15m APART CONSTRUCTION JOINTS SHALL BE MAX 6m APART.
3. CONCRETE PAVING AREAS SHALL BE GIVEN A BROOM FINISH, WHICH PERMIT SWEEPING CLEAN.

REV.	DATE	DESCRIPTION OF REVISION	DRAWN	CHECKED	APPR.
F0	26-04-2018	AS BUILT	MSL	MSH	SMM

CLIENT.

OIL & GAS DEVELOPMENT COMPANY LTD.

OGDCL HOUSE TOWER-B, FIRST FLOOR F6/G6, BLUE AREA, JINNAH AVENUE ISLAMABAD PAKISTAN
FAX : +92 051 2623033, PHONE: +92-051-9209859

CONSULTANT.

Zishan Engineers (Pvt.) Ltd.

An ISO 9001-2008 certified company

47/F Block 6, PECHS, Karachi-Pakistan
***Tel:** (92-21) 34393045-48, & 34310151-54, **Fax:** (92-21) 34533430 & 34510156*
***E-Mail:** contact@zishanengineers.com **Website:** www.zishanengineers.com*

DWG. NO. 165-4-CSTD-015 REV. F0

PROJECT : KPD-TAY INTEGRATED DEVELOPMENT, PROJECT PHASE-II

JOB NO. 165-4

TITLE : STANDARD DRAWING OF PAVING DETAIL

SIZE	SCALE	SHEET
A1	N.T.S.	1

X:\165-OGDC\165-4 (KPD-TAY)\CIVIL\AS BUILT\FINAL AS BUILT\26-04-2018\DWG\CIVIL\CSTD DWGS\165-4-CSTD-015_RF0.dwg Apr 26, 2018 - 5:54pm ZEL-COMP103