OIL & GAS DEVELOPMENT COMPANY LIMITED



TENDER ENQUIRY NO. SER/CB/P&P-6400000023/2022
HIRING OF SERVICES FOR REPAIR OF DE-GASSER VESSEL (V-9710) AND
CONDENSATE WATER SEPARATOR VESSEL (V-2013) INSTALLED AT QADIRPUR
PLANT

Note:

Bid bond of PKR 155,000/- (Pak Rupees One Hundred Fifty Five Thousand only) must be submitted with the bid. The master set of tender documents (services) uploaded on OGDCL website (www.ogdcl.com) is the integral part of this TOR.

TERMS & CONDITIONS FOR HIRING OF SERVICES FOR REPAIR OF DE-GASSER VESSEL (V-9710) AND CONDENSATE WATER SEPARATOR VESSEL (V-2013) INSTALLED AT QADIRPUR PLANT

WORK SCOPE EXPLANATORY NOTES FOR CONTRACTOR:

- 1- The Owner, Oil & Gas Development Company Limited (OGDCL) is interested in inviting bids for the provision of services at its Qadirpur Gas Plant for repair of De-Gasser Vessel (V-9710) and Condensate Water Separator Vessel (V-2013) installed at Qadirpur Plant from reputable companies in this field.
- 2- The Contractor shall quote separate rate for each activity against the quantities.
- 3- The work shall be done, completed in all respects in accordance with the requirements and Owner's instructions/satisfaction.
- 4- The Quantities contained in the scope of work for each activity are estimated and liable to change (increase, decrease or omitted) at the time of work execution. The Owner does not expressly or by implication guarantee that actual quantities of work to be performed will correspond to the scope of work submitted with this tender document. The payment to be made to the Contractor shall be based on the actual quantity of work performed. OGDCL reserves the right to change (increase/decrease) the scope of the work at any time keeping in view the operational requirements. In such case, quoted unit rates will be applicable.
- 5- The Contractor shall be responsible for carrying out all work, complete in all respects, according to the scope of work. Any item of work required for completion but not expressly indicated in the scope shall be deemed to have been included in the unit rates quoted by the Contractor.
- 6- Repair work to be carried out at Contractor's facility. Accordingly, Vessels will be shifted to the contractor's facility where repair works are to be carried out on a fast track basis.
- 7- Unit rates quoted by bidder shall be firm. No extra payments on account of escalation in prices due to any reason shall be admissible.
- 8- The Contractor shall be paid only for the work duly approved by Owner's representative. Any rework due to poor quality, demonstrated by NDT results & inspection by OGDCL shall be on Contractor's account.
- 9- Contractor must understand to confirm the provided scope of work by OGDCL for bidding and may visit site for clarification of scope (if any).

10- Contract duration will be **one (01) year** however Job will be performed within **sixteen 16 weeks** from handing over of the vessels including time required for transportation to and from Qadirpur.

CONTRACTOR'S RESPONSIBILITIES:

- 1- Contractor shall provide plan of activities in advance and engage only certified staff for the repair jobs.
- 2- Transportation of Vessel to and from Qadirpur Gas Field to Contractor Workshop.
- 3- Arrangement of Transportation Vehicle (including Fuel) for Transportation of Vessel.
- 4- Contractor will bear all expense(s)/damage(s) during transportation and loading/unloading of vessels at its Facility.
- 5- Arrangement for loading / unloading of Vessel at Contractor workshop i.e. Crane, Rigger and Lifting Tools etc. will be contractor's responsibility.
- 6- Contractor will hire certified crane operator, scaffolder, rigger, drivers, welders, fabricators etc.

OGDCL's SCOPE:

- 1- Isolation/Cleaning of vessel as per job requirement.
- 2- Dismantling of Vessel from system, Removal of accessories and Blinding / De-Blinding of Vessel.
- 3- Loading / Unloading of Vessels at Qadirpur site including provision of Crane, Lifting Tools, Rigger etc. is OGDCL's responsibility.
- 4- Permit to Work system, Rigging Plan etc. will be OGDCL's responsibility.
- 5- Installation of Vessel and all related accessories & pipelines etc. after repair will be OGDCL's responsibility.

CONTRACTOR SCOPE OF WORK FOR V-2013:

- 1- Contractor will be responsible for repair of Vessel as per repair plan provided by client in every aspect and form.
- 2- Inspection and Test Plan in compliance of API 510 Requirements (WPS/PQR, Repair Procedure, Hydrogen bake out procedure, Weld Joint Details etc.) approved by API 510 inspector.
- 3- Procurement of insert patch plate material. Contractor will provide MTC of all Purchased material. Client will perform inspection of material prior to start of job. (Hold Point).
- 4- New Plate Rolling according to Vessel Diameter.
- 5- Removal of Belzona Coating & Surface preparation of only damaged area.
- 6- Surface Preparation, Cutting of existing patch according to new patch dimensions (See Repair Sketch of Vessel), Fabrication and Welding of New Insert Patch.

- 7- Welding (Back pass) using SMAW or GTAW as per API 510 and ASME-PCC-II guidelines to cater Root Corrosion of Circumferential Seam Welds (CS-01,CS-02 and CS-04).
- 8- Preheat & PWHT as per code requirements (only for replaced patch plate portion and weld repairs).
- 9- FFS Inspection of Vessel by API 510 Inspector.
- 10- Preparations and Execution of Hydro test @ MAWP (150 psig) of Vessel after Repair. Client will be informed priorly to witness the Hydro test of Vessel. (Hold Point)
- 11- Repair nameplate with date and necessary details as required by API 510.
- 12- Repair of Belzona Coating over replaced section only and weld seams.
- 13- Sand Blasting/Painting(One Coat Primer + Enamel Painting) of complete Vessel (externally) after Repair.
- 14- Preparation of RAR form as per API 510 requirement.
- 15- Submission of QC dossier for complete job.
- 16- Job to be completed within 16 weeks of Handing over of Vessel including time required for transportation to and from Qadirpur.

CONTRACTOR SCOPE OF SERVICES V-9710:

- 1- Contractor will be responsible for repair of Vessel as per repair plan provided by client in every aspect and form.
- 2- Inspection and Test Plan in compliance of API 510 Requirements (WPS/PQR, Repair Procedure, Hydrogen bake out procedure, Weld Joint Details etc.) approved by API 510 inspector.
- 3- Procurement of Dish End, Drain Nozzle and all related material. OGDCL will perform inspection of material prior to start of Job. (Hold Point).
- 4- Cutting and Reinstallation of Skirt to Bottom Dish Weld Joint.
- 5- Cutting of shell to bottom Dish butt weld joint, surface preparation and perform hydrogen bake out (if required) as per API 510 and ASME PCC-II guidelines.
- 6- NDT (DPT,RT,PAUT) as per code requirements.
- 7- Preheat & PWHT as per code requirements (only for replaced dish end portion and weld repairs).
- 8- FFS Inspection of Vessel by API 510 Inspector.
- 9- Preparations and Execution of Hydro test @ MAWP (162psig) of Vessel after Repair. OGDCL will witness the Hydro test after completion of repair job. (Hold Point).
- 10- Repair nameplate with date and necessary details as required by API 510.
- 11- Sand Blasting/Painting(One Coat Primer + Enamel Painting) of complete Vessel (externally) after Repair.

- 12- Preparation of RAR form as per API 510 requirement.
- 13- Submission of QC dossier for complete job.
- 14- Job to be completed within 16 weeks of Handing over of Vessel including time required for transportation to and from Qadirpur.

Bidder/Contractor Qualification Criteria:

Sr. #	Evaluation Item	Description of Criteria	Max. Marks / Calculations	Maximum Marks	Minimum Qualifying Marks	Remarks
1.	Contractor strength to execute repair job.	Contractor should have min. 05 years' experience for repairing of vessels in oil & gas / petrochemical industry.	15 years exp.: 20 10 years exp.: 15 05 years exp.: 10 Less than 05 years exp.: 0	20	10	The Contractor should submit the detailed of scope of work (especially vessel's details) along with supporting documents to prove the relevant experience.
2.	Previous Service Order between 2012 ~2022	05 No's Refurbishment/ New Manufacturing of Pressure vessels with similar/ higher capacity have been performed (10Marks) 03 No's Refurbishment/ New Manufacturing of Pressure vessels with similar/ higher capacity been performed (06 Marks)	Provide the purchase/service orders with their details	10	06	
3.	Certifications.	Contractor should provide following valid certificates; 1. ISO 9000 certification: 2. ASME U/R-Stamp 3. PEC Registration	1. 02 Marks 2. 03/03 Marks 3. 02 Marks	10	10	Contractor should submit the valid copy of certificates. If the certificate status is in progress no marks shall be given.
4.	Offices, Workshop, Tools, Equipment, Machinery, Infrastructure.	Contractor should have following facilities with in Pakistan. 1. Certified Workshop 2. Cranes, fork lifters. 3. Welder's Qualification	05 Marks 03 Marks (02 + 01) 02 Marks	10	09	

10	
2.2.2	All three trades must
06	qualify min. marks.
	0 marks in any of the
	trade will disqualify
	the category even if
	other trades score 06
	marks as Total
	CV's to be provided
	with experience
	certificates.
	Less than 05 years: 0
	Marks
10	Bidder should submit
10	
	supervisor.
10	The contractor
	should submit the
	complete compliance
	certificate with the
	bid, any deviation
	from term and
	condition is not
	acceptable.
_	2+2+2 = 06 10

Total Marks= 100 Minimum Qualifying Marks = 71

Note:

- 1. Contractor should get minimum qualifying marks in each category as mentioned in above table. Contractor will not be qualified if above mentioned minimum qualifying marks in any category will not be scored by the contractor. In addition, the total marks should also be not less than 71. Any contractor who will score less than 71 marks shall not be considered for evaluation.
- 2. Contractor must have five years' total experience of providing ASME coded vessel repair services. Contractors having experience less than five years will be disqualified & shall not be considered for evaluation even they score marks more than 71 as per above tabulated criteria.
- 3. In case of JV, JV agreement to be provided by contractor. Experience of both JV partner will be not added together for marks calculation.

Financial Bid Format / Evaluation Criteria:

Sr.#	DESCRIPTION	QTY.	PRICE (PKR)
1	Services cost for repair of De-Gasser Vessel (V-9710) as per repair	Lump	
	scope and TOR's (inclusive of all types of material, equipment's,	sum	
	tools, machinery, consumables, transportation etc.)		
2	Services cost for repair of Condensate water separator Vessel (V-	Lump	
	2013) as per repair scope and TOR's (inclusive of all types of	sum	
	material, equipment's, tools, machinery, consumables,		
	transportation etc.)		
TOTAL			

Notes:

- 1. The prices should be inclusive of all applicable taxes, duties, levies, charges etc. except PST/ICT.
- 2. OGDCL reserves the right to delete / cancel any activity mentioned in the scope. At the time of job execution, they will be informed about such deletion/cancellation of activity and payment will be adjusted accordingly.
- 3. No Advance payment will be made at the time signing the contract
- 4. Contract will be awarded to financially lowest evaluated bidder on complete package basis.
- 5. Payment will be made after submission of completion certificate and verified invoices duly signed by Field Manager, Relevant section Incharges at Qadirpur.
- 6. Commercial Invoice should be submitted with the activity list with pricing verified by filed official.
- 7. Sales Tax invoice with Annexure 'C' must be provided.

Other Important Information

a. BIDDING METHOD

Bids against this tender are invited on 'Single Stage Two Envelop".

b. BID PRICE

- i. Bid price shall be inclusive of all taxes, duties, levies, charges etc., except Provincial Sales Tax (PST)/ Islamabad Capital Territory Sales Tax (ICT) in Pakistan.
- ii. The prices should be quoted in PKR.

c. AMOUNT OF BID BOND

Bid Bond /Bid Security amounting to **PKR 155,000.00** is to be attached / provided with the technical bid. Please see Master Set of Tender Document for further details.


d. MANDATORY REQUIREMENT


For online payment to vendors/contractors through (IBFT & LFT) following info is required:


- 1. IBAN (INTERNATIONAL BANK ACCOUNT NUMBER 24 DIGITS).
- 2. VENDOR NAME AS PER TITLE OF THEIR BANK ACCOUNT.
- 3. NTN NO.
- 4. CONTACT # OF COMPANY CEO/OWNER (MOBILE & LANDLINE).
- 5. POSTAL ADDRESS.
- 6. BANK NAME.
- 7. BANK BRANCH NAME & ADDRESS.

The master set of tender documents (services) uploaded on OGDCL's website (<u>www.ogdcl.com</u>) is the integral part of this TOR.

Bidders are requested to read TOR & Master Set to Tender Documents (Services) and provide complete information / documents including tender annexures with the bid.

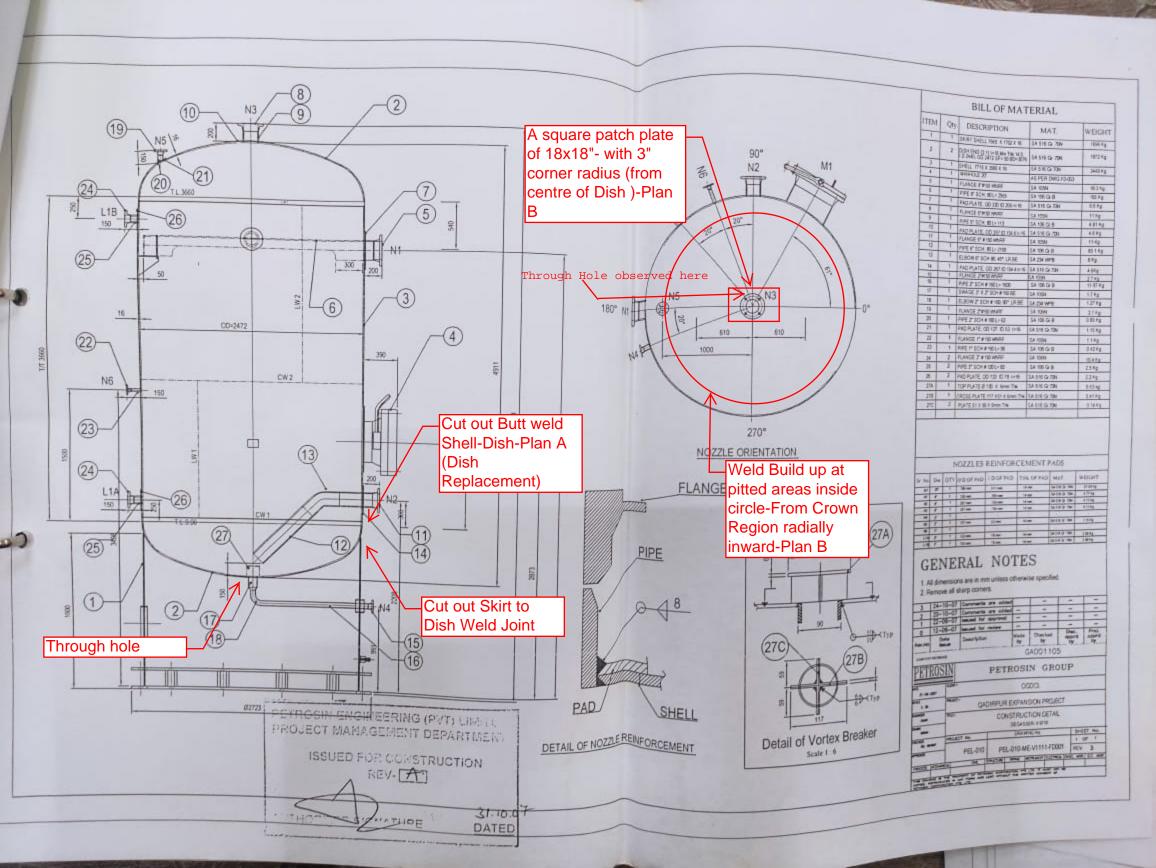

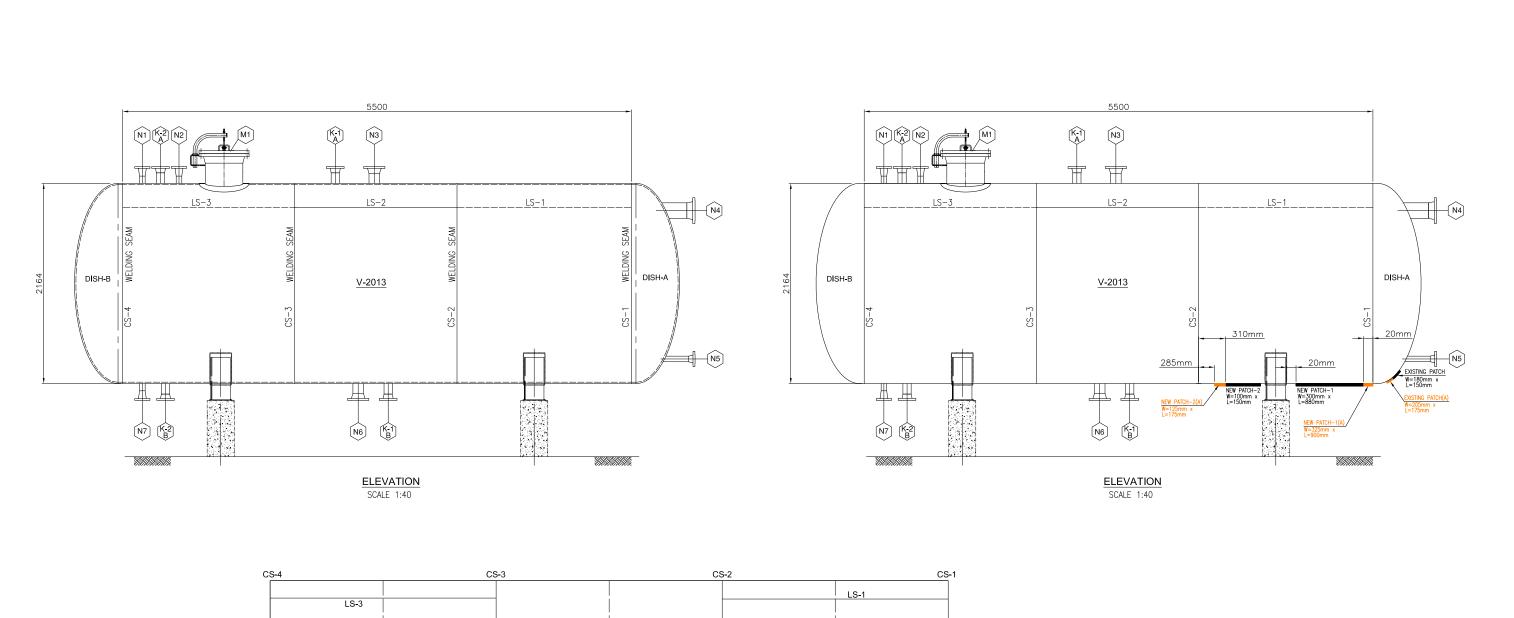

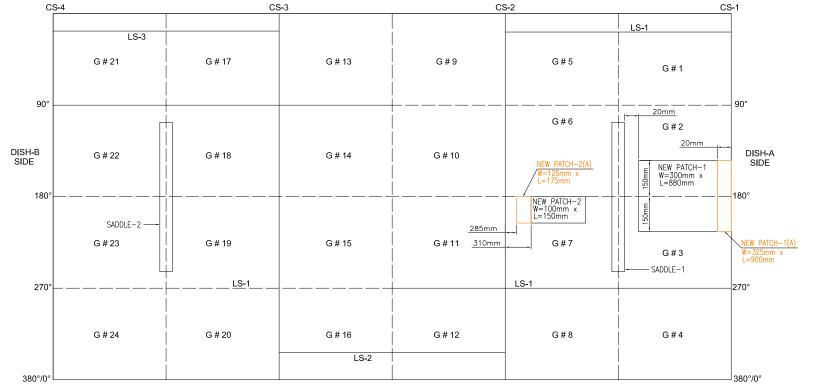

WELDING SEAM DETAIL

SCALE 1:30

NOTE:

1. ALL DIMENSIONS ARE IN MM, UNLESS SPECIFIED.

I I								
02-01-2022		ISSUE	ED FOR REVIEW	NU	NA	M.HA		
02-01-2022			AS-BUILT	NU	QSA	M.HA		
DATE		DESCR	PIPTION OF REVISION	PREP'D:	CHECK	APPR.		
CONTRACTOR: VELOSI Integrity & Safety Pakistan (Pvt.) Ltd. Engineering For A Safet World 401, 4th floor Plot No.19-A-1 Block-6 PECHS, Karachi, Pakistan CLIENT: OIL & GAS DEVELOPMENT COMPANY LTD.								
TITLE : V-2013 REPAIR								
LOCATION: QADIR PUR								
PROJECT CODE : VISP-031-0120								
DRAWING NO VISP-031-0120-V-2013			SHEET NO 1 OF 1	SCALE AS SHOWN	SHEET SIZ	ZE	REV 1	
