


40
ONE (1) - REQUIRED
FRONT CHANNEL COVER GASKET
1/8" THK. STL. DOUBLE JACKETED
W/ FLEXIBLE GRAPHITE FILLER.

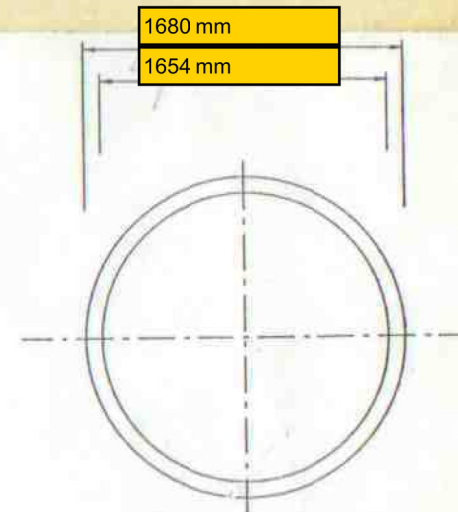

40
ONE (1) - REQUIRED
REAR CHANNEL COVER GASKET
1/8" THK. STL. DOUBLE JACKETED
W/ FLEXIBLE GRAPHITE FILLER.

NOTES:

- 1) QUANTITIES SHOWN FOR ONE (1) SET
THREE (3) SETS REQUIRED TOTAL.
ONE (1) SET OF GASKETS TO BE USED IN EXCH. AND
TWO (2) SETS TO BE BOXED, MARKED WITH
P.O. & ITEM NO. & SHIPPED WITH EXCHANGER.
- 2) ALL JACKETED GASKETS TO HAVE
LAP OF GASKET NEAR SIDE.

| | | | | | |
|----|-------------------------|-----|------|----------|----------------------------------|
| | | | | | CUSTOMER: PETROSIN |
| | | | | | OHMSTEDE JOB NO.: 658313 |
| | | | | | P.O. NO.: P181/8882 |
| | | | | | ITEM NO.: 18-E-281/28-E-281 |
| | | | | | SERVICE: AMINE STRIPPER REBOILER |
| | | | | | (2) UNITS REQ'D. |
| 1 | RELEASE FOR FABRICATION | MS | DC | 3-7-97 | GASKET DETAILS |
| 8 | FOR CUSTOMER APPROVAL | JSS | DC | 1-7-97 | |
| NO | REVISIONS | BY | CHK. | DATE CHK | |
| | | | | | OHMSTEDE |
| | | | | | DRAWING NO. 658313 |
| | | | | | SHEET NO. 12 |
| | | | | | REV. 1 |