
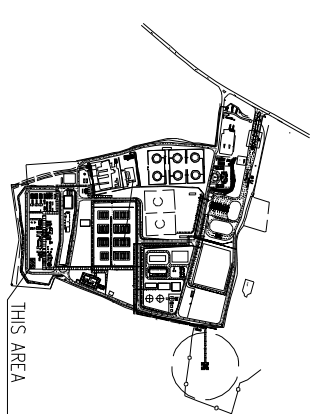


PLEASE SEE CABLE ROUTING LAYOUT
FOR GENERAL AREA
NGP-000-ELE-15.01-0002-00

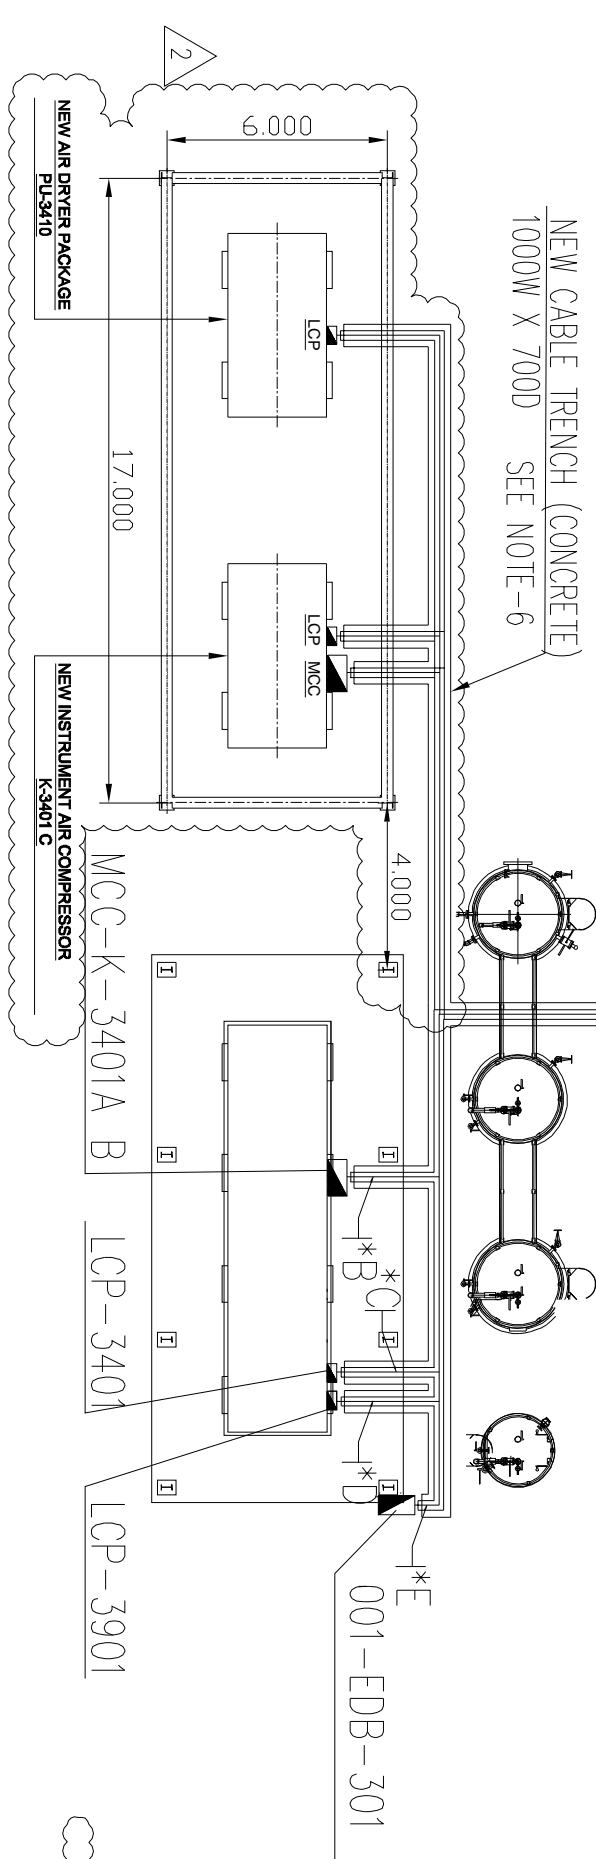

1. ALL DIMENSIONS ARE IN MILLIMETERS, ALL COMPONENTS AND ELEMENTS ARE IN METERS, UNLESS OTHERWISE SPECIFIED.
5. THE ELECTRICAL CONTROL PANEL WILL BE INSTALLED ON THE FLOOR OF CONCRETE SLAB. THE HEIGHT OF SECTION TO FLOOR IS 0.9M.
6. EXISTING CABLE TRENCH AND CABLE TRAY SHALL BE UTILIZED FOR LAYING OF ELECTRICAL NEW CABLES. ALSO EXISTING CONCRETE TRENCH SHALL BE EXTENDED BY EPC CONTRACTOR UP TO NEW INSTRUMENT AIR COMPRESSOR & AIR DRYER PACKAGES.

EQUIPMENT LIST				
EQUIPMENT NO.	EQUIPMENT DESCRIPTION AND CAPACITY	UNIT	QTY	REMARK
18-SDB-001	Shed Lighting SDB	Sdb	1	
WC-K-3401	Instrument Air Compressor Power Panel	Sdb	1	
PLC-K-3401	Instrument Air Compressor Control Panel	Sdb	1	
K-3401	Instrument Air Compressors	Sdb	1	


REFERENCE DOCUMENTS	
TITLE	DOC No.
Overall Plot Plan	NCP-000-GEH-15-01-0001-00
Cable Routing Layout for General area	NCP-000-ELC-15-01-0002-24
Electrical Typical Installation for Cabling	NCP-000-ELC-15-08-0005-00
Electrical Symbols and Legends	NCP-000-ELC-15-08-0001-00


							F
DA	Approved for Construction	Xu Tao	Ga Jing Huo	Bai Bojin	Cheng Xin	01/12/2016	
DD	Issued for Review	Xu Tao	Ga Jing Huo	Bai Bojin	Cheng Xin	30/06/2016	
A	Internal Design Check	Xu Tao	Ga Jing Huo	Bai Bojin	Cheng Xin	20/06/2016	
REV.	DESCRIPTION	PBRD	CMAD	RCDN	APPD	DATE	

CLIENT

OIL & GAS DEVELOPMENT COMPANY LTD.


 ENAR PETROTECH SERVICES (PRIVATE) LIMITED Plot No. 7-B, Sector-7A, Korangal Industrial Area Email: cbd@enar.com.pk Website: enar.pk	ENAR PRODUCT NO.
	14-0193

CONSULTANT

Zishan Engineers (Pvt.) Ltd.
An ISO 9001:2008 certified company
E-Mail: corporate@zishanengineers.com www.zishanengineers.com

CONTRACTOR	PROJECT NO.
HONG KONG HUIHUA GLOBAL TECHNOLOGY LIMITED	MA5IPA 1247

PROJECT TITLE	DRAWING NO.
NASHPA GAS PROCESSING AND LPG RECOVERY PLANT PROC-F-C-NASH-PA/PROJ-12/17/2015	MP-001-EE-15-01-5002-17