


GENERAL NOTES

1. ALL DIMENSIONS, COORDINATES AND ELEVATIONS ARE IN METERS, UNLESS OTHERWISE SPECIFIED.
2. ALL COORDINATES ARE BASED ON UTM PROJECTION, GRID ZONE 42N, WGS 1984 DATUM. LEVELS TAKEN W.R.T BS-01. COORDINATES TAKEN WITH SATELLITE. PROJECTION SCALE FACTOR 1.000.
3. REFERENCE POINT IS BS-01. N=3683280.201m; E=714621.147m; ELEVATION=565.447m.
4. THIS DRAWING SHALL BE READ IN CONJUNCTION WITH THE FOLLOWING: NGP-000-SCW-15.01-2006-23 GRADING AND VERTICAL PLAN; NGP-000-SCW-15.01-2003-23 ROADS & PAVEMENT LAYOUT; NGP-000-SCW-15.01-2007-23 STONE PITCHING PROTECTION LAYOUT; NGP-000-SCW-15.01-2001-23 STANDARD DRAWING OF ROAD SECTIONS SHOULD BE CHECKED TOGETHER.
5. FOR DETAIL DRAWING OF STORM WATER DRAIN DITCH SHOWN IN REF. NO. NGP-000-SCW-15.01-2010-23.
6. LOCATION AND DETAIL DRAWING OF STORM WATER DRAIN DITCH ALONG WITH STONE PITCHING SHOWN IN REF. NO. NGP-000-SCW-15.01-2007-23.

ISSUED FOR APPROVAL
(MODIFIED UNDER PROJECT #14-0193)

LEGEND

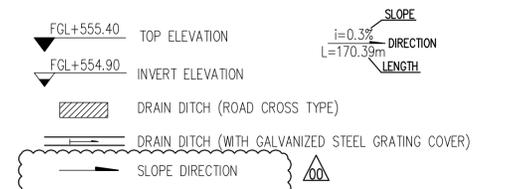

REFERENCE DOCUMENTS

TITLE	DOC No.
GENERAL PLOT PLAN	NGP-000-GEN-15.01-0001-00
SIT GRADING AND LEVELING PLAN	NGP-000-SCW-15.01-2005-23
GRADING AND VERTICAL PLAN	NGP-000-SCW-15.01-2006-23
ROADS & PAVEMENT LAYOUT	NGP-000-SCW-15.01-2003-23
DETAIL DRAWING OF STORM WATER DRAIN DITCH	NGP-000-SCW-15.01-2010-23
STONE PITCHING PROTECTION LAYOUT	NGP-000-SCW-15.01-2007-23
STANDARD DRAWING OF ROAD SECTIONS	NGP-000-SCW-15.01-2001-23
DETAIL DRAWING OF STORM WATER DRAIN DITCH	NGP-000-SCW-15.01-2010-23
STANDARD DRAWING OF STONE PITCHING PROTECTION	NGP-000-SCW-15.01-2008-23

REV.	DESCRIPTION	PRPD	CHKD	REVD	APPD	DATE
00	Approved for Construction	XIAO	YANG	ZHANG	QIU	05/07/2016
C1	Issued for Approval	XIAO	YANG	ZHANG	QIU	08/06/2016
C	Issued for Approval	XIAO	YANG	ZHANG	QIU	20/05/2016
B	Issued for Review	XIAO	YANG	ZHANG	QIU	28/04/2016
A	Internal Discipline Check	XIAO	YANG	ZHANG	QIU	20/04/2016

CLIENT: OIL&GAS DEVELOPMENT COMPANY LTD.
 OGDCL HOUSE TOWER-B, FIRST FLOOR PHASE, BLUE AREA, JINNAH AVENUE ISLAMABAD PAKISTAN
 FAC: +92 051 2628033, PHONE: +92 051 2028699

CONSULTANT: Zishan Engineers (Pvt.) Ltd.
 An ISO 9001-2008 certified company
 477/ Block 6, PAFCHS, Karachi-Pakistan
 Tel: (92-01) 34393045-48, & 34310151-54, Fax: (92-01) 34533430 & 34510156
 E-Mail: contact@zishanengineers.com Website: www.zishanengineers.com


CONTRACTOR: HONG KONG HUIHUA GLOBAL TECHNOLOGY LIMITED
 PROJECT NO. NASHPA 1247

PROJECT TITLE: NASHPA GAS PROCESSING AND LPG RECOVERY PLANT PROC-FC-CB/NASHPA/PROJ-1247/2015
 DRAWING NO. NGP-000-SCW-15.01-2004-23


DRAWING TITLE: STORM WATER DRAINAGE PLAN
 REV. SCALE SHEET
 00 NTS 1 OF 4

TOTAL LAYOUT

PROPOSED AREA FOR FRONT END COMPRESSION

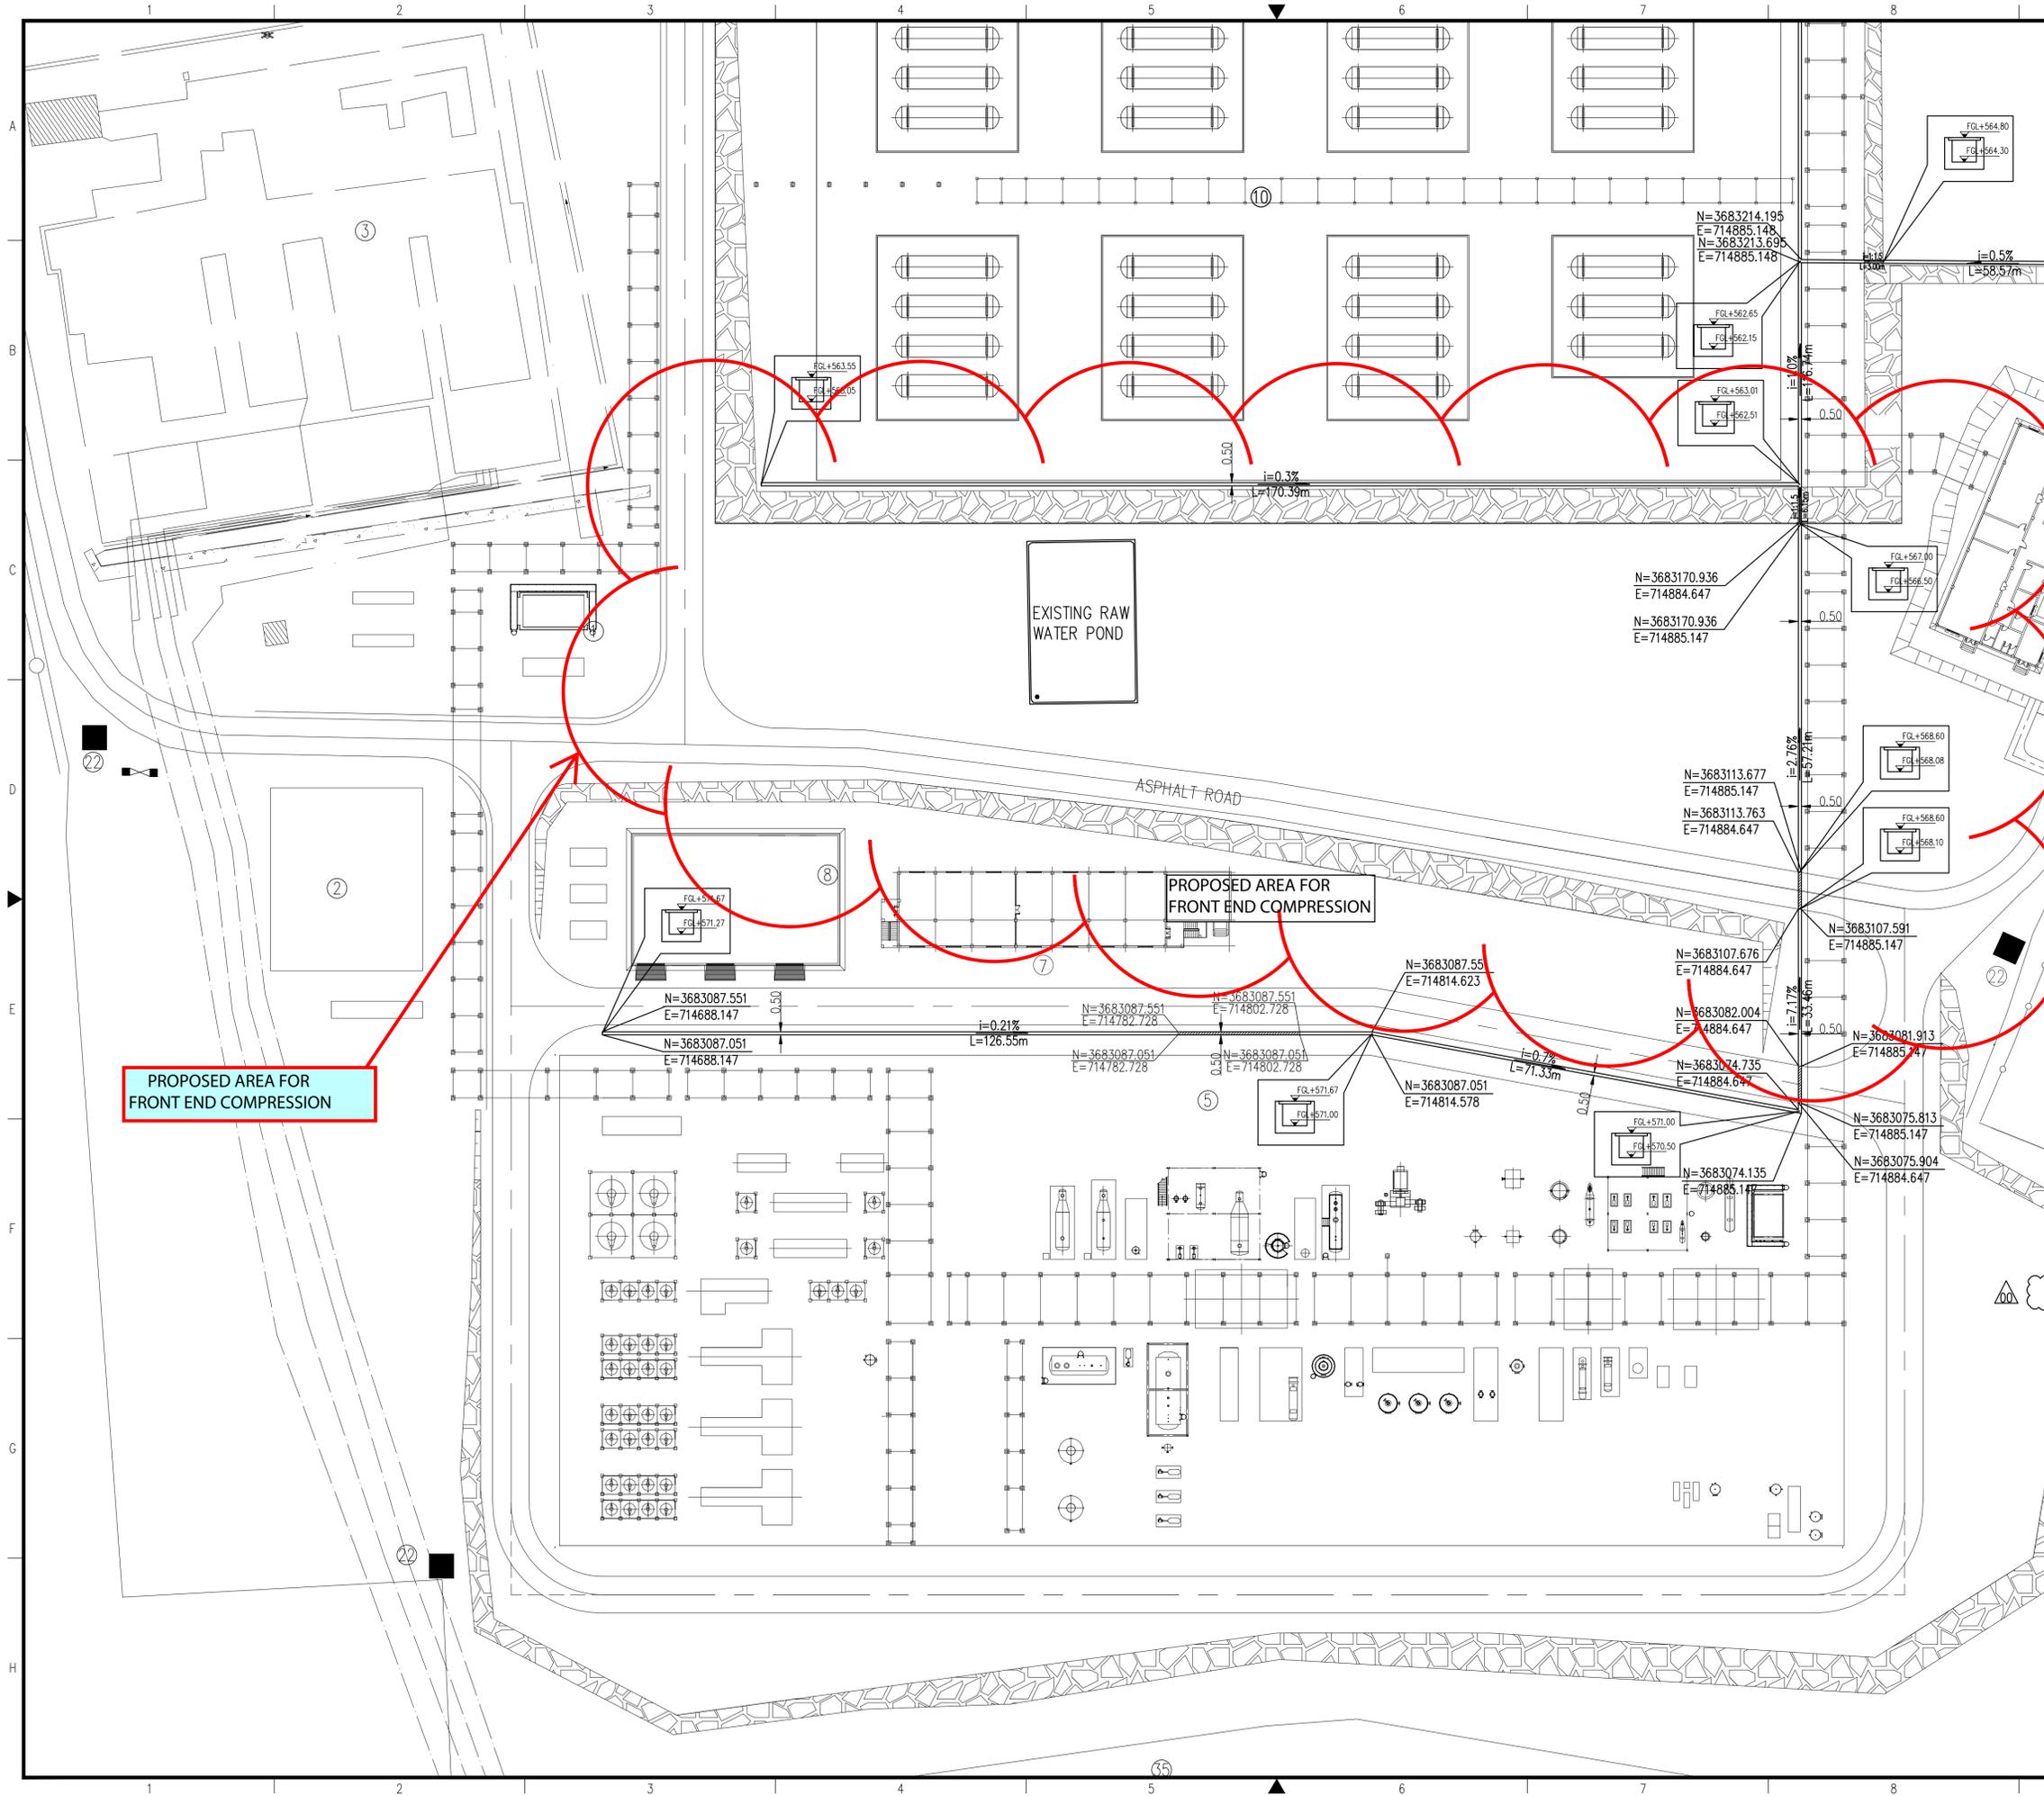

KEY PLAN

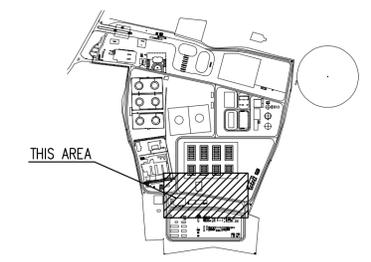

GENERAL NOTES

1. ALL DIMENSIONS, COORDINATES AND ELEVATIONS ARE IN METERS, UNLESS OTHERWISE SPECIFIED.
2. ALL COORDINATES ARE BASED ON UTM PROJECTION, GRID ZONE 42N, WGS 1984 DATUM. LEVELS TAKEN W.R.T BS-01. COORDINATES TAKEN WITH SATELLITE. PROJECTION SCALE FACTOR 1.000.
3. REFERENCE POINT IS BS-01. N=3683280.201m; E=714621.147m; ELEVATION=565.447m.
4. THIS DRAWING SHALL BE READ IN CONJUNCTION WITH THE FOLLOWING: NGP-000-SCW-15.01-2006-23 GRADING AND VERTICAL PLAN; NGP-000-SCW-15.01-2003-23 ROADS & PAVEMENT LAYOUT; NGP-000-SCW-15.01-2007 STONE PITCHING PROTECTION LAYOUT; NGP-000-SCW-15.01-2001-23 STANDARD DRAWING OF ROAD SECTIONS SHOULD BE CHECKED TOGETHER.
5. FOR DETAIL DRAWING OF STORM WATER DRAIN DITCH SHOWN IN REF. NO. NGP-000-SCW-15.01-2010-23.
6. LOCATION AND DETAIL DRAWING OF STORM WATER DRAIN DITCH ALONG WITH STONE PITCHING SHOWN IN REF. NO. NGP-000-SCW-15.01-2007-23.

**ISSUED FOR APPROVAL
(MODIFIED UNDER PROJECT #14-0193)**

LEGEND

- ▽ FGL+555.40 TOP ELEVATION
 - ▽ FGL+554.90 INVERT ELEVATION
 - ▨ DRAIN DITCH (ROAD CROSS TYPE)
 - DRAIN DITCH (WITH GALVANIZED STEEL GRATING COVER)
- SLOPE
 i=0.3%
 DIRECTION
 LENGTH
 L=170.39m

REFERENCE DOCUMENTS

TITLE	DOC No.
GENERAL PLOT PLAN	NGP-000-GEN-15.01-0001-00
SIT GRADING AND LEVELING PLAN	NGP-000-SCW-15.01-2005-23
GRADING AND VERTICAL PLAN	NGP-000-SCW-15.01-2006-23
ROADS & PAVEMENT LAYOUT	NGP-000-SCW-15.01-2003-23
DETAIL DRAWING OF STORM WATER DRAIN DITCH	NGP-000-SCW-15.01-2010-23
STONE PITCHING PROTECTION LAYOUT	NGP-000-SCW-15.01-2007-23
STANDARD DRAWING OF ROAD SECTIONS	NGP-000-SCW-15.01-2001-23
DETAIL DRAWING OF STORM WATER DRAIN DITCH	NGP-000-SCW-15.01-2010-23
STANDARD DRAWING OF STONE PITCHING PROTECTION	NGP-000-SCW-15.01-2008-23

REV.	DESCRIPTION	PRPD	CHKD	REVD	APPD	DATE
00	Approved for Construction	XIAO	YANG	ZHANG	QIU	05/07/2016
C1	Issued for Approval	XIAO	YANG	ZHANG	QIU	08/06/2016
C	Issued for Approval	XIAO	YANG	ZHANG	QIU	20/05/2016
B	Issued for Review	XIAO	YANG	ZHANG	QIU	28/04/2016
A	Internal Discipline Check	XIAO	YANG	ZHANG	QIU	20/04/2016

CLIENT:
OIL & GAS DEVELOPMENT COMPANY LTD.
 0001, HOUSE TOWER-B, FIRST FLOOR PHASE, BLUE AREA, JINNAH AVENUE ISLAMABAD PAKISTAN
 FAC: +92 051 2623033, PHONE: +92 051 2028889

CONSULTANT:
Zishan Engineers (Pvt.) Ltd.
 An ISO 9001-2008 certified company
 477F Block 6, PFCIS, Karachi-Pakistan
 Tel: (92-01) 34393045-48, & 34310151-54, Fax: (92-01) 34533430 & 34510156
 E-Mail: contact@zishanengineers.com Website: www.zishanengineers.com

CONTRACTOR:
HONG KONG HUIHUA GLOBAL TECHNOLOGY LIMITED

PROJECT TITLE: NASHPA GAS PROCESSING AND LPG RECOVERY PLANT PROC-FC-CB/NASHPA/PROJ-1247/2015

DRAWING TITLE: STORM WATER DRAINAGE PLAN



PROJECT NO.: NASHPA 1247
DRAWING NO.: NGP-000-SCW-15.01-2004-23
REV. SCALE SHEET: 00 1:500 2 OF 4

PROPOSED AREA FOR FRONT END COMPRESSION


PROPOSED AREA FOR FRONT END COMPRESSION

EXISTING RAW WATER POND

ASPHALT ROAD

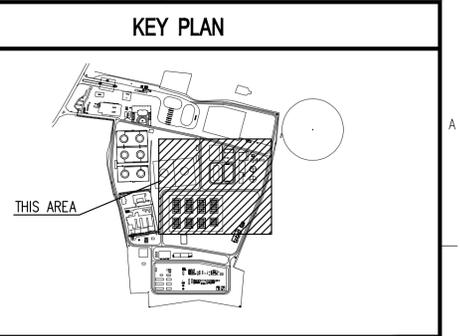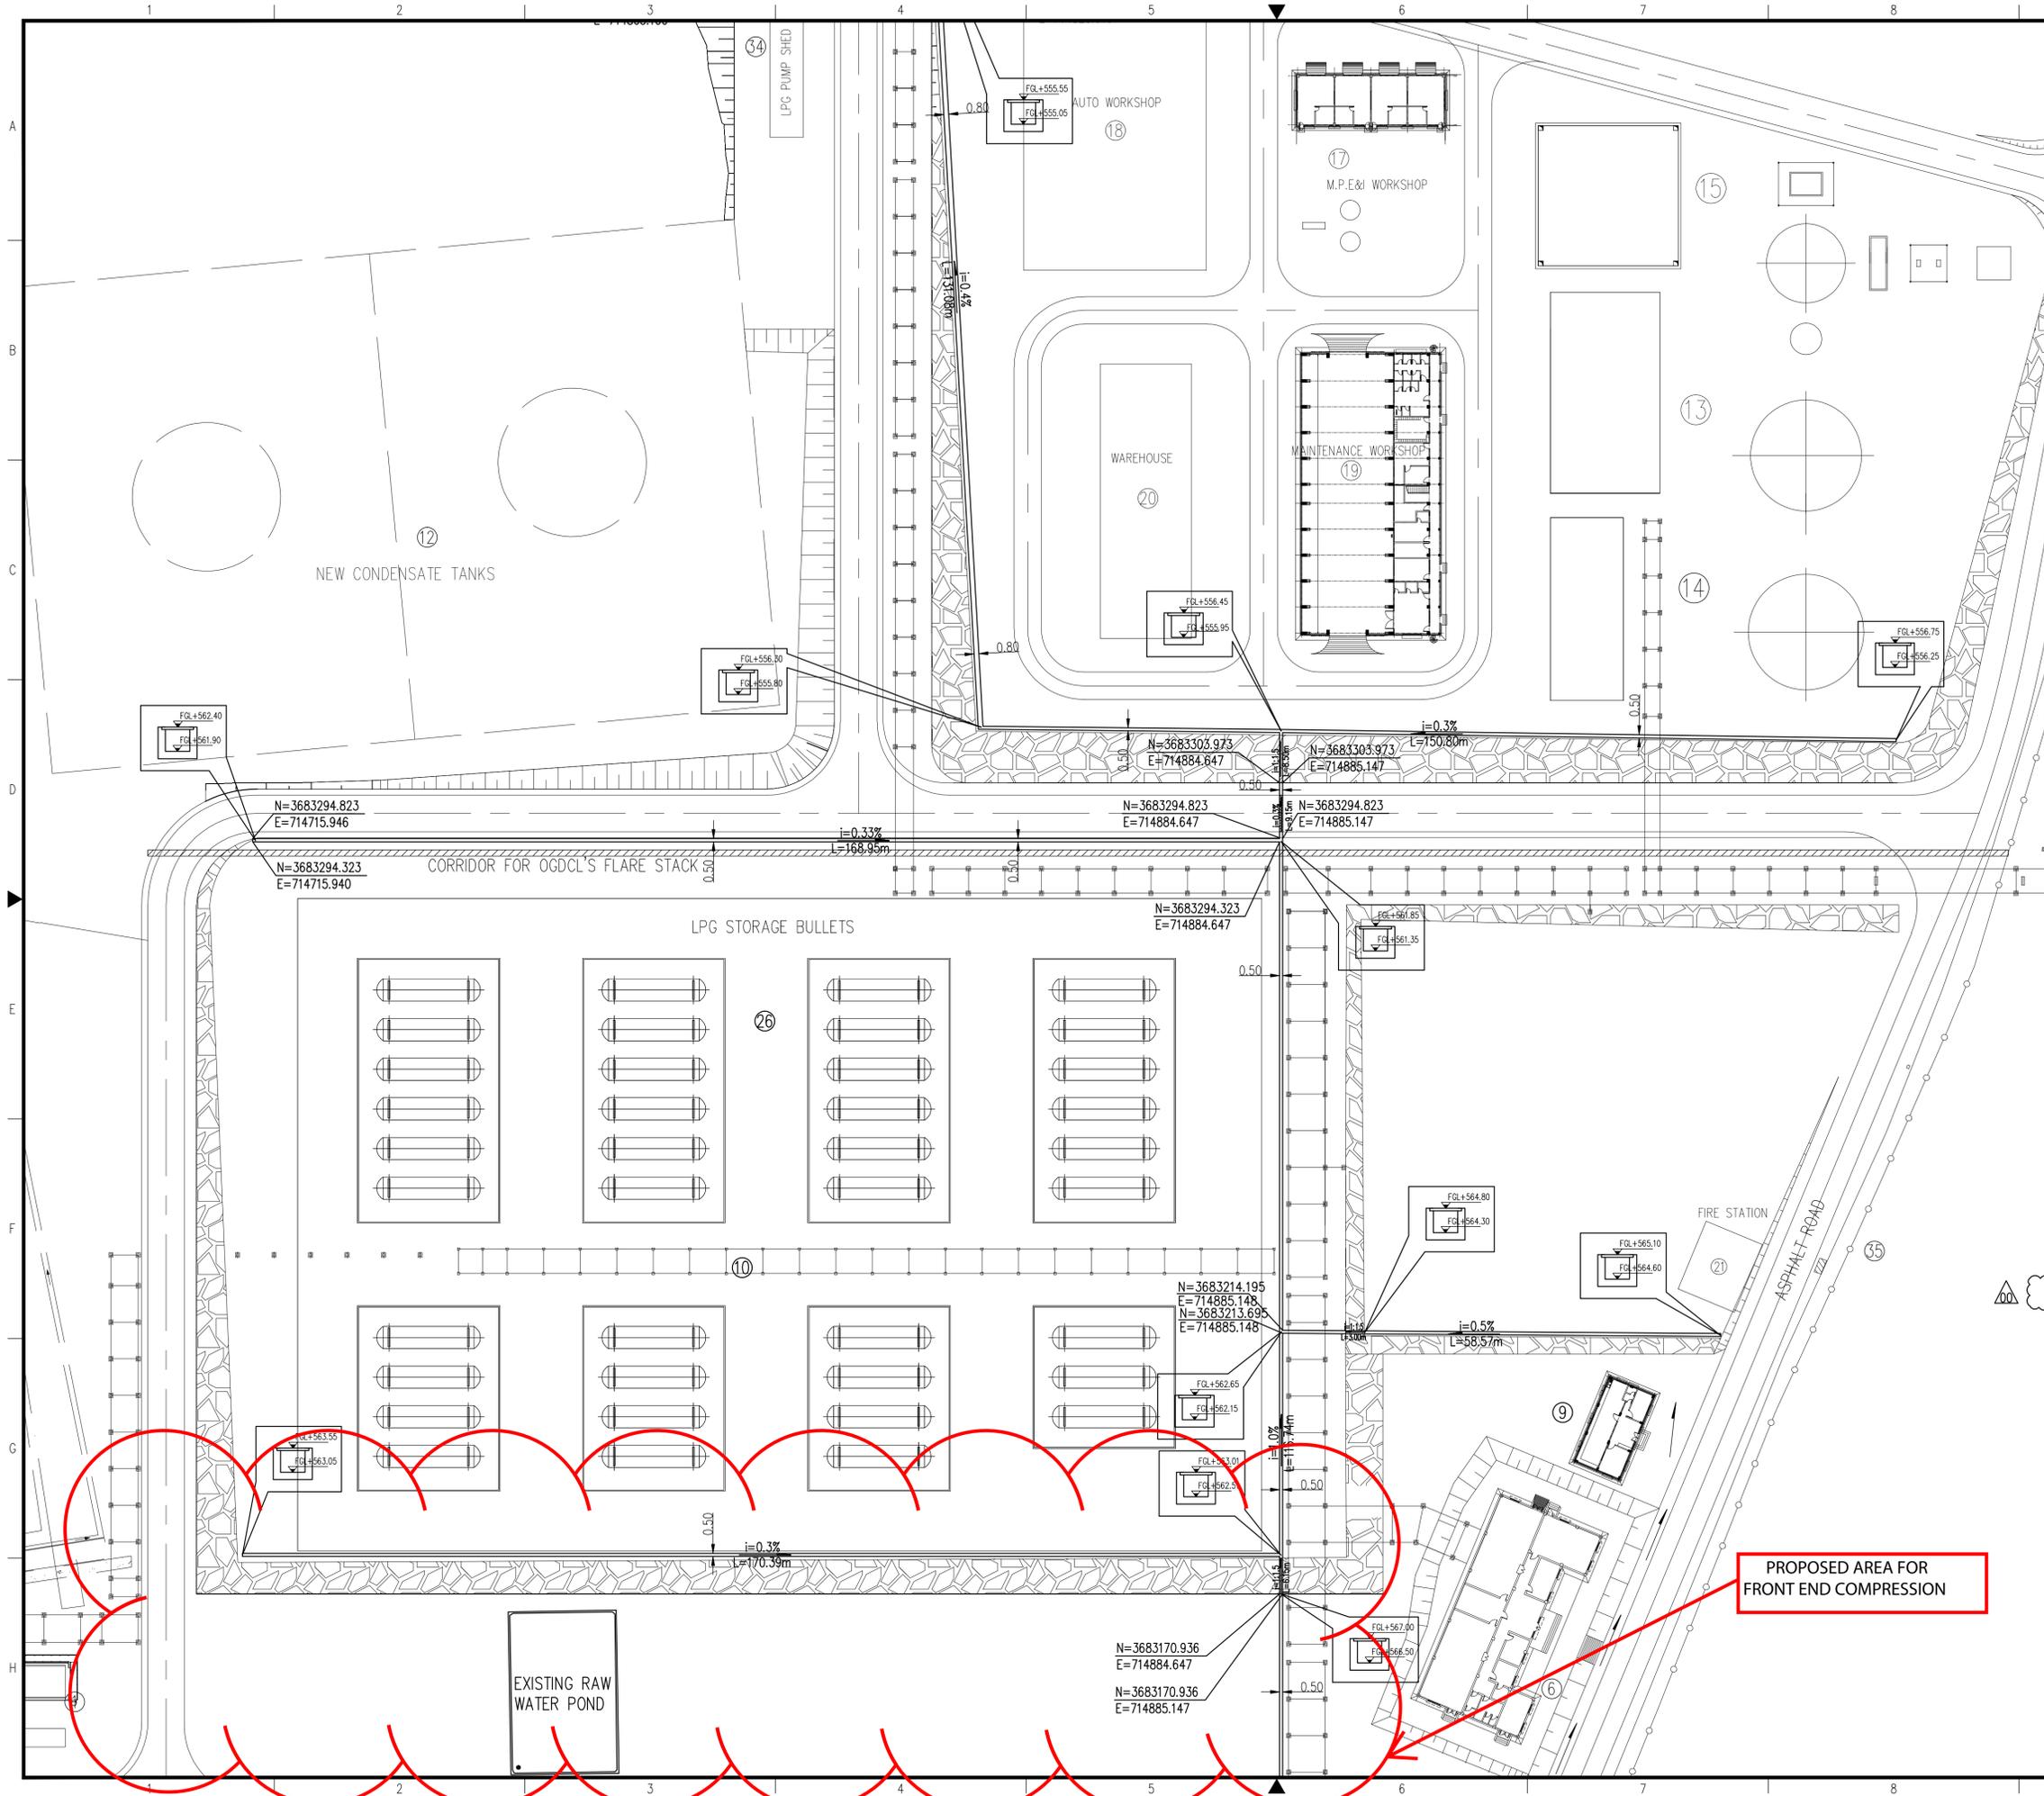

- ### GENERAL NOTES
- ALL DIMENSIONS, COORDINATES AND ELEVATIONS ARE IN METERS, UNLESS OTHERWISE SPECIFIED.
 - ALL COORDINATES ARE BASED ON UTM PROJECTION, GRID ZONE 42N, WGS 1984 DATUM. LEVELS TAKEN W.R.T BS-01. COORDINATES TAKEN WITH SATELLITE. PROJECTION SCALE FACTOR 1.000.
 - REFERENCE POINT IS BS-01. N=3683280.201m; E=714621.147m; ELEVATION=565.447m.
 - THIS DRAWING SHALL BE READ IN CONJUNCTION WITH THE FOLLOWING: NGP-000-SCW-15.01-2006-23 GRADING AND VERTICAL PLAN; NGP-000-SCW-15.01-2003-23 ROADS & PAVEMENT LAYOUT; NGP-000-SCW-15.01-2007-23 STONE PITCHING PROTECTION LAYOUT; NGP-000-SCW-15.01-2001-23 STANDARD DRAWING OF ROAD SECTIONS SHOULD BE CHECKED TOGETHER.
 - FOR DETAIL DRAWING OF STORM WATER DRAIN DITCH SHOWN IN REF. NO. NGP-000-SCW-15.01-2010-23.
 - LOCATION AND DETAIL DRAWING OF STORM WATER DRAIN DITCH ALONG WITH STONE PITCHING SHOWN IN REF. NO. NGP-000-SCW-15.01-2007-23.
- ISSUED FOR APPROVAL
(MODIFIED UNDER PROJECT #14-0193)**

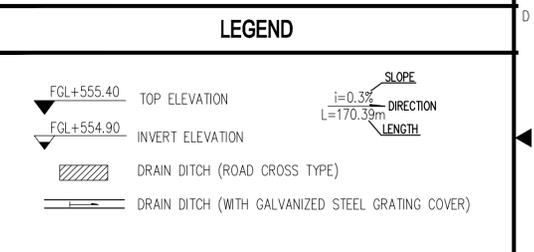

REFERENCE DOCUMENTS

TITLE	DOC No.
GENERAL PLOT PLAN	NGP-000-GEN-15.01-0001-00
SIT GRADING AND LEVELING PLAN	NGP-000-SCW-15.01-2005-23
GRADING AND VERTICAL PLAN	NGP-000-SCW-15.01-2006-23
ROADS & PAVEMENT LAYOUT	NGP-000-SCW-15.01-2003-23
DETAIL DRAWING OF STORM WATER DRAIN DITCH	NGP-000-SCW-15.01-2010-23
STONE PITCHING PROTECTION LAYOUT	NGP-000-SCW-15.01-2007-23
STANDARD DRAWING OF ROAD SECTIONS	NGP-000-SCW-15.01-2001-23
DETAIL DRAWING OF STORM WATER DRAIN DITCH	NGP-000-SCW-15.01-2010-23
STANDARD DRAWING OF STONE PITCHING PROTECTION	NGP-000-SCW-15.01-2008-23

REV.	DESCRIPTION	PRPD	CHKD	REVD	APPD	DATE
00	Approved for Construction	XIAO	YANG	ZHANG	QIU	05/07/2016
C1	Issued for Approval	XIAO	YANG	ZHANG	QIU	08/06/2016
C	Issued for Approval	XIAO	YANG	ZHANG	QIU	20/05/2016
B	Issued for Review	XIAO	YANG	ZHANG	QIU	28/04/2016
A	Internal Discipline Check	XIAO	YANG	ZHANG	QIU	20/04/2016

CLIENT:

OIL & GAS DEVELOPMENT COMPANY LTD.
 OGDCL HOUSE TOWER-B, FIRST FLOOR PHASE, BLUE AREA, JINNAH AVENUE ISLAMABAD PAKISTAN
 FAC: +92 051 2823033, PHONE: +92 051 2028989

CONSULTANT:

Zishan Engineers (Pvt.) Ltd.
 An ISO 9001-2008 certified company
 4775 Block 6, P.E.C.H.S, Karachi-Pakistan
 Tel: (92-01) 34393045-48, & 34310151-54, Fax: (92-01) 34533430 & 34510156
 E-Mail: contact@zishanengineers.com Website: www.zishanengineers.com


CONTRACTOR:

HONG KONG HUIHUA GLOBAL TECHNOLOGY LIMITED


PROJECT TITLE: NASHPA GAS PROCESSING AND LPG RECOVERY PLANT PROC-FC-CB/NASHPA/PROJ-1247/2015

DRAWING TITLE: STORM WATER DRAINAGE PLAN

PROJECT NO.: NASHPA 1247
DRAWING NO.: NGP-000-SCW-15.01-2004-23
REV. SCALE SHEET: 00 1:500 3 OF 4

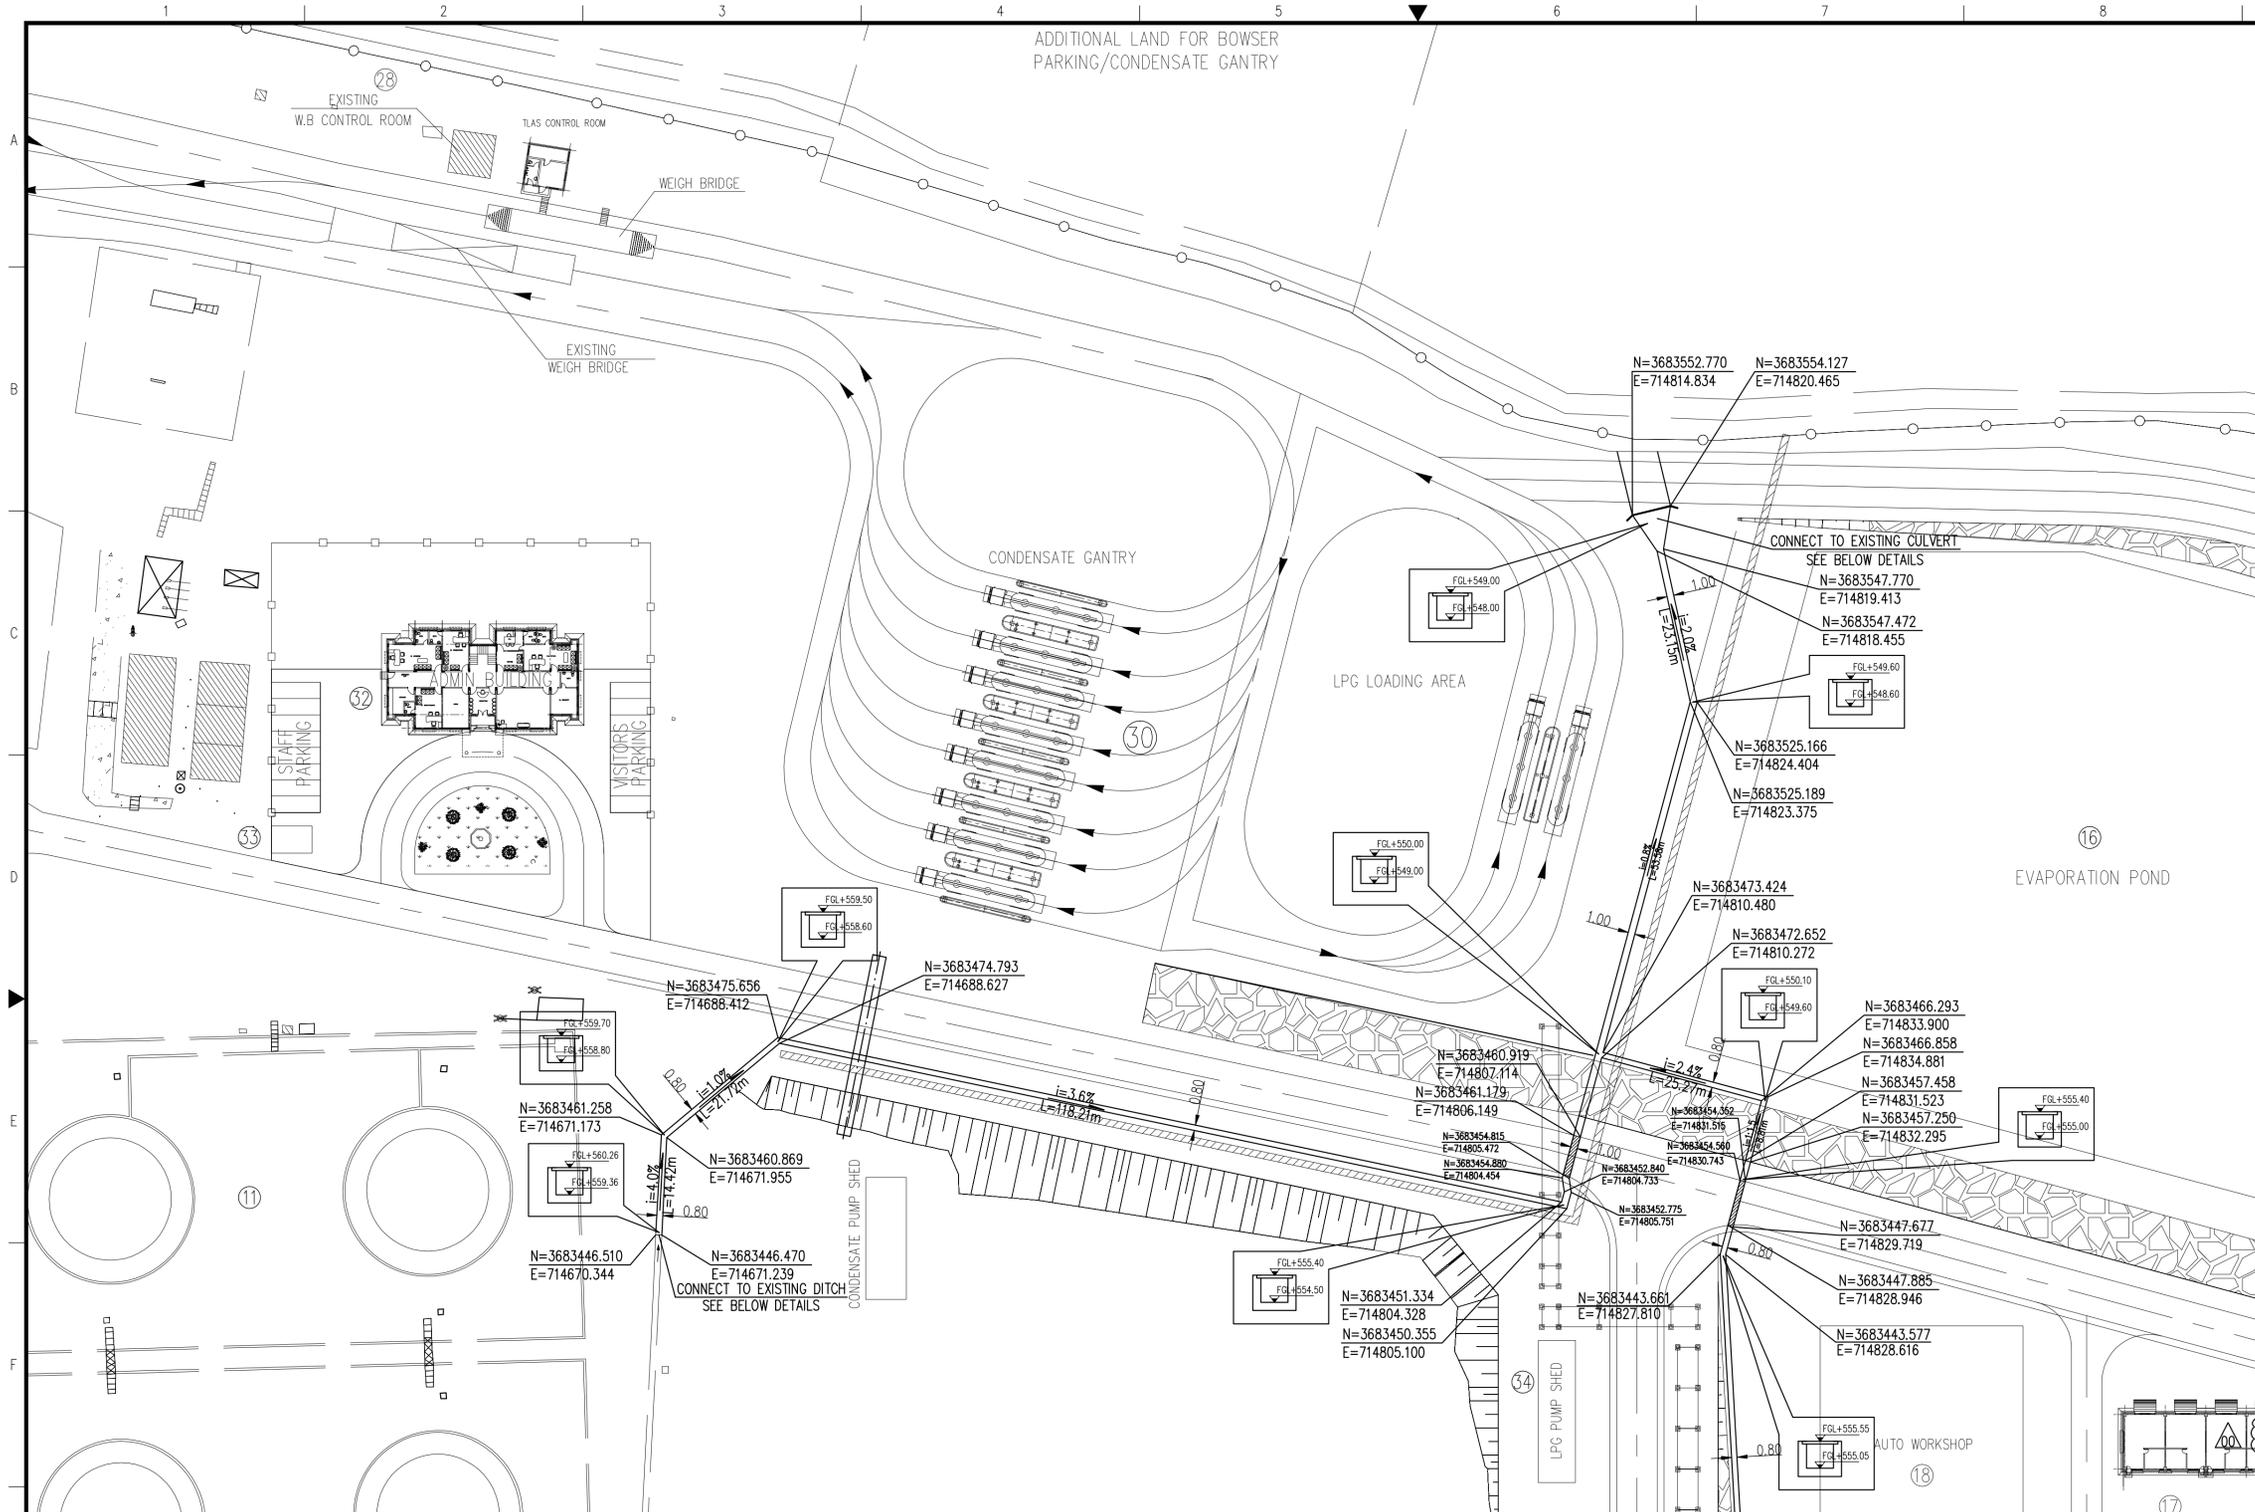


KEY PLAN

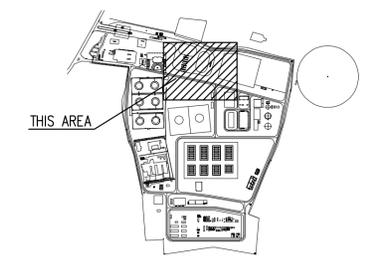

GENERAL NOTES

1. ALL DIMENSIONS, COORDINATES AND ELEVATIONS ARE IN METERS, UNLESS OTHERWISE SPECIFIED.
2. ALL COORDINATES ARE BASED ON UTM PROJECTION, GRID ZONE 42N, WGS 1984 DATUM. LEVELS TAKEN W.R.T BS-01. COORDINATES TAKEN WITH SATELLITE. PROJECTION SCALE FACTOR 1.000.
3. REFERENCE POINT IS BS-01. N=3683280.201m; E=714621.147m; ELEVATION=565.447m.
4. THIS DRAWING SHALL BE READ IN CONJUNCTION WITH THE FOLLOWING: NGP-000-SCW-15.01-2006-23 GRADING AND VERTICAL PLAN; NGP-000-SCW-15.01-2003-23 ROADS & PAVEMENT LAYOUT; NGP-000-SCW-15.01-2007 STONE PITCHING PROTECTION LAYOUT; NGP-000-SCW-15.01-2001-23 STANDARD DRAWING OF ROAD SECTIONS SHOULD BE CHECKED TOGETHER.
5. FOR DETAIL DRAWING OF STORM WATER DRAIN DITCH SHOWN IN REF. NO. NGP-000-SCW-15.01-2010-23.
6. LOCATION AND DETAIL DRAWING OF STORM WATER DRAIN DITCH ALONG WITH STONE PITCHING SHOWN IN REF. NO. NGP-000-SCW-15.01-2007-23.
7. THE BOTTOM LEVEL OF NEW DITCH SHOULD SUIT THE EXISTING CULVERT INVERT LEVEL.

LEGEND

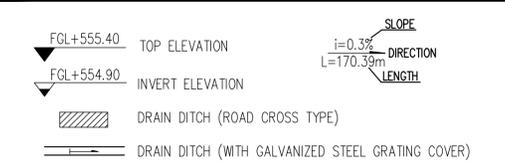

REFERENCE DOCUMENTS

TITLE	DOC No.
GENERAL PLOT PLAN	NGP-000-GEN-15.01-0001-00
SIT GRADING AND LEVELING PLAN	NGP-000-SCW-15.01-2005-23
GRADING AND VERTICAL PLAN	NGP-000-SCW-15.01-2006-23
ROADS & PAVEMENT LAYOUT	NGP-000-SCW-15.01-2003-23
DETAIL DRAWING OF STORM WATER DRAIN DITCH	NGP-000-SCW-15.01-2010-23
STONE PITCHING PROTECTION LAYOUT	NGP-000-SCW-15.01-2007-23
STANDARD DRAWING OF ROAD SECTIONS	NGP-000-SCW-15.01-2001-23
DETAIL DRAWING OF STORM WATER DRAIN DITCH	NGP-000-SCW-15.01-2010-23
STANDARD DRAWING OF STONE PITCHING PROTECTION	NGP-000-SCW-15.01-2008-23

REV.	DESCRIPTION	PRPD	CHKD	REVD	APPD	DATE
00	Approved for Construction	XIAO.	YANG.	ZHANG.	QIU.	05/07/2016
C1	Issued for Approval	XIAO.	YANG.	ZHANG.	QIU.	08/06/2016
C	Issued for Approval	XIAO.	YANG.	ZHANG.	QIU.	20/05/2016
B	Issued for Review	XIAO.	YANG.	ZHANG.	QIU.	28/04/2016
A	Internal Discipline Check	XIAO.	YANG.	ZHANG.	QIU.	20/04/2016

CLIENT: OIL&GAS DEVELOPMENT COMPANY LTD.
OOCL HOUSE TOWER B, FIRST FLOOR PHOENIX BLUE AREA, JINNAH AVENUE ISLAMABAD PAKISTAN
 FAC: +92 051 2623033, PHONE: +92 051 2026989

CONSULTANT: Zishan Engineers (Pvt.) Ltd.
An ISO 9001-2008 certified company
 477/ Block 6, PESCO, Karachi-Pakistan
 Tel: (92-01) 34393045-48, & 34310151-54, Fax: (92-01) 34533430 & 34510158
 E-Mail: contact@zishanengineers.com Website: www.zishanengineers.com

CONTRACTOR: HONG KONG HUIHUA GLOBAL TECHNOLOGY LIMITED
HBP

PROJECT TITLE: NASHPA GAS PROCESSING AND LPG RECOVERY PLANT PROC-FC-CB/NASHPA/PROJ-1247/2015
NGP-000-SCW-15.01-2004-23

DRAWING TITLE: STORM WATER DRAINAGE PLAN
REV. SCALE SHEET
 00 1:500 4 OF 4

